

SHOP DRAWING AND SUBMITTAL TRANSMITTAL

Clovis PLC and Health Center

1716

1

DESCRIPTION: Modular Casework - Shop Drawings

SUBMITTAL NO.:

36.2

SPEC SECTION:

064123

2

ARCHITECT:

Darden Architects

6790 N. West Ave
Fresno, California 93711

PROJECT:

Clovis PLC and Health Center
362 N. Clovis Ave.
Clovis CA 93612

CONTRACTOR-Bid Package PLC-02 - C

SUPPLIER:

Emerzian

Emerzian
2555 N Argyle Ave
Fresno, CA 93727

Substitution: Yes: DSA Approval Req'd

DATE RECEIVED: 10/26/2017 NO. RECEIVED: 1 DATE RETURNED: 10/27/2017

3

Contractor Remarks:

Other Required Information:

CPM Activity / Submittal Task No.:

~~WARRANTY:~~ O and M MANUALS

Early Start (ES) Date:

Late Finish (LF) Date:

Early Finish (EF) Date:

Scheduled Float Time:

0

4

DESIGN CONSULTANT'S REVIEW:

TRANSMITTED BY ARCHITECT TO: Darden

DATE RETURNED: 10/27/2017

DATE SENT: 10/26/2017

NO. SENT: 1

Consultants Remarks:

ACTION:

- NO EXCEPTION TAKEN RELATIVE TO DESIGN
- NO EXCEPTION TAKEN WITH MODIFICATION NOTED
- AMEND AS NOTED AND RESUBMIT
- REJECTED AND RESUBMIT
- SEE ATTACHED LETTER

5

ARCHITECT'S REVIEW:

Architects Remarks:

ACTION:

- NO EXCEPTION TAKEN RELATIVE TO DESIGN
- NO EXCEPTION TAKEN WITH MODIFICATION NOTED
- AMEND AS NOTED AND RESUBMIT
- REJECTED AND RESUBMIT

Approved Substitution

6

COPIES TO:

DATE RETURNED: 10/27/2017

Contractor: 1

Owner: 1

Inspector: 0


File: 1

Other: 0

SHOP DRAWING AND PRODUCT SUBMITTAL JOURNAL



ARCHITECTURE • PLANNING • INTERIORS
6790 North West Avenue • Fresno, California 93711
www.dardenarchitects.com

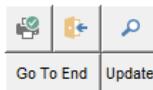

NET - NO EXCEPTION TAKEN RELATIVE TO DESIGN
NET w/MN - NO EXCEPTION TAKEN WITH MODIFICATION NOTED
AR - AMEND AS NOTED AND RESUBMIT
Rej'd - REJECTED AND RESUBMIT
Status - O = Outstanding , Blank = Returned to Contractor

C-Contractor
O-Owner
I-Inspector
F-file
OT-Other

Project: 1716 Clovis PLC and Health Center

Sunday, April 11, 2021



| SD No. | No. | Spec. Section | Subit Appv. | DSA Req'd | DSA Appv. | Description | SubContr Supplier | Date Rec'd | Respond Before | Response Date | Status | Check Status | | | | REFERRED TO | | | | REVIEW | | | | COPIES TO | | | | SD | Hyper link |
|--------|-----|---------------|-------------|-----------|-----------|--|----------------------------|------------|----------------|---------------|--------|--------------|------|------------|-------|-------------|---------|----|-------|--------|---|---|---|-----------|------|------------------------|------------------------|----|------------|
| | | | | | | | | | | | | To | Date | No | Ref'd | NET | NETw/MN | AR | Rej'd | C | O | I | F | OT | | | | | |
| 01 | 1 | 230001 | ✓✓ | N | ▼ | Carrier Packaged Air Conditioning Unit - Substitution Request | Nolte | 8/31/2017 | 9/14/2017 | 9/6/2017 | ▼ | LNCA | ▼ | 8/31/2017 | 1 | 9/5/2017 | □ | ✓ | □ | □ | 1 | 1 | 0 | 0 | 01 | 1-Data | | | |
| 02 | 1 | 230001 | ✓✓ | N | ▼ | Mitsubishi Split System Air Conditioning Unit - Substitution Request | Nolte | 8/31/2017 | 9/14/2017 | 9/5/2017 | ▼ | LNCA | ▼ | 8/31/2017 | 1 | 9/5/2017 | ✓ | □ | □ | □ | 1 | 1 | 0 | 0 | 02 | 1-Data | | | |
| 03 | 1 | 230000 | □ | N | ▼ | HVAC | Nolte Sheet Metal Inc | 9/6/2017 | 9/20/2017 | 9/15/2017 | ▼ | LNCA | ▼ | 9/6/2017 | 1 | 9/15/2017 | □ | ✓ | ✓ | □ | 1 | 1 | 1 | 1 | 03 | 1-Data | | | |
| 04 | 1 | 100500 | □ | N | ▼ | Operable Partitions - Product Data & Cut Sheets | Divcon, Inc. | 9/8/2017 | 9/22/2017 | 9/18/2017 | ▼ | Darden | ▼ | 9/8/2017 | 1 | 9/18/2017 | ✓ | □ | ✓ | □ | 1 | 1 | 0 | 0 | 04 | 1-Data | | | |
| 04.1 | 1 | 100500 | □ | N | ▼ | Operable Partitions | Western Building Materials | 9/26/2017 | 10/10/2017 | 10/3/2017 | ▼ | Darden | ▼ | 9/26/2017 | 0 | 10/3/2017 | □ | ✓ | □ | □ | 1 | 1 | 1 | 1 | 04.1 | 1-Data | | | |
| 05 | 1 | 033510 | □ | N | ▼ | Polished Concrete - Product Data | Divcon, Inc / Precast | 9/8/2017 | 9/22/2017 | 9/15/2017 | ▼ | Darden | ▼ | 9/8/2017 | 1 | 9/13/2017 | □ | □ | ✓ | □ | 1 | 0 | 0 | 0 | 05 | 1-Data | | | |
| 06 | 1 | 230923 | □ | N | ▼ | DDC/EMS - Controls Cut Sheets & Product Data | Alcom Aire | 9/8/2017 | 9/22/2017 | 10/2/2017 | ▼ | LNCA | ▼ | 9/9/2017 | 1 | 10/2/2017 | □ | ✓ | □ | □ | 1 | 1 | 0 | 1 | 06 | 1-Data | | | |
| 06.1 | | 230923 | □ | N | ▼ | DDC/EMS Controls | Alcom Aire | 10/16/2017 | | 10/19/2017 | ▼ | LNCA | ▼ | 10/16/2017 | 1 | 10/19/2017 | ✓ | □ | □ | □ | 1 | 1 | 1 | 1 | 06.1 | 1-Data | | | |
| 06.2 | | 230923 | □ | N | ▼ | DDC/EMS Controls | | | | 0 | ▼ | ▼ | | 0 | | | □ | □ | □ | □ | 0 | 0 | 0 | 0 | 06.2 | | | | |
| 07 | 1 | 084100 | □ | N | ▼ | Storefronts - Product Data & Shop Drawings | San Joaquin Glass | 9/13/2017 | 9/27/2017 | 9/19/2017 | ▼ | Darden | ▼ | 9/13/2017 | 1 | 9/19/2017 | □ | ✓ | □ | □ | 1 | 1 | 0 | 0 | 07 | 1-Data | | | |
| 08 | 1 | 088000 | □ | N | ▼ | GLASS - PD & Shop Drawings | San Joaquin Glass | 9/13/2017 | 9/27/2017 | | ▼ | Darden | ▼ | 9/13/2017 | 1 | 9/22/2017 | ✓ | □ | □ | □ | 1 | 1 | 0 | 1 | 08 | 1-Data | | | |
| 09 | 1 | 079200 | □ | N | ▼ | Sealants - Glass / Storefront | San Joaquin Glass | 9/13/2017 | 9/27/2017 | 9/20/2017 | ▼ | Darden | ▼ | 9/13/2017 | 1 | 9/20/2017 | □ | ✓ | □ | □ | 0 | 0 | 0 | 0 | 09 | 1-Data | | | |
| 10 | 1 | 077200 | □ | N | ▼ | Roof Accessories | Nations Roofing | 9/13/2017 | 9/27/2017 | 9/20/2017 | ▼ | Darden | ▼ | 9/13/2017 | 1 | 9/20/2017 | ✓ | □ | □ | □ | 1 | 0 | 0 | 0 | 10 | 1-Data | | | |
| 11 | 1 | 092216 | □ | N | ▼ | Metal Framing - Product Data & Test Reports | Divcon Inc | 9/13/2017 | 9/27/2017 | 9/19/2017 | ▼ | BRA | ▼ | 9/13/2017 | 1 | 9/19/2017 | ✓ | □ | □ | □ | 1 | 1 | 1 | 1 | 0 | 11 | 1-Data | | |

SUBMITTAL



Job:

Spec Section No:

Spec Section Title:

Submittal Title:

Submittal No:

Revision No:

Sent Date:

Contractor:

Contractor's Stamp

Mark Wilson Construction has reviewed
this submittal for conformance with the
requirements of the contract documents
and hereby forward for approval.

Date: 10/26/2017
By: Indi Randol

Architect:

Architect's Stamp

SUBMITTAL REVIEW

- | |
|--|
| No Exception taken relative to Design. |
| <input checked="" type="checkbox"/> No Exception taken with Modifications Noted. |
| Amend as Noted and Resubmit |
| Rejected and Resubmit. |

Dimensions were not checked. Review of submittal
does not relieve contractor from requirements of
contract documents unless specifically documented in
writing by Architect.

ARCHITECTURE • PLANNING • INTERIORS
6790 North West Avenue • Fresno, California 93711
www.dardenarchitects.com

By: Mike Fennacy Date: 10/27/2017

Engineer:

Engineer's Stamp



Letter of Transmittal

Wednesday, October 25, 2017

To: Clovis Unified School District

From: Aharon Dertsakyan
Phone (559) 292-2448
Fax (559) 292-3710
aharon@emerzianwoodworking.com

Attn: Randol, Indi

Transmittal #: 7

GC Job ID:

Estimate:

Job: 17052 - Clovis USD Professional Learning C

Description: Revised Shop Drawings

We are sending you:

Enclosed Under Separate Cover Via: Email

The following items:

RFI Drawings Plans Copy of Letter Change Order LEED
 Bid Proposal Specifications Prints Contract Samples
 Other _____

| Copies | Date | Spec/Code | Description |
|--------|----------|-----------|-----------------------------------|
| 1 | 10/25/17 | 064123 | Drawings revised per submittal 36 |

The above items are transmitted to you:

For Approval Approved As Submitted
 For Your Use Approved As Noted
 As Requested Returned For Corrections
 For Review and Comment On Loan - Please Return Prints
 Other _____

Resubmit ___Copies For Approval
 Submit ___Copies For Distribution
 Return ___Sets of Corrected Prints
 For Bids Due _____


Remarks:

For approval or red marked corrections.

Copy To: _____

Signed: _____

SUBMITTAL SET

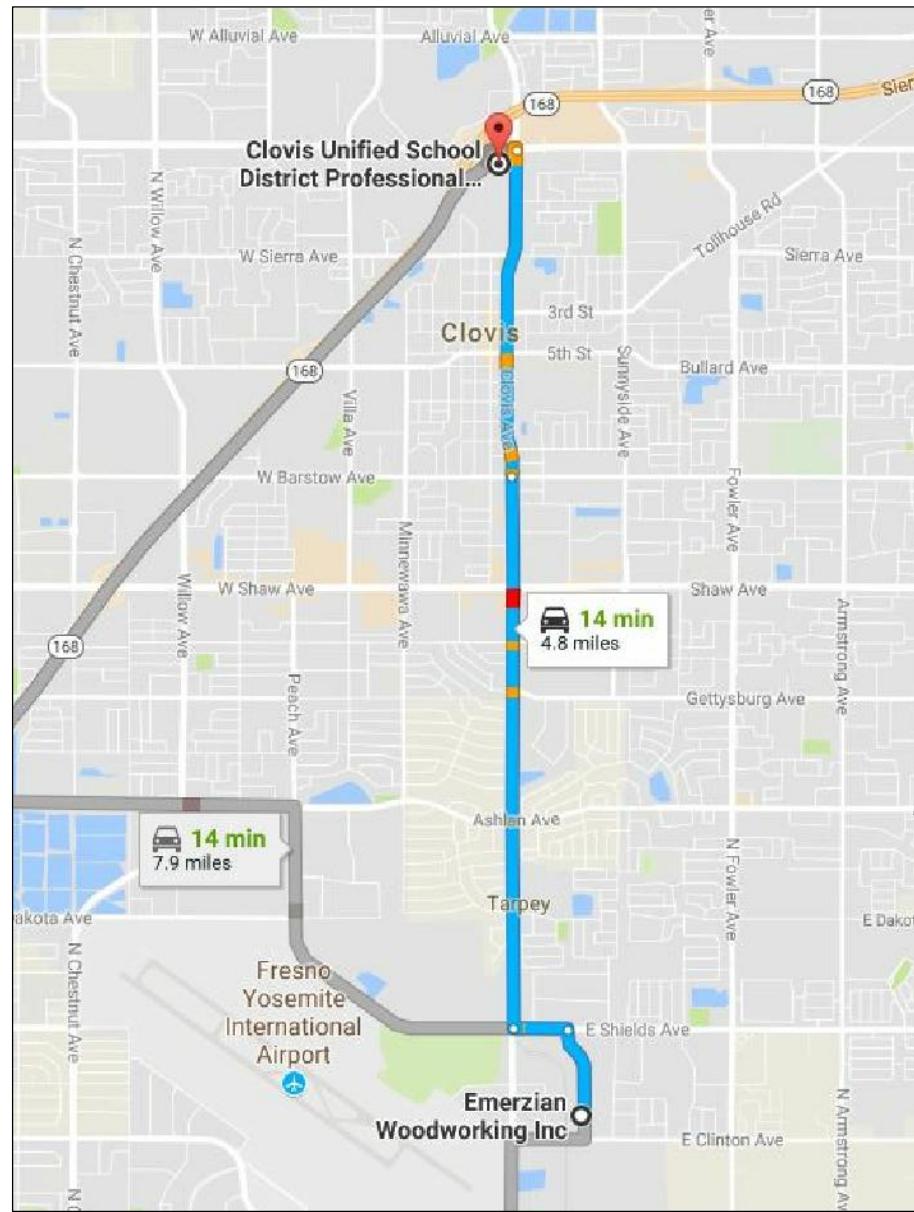

CLOVIS UNIFIED SCHOOL DISTRICT PROFESSIONAL LEARNING CENTER

362 N CLOVIS AVE., CLOVIS, CA 93612
JOB# 17052

CONTRACTOR / CLIENT:

CLOVIS UNIFIED SCHOOL DISTRICT
1450 HERNDON AVENUE
CLOVIS, CA 93611

PHONE: (559) 327-9000

ARCHITECT:

DARDEN ARCHITECTS INC.
6790 N. WEST AVE
FRESNO, CA 93711

PHONE: (559) 448-8051
FAX: (559) 446-1765

SHEET INDEX

| | |
|--------------------|--------|
| COVER SHEET | 1 |
| SPECIFICATIONS | 2, 2.1 |
| COLORS, HARDWARE | 3 |
| REFERENCE PLAN | 4 |
| PLANS & ELEVATIONS | 5 |
| SECTIONS | S1 |
| ANCHORAGE DETAILS | A1 |
| DETAILS | D1 |
| LOCK DETAILS | L1 |

ABBREVIATIONS

| | |
|--------|------------------|
| ADJ | ADJUSTABLE |
| BO | BY OTHERS |
| CLR | CLEAR |
| FE | FINISHED END |
| FV | FIELD VERIFY |
| GR | GRANITE |
| PL | PLASTIC LAMINATE |
| SS | SOLID SURFACE |
| ST.STL | STAINLESS STEEL |
| TYP | TYPICAL |

TYPICAL SYMBOLS

DETAIL CALL-OUT



ELEVATION MARKER



DETAIL NUMBER
SHEET NUMBER

CONTRACTOR/CLIENT APPROVAL STAMP OR SIGNATURE

ARCHITECT APPROVAL STAMP OR SIGNATURE

ALL DRAWINGS AND WRITTEN MATERIAL APPEARING HEREIN CONSTITUTE ORIGINAL AND UNPUBLISHED WORK OF EMERZIAN WOODWORKING AND MAY NOT BE DUPLICATED,
USED OR DISCLOSED FOR PURPOSES OTHER THAN THE CONSTRUCTION OF THIS PROJECT WITHOUT WRITTEN CONSENT OF EMERZIAN WOODWORKING. SHOP DRAWINGS ARE
FOR THE INTENDED PURPOSES OF EMERZIAN WOODWORKING AND EMERZIAN WOODWORKING WILL NOT BE HELD RESPONSIBLE FOR OTHER TRADES LAYOUT FOR PLUMBING AND ELECTRICAL.

IF SIZE OF SHEET IS NOT 11 X 17, SCALE ACCORDINGLY.

| | | | | |
|---|--|---|----------------------------------|-----------------------------------|
| <p>EMERZIAN WOODWORKING</p> <p>2555 N. Argyle, Fresno, California 93727 (559) 292-2448 - FAX (559) 292-3710</p> | PROJECT NAME: CUSD PROFESSIONAL LEARNING CENTER | CONTRACTOR/CLIENT NAME: CLOVIS UNIFIED SCHOOL DISTRICT | SCALE: | DATE: |
| | | | PROJECT NUMBER: 17052 | REVISED: 10/25/17 |
| LOCATION: CLOVIS, CA | ADDRESS: 1450 HERNDON AVE., CLOVIS, CA 93611 | PHONE: (559) 327-9000 | FILE NAME: F:\MV7\EF\FD\17052 | DRAWN BY: AD REVISED BY: AD |
| SUPER PHONE: | FAX: | | DRAWING NUMBER: 1 | SUBMITTAL SET |

TYP. SPECIFICATIONS

CASEWORK

A. CASEWORK CONSTRUCTION

1. GRADE W.I. PREMIUM
2. CONSTRUCTION TYPE W.I. TYPE A FLUSH OVERLAY
3. CONSTRUCTION STYLE W.I. STYLE I OVERLAY (NOT INSET)
4. CASE JOINERY W.I. APPROVED METHOD
5. DOOR/DRAWER FRONTS FLUSH OVERLAY WITH SQUARE EDGE
6. DRAWER BOX CONSTRUCTION CONFIRMAT SCREWS
7. SHELF SUPPORT SYSTEM KV SHELF STANDARDS AND SUPPORTS

B. CASEWORK MATERIALS





1. CASES
 - A. EXPOSED SURFACES PLASTIC LAMINATE
 - B. EDGE BANDING PVC TO MATCH PLASTIC LAMINATE
 - C. EDGE BANDING THICKNESS 0.5mm
 - D. EXPOSED INTERIOR PLASTIC LAMINATE
 - E. SEMI-EXPOSED WHITE CABINET LINER
 - F. CORE $\frac{3}{4}$ " 45 lb PARTICLE BOARD, $\frac{1}{2}$ " PARTICLE BOARD BACK
 - G. TOE-KICK $\frac{3}{4}$ " PLYWOOD
 - H. FLOOR ANCHORAGE "SIMPSON" PDPL-300x3" L
 - I. FLOOR PLATE $2\frac{1}{2}$ "x2"x2" L-CLIP
2. DOOR/DRAWER FRONTS
 - A. OUTSIDE FACE PLASTIC LAMINATE
 - B. EDGE BANDING PVC TO MATCH PLASTIC LAMINATE
 - C. EDGE BANDING THICKNESS 3mm
 - D. INSIDE FACE WHITE CABINET LINER
 - E. CORE $\frac{3}{4}$ " 45 lb PARTICLE BOARD
3. DRAWER BOX
 - A. SIDES AND BACKS $\frac{1}{2}$ " THICK VENEER-CORE HARDWOOD PLYWOOD
 - i. JOINTS CONFIRMAT SCREWS
 - B. EDGE BANDING PVC WHITE
 - C. EDGE BANDING THICKNESS 0.3mm
 - D. BOTTOM $\frac{1}{2}$ " THICK VENEER-CORE HARDWOOD PLYWOOD GLUED AND DADOED INTO FRONT, BACK, & SIDES OF DRAWERS
 - E. SECURITY PANELS $\frac{3}{4}$ " HARDWOOD PLYWOOD
4. SHELVES
 - A. EXPOSED INTERIOR PLASTIC LAMINATE
 - B. SEMI EXPOSED WHITE MELAMINE
 - C. EDGE BANDING PVC WHITE
 - D. EDGE BANDING THICKNESS 0.3mm
 - E. CORE $\frac{3}{4}$ " VENEER CORE HARDWOOD PLYWOOD UNDER 25" WIDE
1" VENEER CORE HARDWOOD PLYWOOD OVER 25" WIDE

GENERAL NOTES

1. CABINETS LESS THAN 25" IN WIDTH TO HAVE $\frac{3}{4}$ " THICK LPDL (MELAMINE) SHELVES.
2. CABINETS MORE THAN 25" IN WIDTH TO HAVE 1" THICK LPDL (MELAMINE) SHELVES.
3. ALL WALL TO WALL DIMENSIONS WILL BE VERIFIED IN FIELD BEFORE FABRICATION.
4. ALL PLUMBING CUT-OUTS TO BE MADE IN FIELD AND ALL CUT EDGES SEALED.

TYP. CASEWORK ILLUSTRATION

- | | |
|---|------------------|
| PL | EXPOSED EXTERIOR |
| PL | EXPOSED INTERIOR |
| WCL | SEMI-EXPOSED |
|  | CONCEALED |

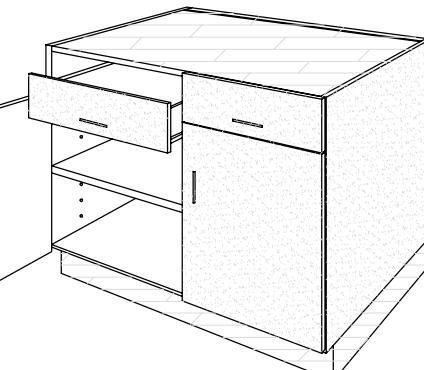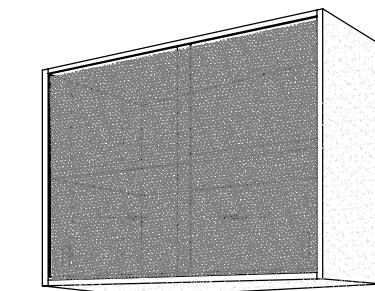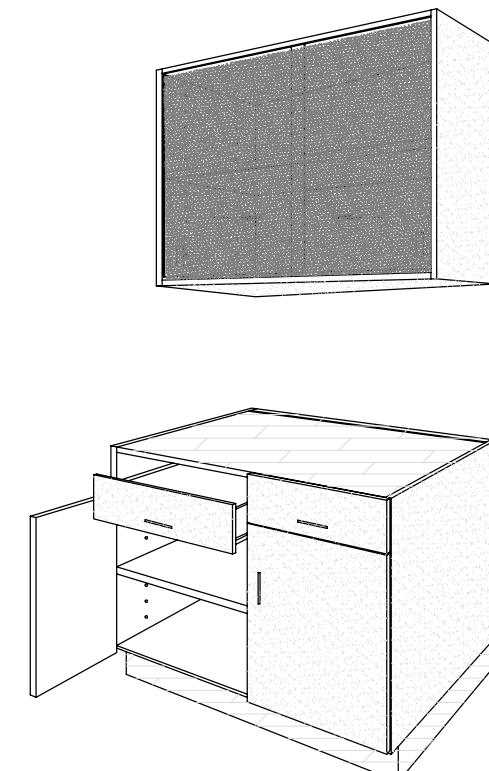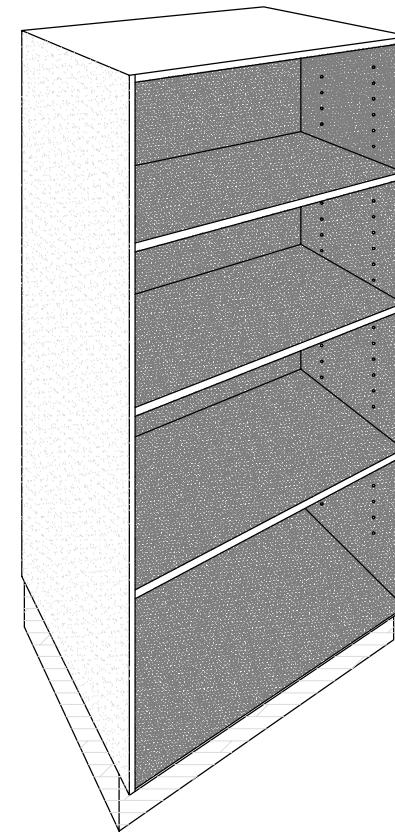

IF SIZE OF SHEET IS NOT 11 X 17, SCALE ACCORDINGLY.

| | | | |
|--|---|--------------------------------------|---|
| PROJECT NAME: CUSD PROFESSIONAL LEARNING CENTER | CONTRACTOR/CLIENT NAME: CLOVIS UNIFIED SCHOOL DISTRICT | SCALE: | DATE: |
| | | PROJECT NUMBER: 17052 | REVISED: 10/25/17 |
| LOCATION: CLOVIS, CA | ADDRESS: 1450 HERNDON AVE., CLOVIS, CA 93611 | FILE NAME: F:\MV7\EF\FD\17052 | DRAWN BY: AD REVISED BY: AD |
| SUPER PHONE: | PHONE: (559) 327-9000 FAX: | DRAWING NUMBER: 2 | SUBMITTAL SET |

TYP. SPECIFICATIONS

COUNTERTOPS

A. COUNTERTOP CONSTRUCTION

- | | |
|--------------------------|---------------------------|
| 1. GRADE | W.I. CUSTOM |
| 2. FRONT EDGE TYPE | BULLNOSE |
| 3. FRONT EDGE BUILD-DOWN | 1½" |
| 4. SPLASH TYPE | INTEGRAL COVE |
| 5. SPLASH HEIGHT | 6" |
| 6. SURFACE ADHESIVE | ES10 EVER STRONG ADHESIVE |
| 7. END TO END JOINERY | DRAW BOLTS |


B. COUNTERTOP MATERIALS

- | | |
|------------|---------------------------------|
| 1. SURFACE | PLASTIC LAMINATE/ SOLID SURFACE |
| 2. BACKER | BACKER SHEET |
| 3. CORE | ¾" 45LB PARTICLE BOARD |
| 4. SCRIBE | ¾" 45LB PARTICLE BOARD |


COUNTERTOP CONSTRUCTION

- | | |
|--------------------------|------------------|
| 1. FRONT EDGE TYPE | 180° BULLNOSE |
| 2. FRONT EDGE BUILD-DOWN | 1½" |
| 3. SPLASH TYPE | LOOSE, SQ TOP |
| 4. SPLASH HEIGHT | 4" |
| 5. CORE | ½" SOLID SURFACE |
| 6. SCRIBE | ½" SOLID SURFACE |

PLASTIC LAMINATE COUNTERTOP

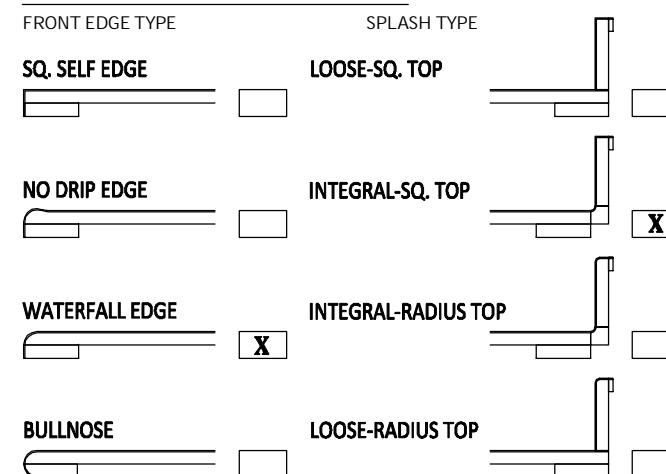

SOLID SURFACE COUNTERTOP

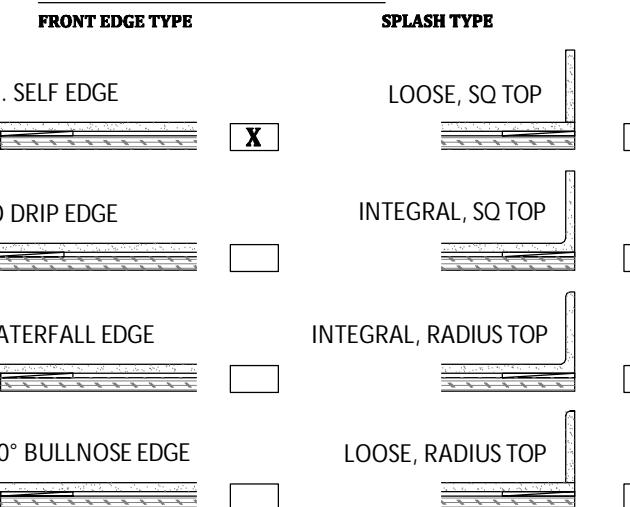

IF SIZE OF SHEET IS NOT 11 X 17, SCALE ACCORDINGLY.


| |
|---|
| EVERLAST WOODWORKING |
| 2555 N. Argyle, Fresno, California 93727 (559) 292-2448 - FAX (559) 292-3710 |

| | | | |
|---|--|-------------------------------|-----------------------------|
| PROJECT NAME: CUSD PROFESSIONAL LEARNING CENTER | CONTRACTOR/CLIENT NAME: CLOVIS UNIFIED SCHOOL DISTRICT | SCALE: | DATE: |
| | | PROJECT NUMBER: 17052 | REVISED: 10/25/17 |
| LOCATION: CLOVIS, CA | ADDRESS: 1450 HERNDON AVE., CLOVIS, CA 93611 | FILE NAME: F:\MV7\EF\FD\17052 | DRAWN BY: AD REVISED BY: AD |
| SUPER PHONE: | PHONE: (559) 327-9000 FAX: | DRAWING NUMBER: 2.1 | SUBMITTAL SET |

| | | | | | | | | | | | | | | |
|---|---------------|--|---------------|------------------|---|--|---------------|-------------------------------|-----------------------------|--|--|--|--|--|
| | ITEM | PL-1 | | ITEM | PL-2 | | ITEM | SS-1 | | | | | | |
| | MATERIAL | PLASTIC LAMINATE | | MATERIAL | PLASTIC LAMINATE | | MATERIAL | SOLID SURFACE | | | | | | |
| | MFG | WILSONART | | MFG | WILSONART | | MFG | SILESTONE | | | | | | |
| | COLOR | MANITOBA MAPLE 7911-60 | | COLOR | SKYLINE WALNUT 7964K-12 | | COLOR | CEMENTO | | | | | | |
| | EDGE | PVC-CABINET PVC-DOOR/DRAWER | | EDGE | PVC-CABINET PVC-DOOR/DRAWER | | EDGE | SS-1 | | | | | | |
| | REMARKS | TOPS/ CABINETS | | REMARKS | TOPS/ CABINETS | | REMARKS | TOPS | | | | | | |
| | HARDWARE ITEM | | HARDWARE ITEM | | HARDWARE ITEM | | HARDWARE ITEM | | HARDWARE ITEM | | | | | |
| | MFG | KNAPE & VOGT | | MFG | KNAPE & VOGT | | MFG | Knape & Vogt | | | | | | |
| | MFG NUMBER | KV-239 SUPPORTS | | MFG NUMBER | KV-25-WH STANDARDS | | MFG NUMBER | KV-8300 | | | | | | |
| | FINISH | ZINC | | FINISH | EPOXY-COATED WHITE | | FINISH | ZINC | | | | | | |
| | MATERIAL | STEEL | | MATERIAL | STEEL | | MATERIAL | STEEL | | | | | | |
| | REMARKS | NOTCHED SHELVES | | REMARKS | NOTCHED SHELVES | | REMARKS | 75lb FULL EXT. | | | | | | |
| | HARDWARE ITEM | | HARDWARE ITEM | | HARDWARE ITEM | | HARDWARE ITEM | | HARDWARE ITEM | | | | | |
| | MFG | OLYMPUS | MFG | ROCKFORD PROCESS | MFG | | JAMISON | | | | | | | |
| | MFG NUMBER | 100/200 SERIES | | MFG NUMBER | INSTITUTIONAL RPC 376 | | MFG NUMBER | SWP4-26D | | | | | | |
| | FINISH | US26D SATIN CHROME | | FINISH | NICKEL PLATED | | FINISH | SATIN CHROME | | | | | | |
| | BODY | ZINC DIE CAST | | MATERIAL | | | MATERIAL | STEEL | | | | | | |
| | REMARKS | 100 DOOR-HORIZ. 200 DOOR/DRAWER | | REMARKS | | | REMARKS | DISTANCE BETWEEN HOLES: 4" | | | | | | |
| | HARDWARE ITEM | | | | | | | | | | | | | |
| | MFG | EPSCO | | MFG NUMBER | EP592 | | FINISH | ALUMINUM | | | | | | |
| | REMARKS | | | MATERIAL | | | REMARKS | | | | | | | |
| IF SIZE OF SHEET IS NOT 11 X 17, SCALE ACCORDINGLY. | | | | | | | | | | | | | | |
| | | PROJECT NAME: CUSD PROFESSIONAL LEARNING CENTER | | | CONTRACTOR/CLIENT NAME: CLOVIS UNIFIED SCHOOL DISTRICT | | | SCALE: | DATE: 09/22/17 | | | | | |
| 2555 N. Argyle, Fresno, California 93727 (559) 292-2448 - FAX (559) 292-3710 | | LOCATION: CLOVIS, CA | | | ADDRESS: 1450 HERNDON AVE., CLOVIS, CA 93611 | | | PROJECT NUMBER: | REVISED: 10/25/17 | | | | | |
| SUPER PHONE: | | PHONE: (559) 327-9000 | | | FAX: F:\MV7\EF\FD\17052 | | | FILE NAME: | DRAWN BY: AD REVISED BY: AD | | | | | |
| | | PHONE: (559) 327-9000 | | | DRAWING NUMBER: 3 | | | | SUBMITTAL SET | | | | | |

COLORS



HARDWARE

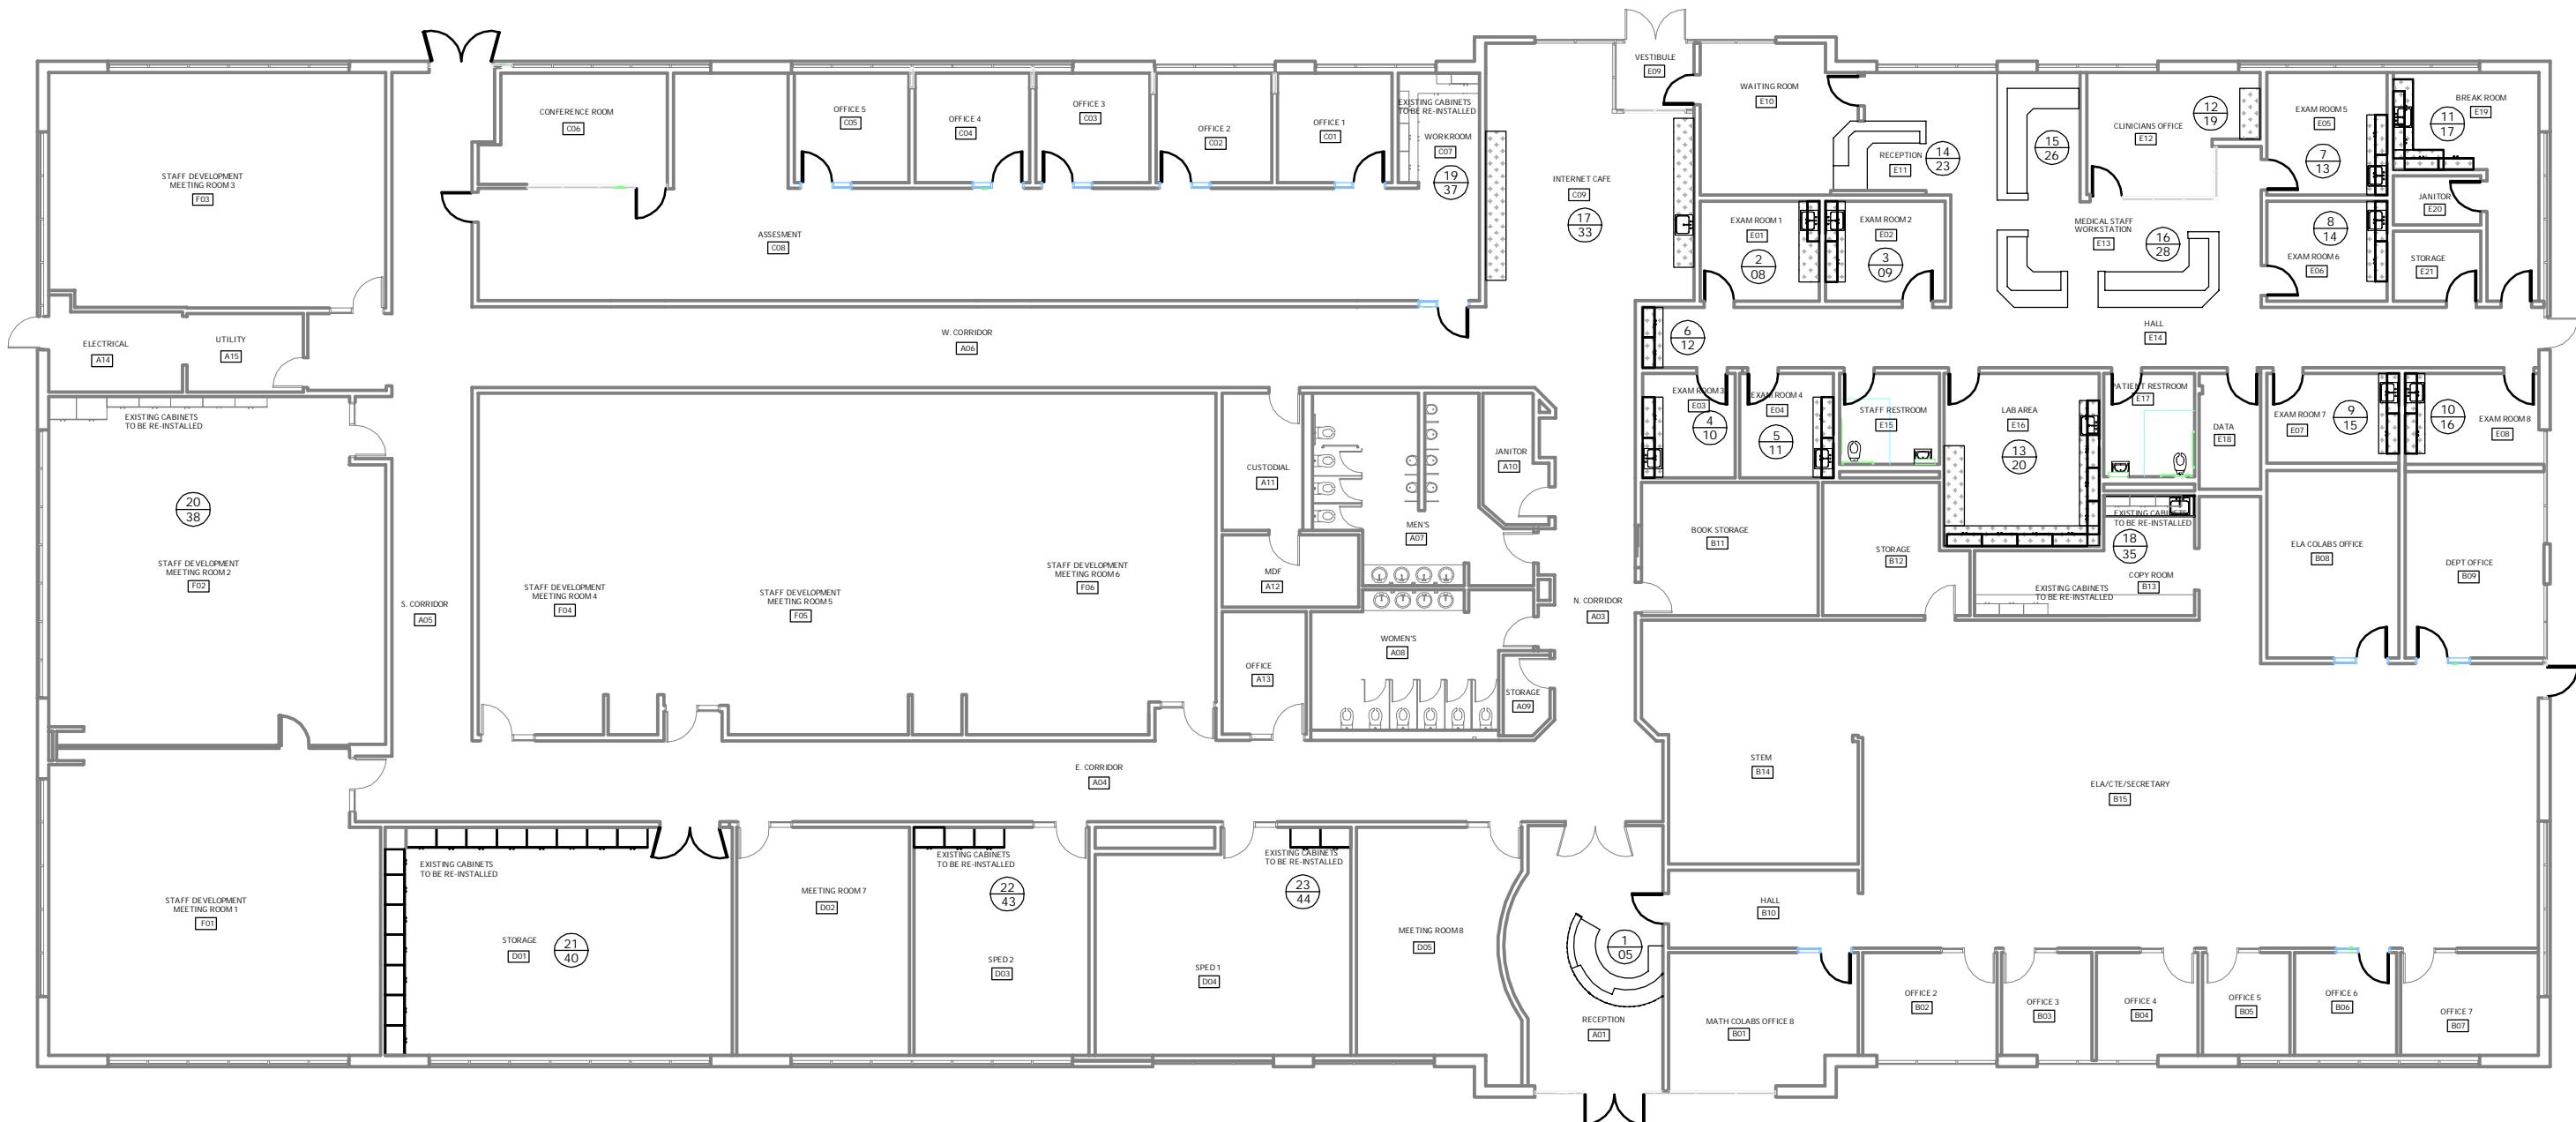

R1 REFERENCE PLAN:

IF SIZE OF SHEET IS NOT 11 X 17, SCALE ACCORDINGLY.

| | | | | |
|--|---|---|--------------------------------------|---|
| EVERLAST WOODWORKING <hr/> 2555 N. Argyle, Fresno, California 93727 (559) 292-2448 - FAX (559) 292-3710 | PROJECT NAME: CUSD PROFESSIONAL LEARNING CENTER LOCATION: CLOVIS, CA SUPER PHONE: | CONTRACTOR/CLIENT NAME: CLOVIS UNIFIED SCHOOL DISTRICT ADDRESS: 1450 HERNDON AVE., CLOVIS, CA 93611 PHONE: (559) 327-9000 FAX: | SCALE: | DATE: 09/22/17 |
| | | | PROJECT NUMBER: 17052 | REVISED: 10/25/17 |
| | | | FILE NAME: F:\MV7\EF\FD\17052 | DRAWN BY: AD REVISED BY: AD |
| | | | DRAWING NUMBER: 4 | SUBMITTAL SET |

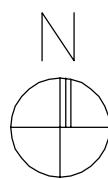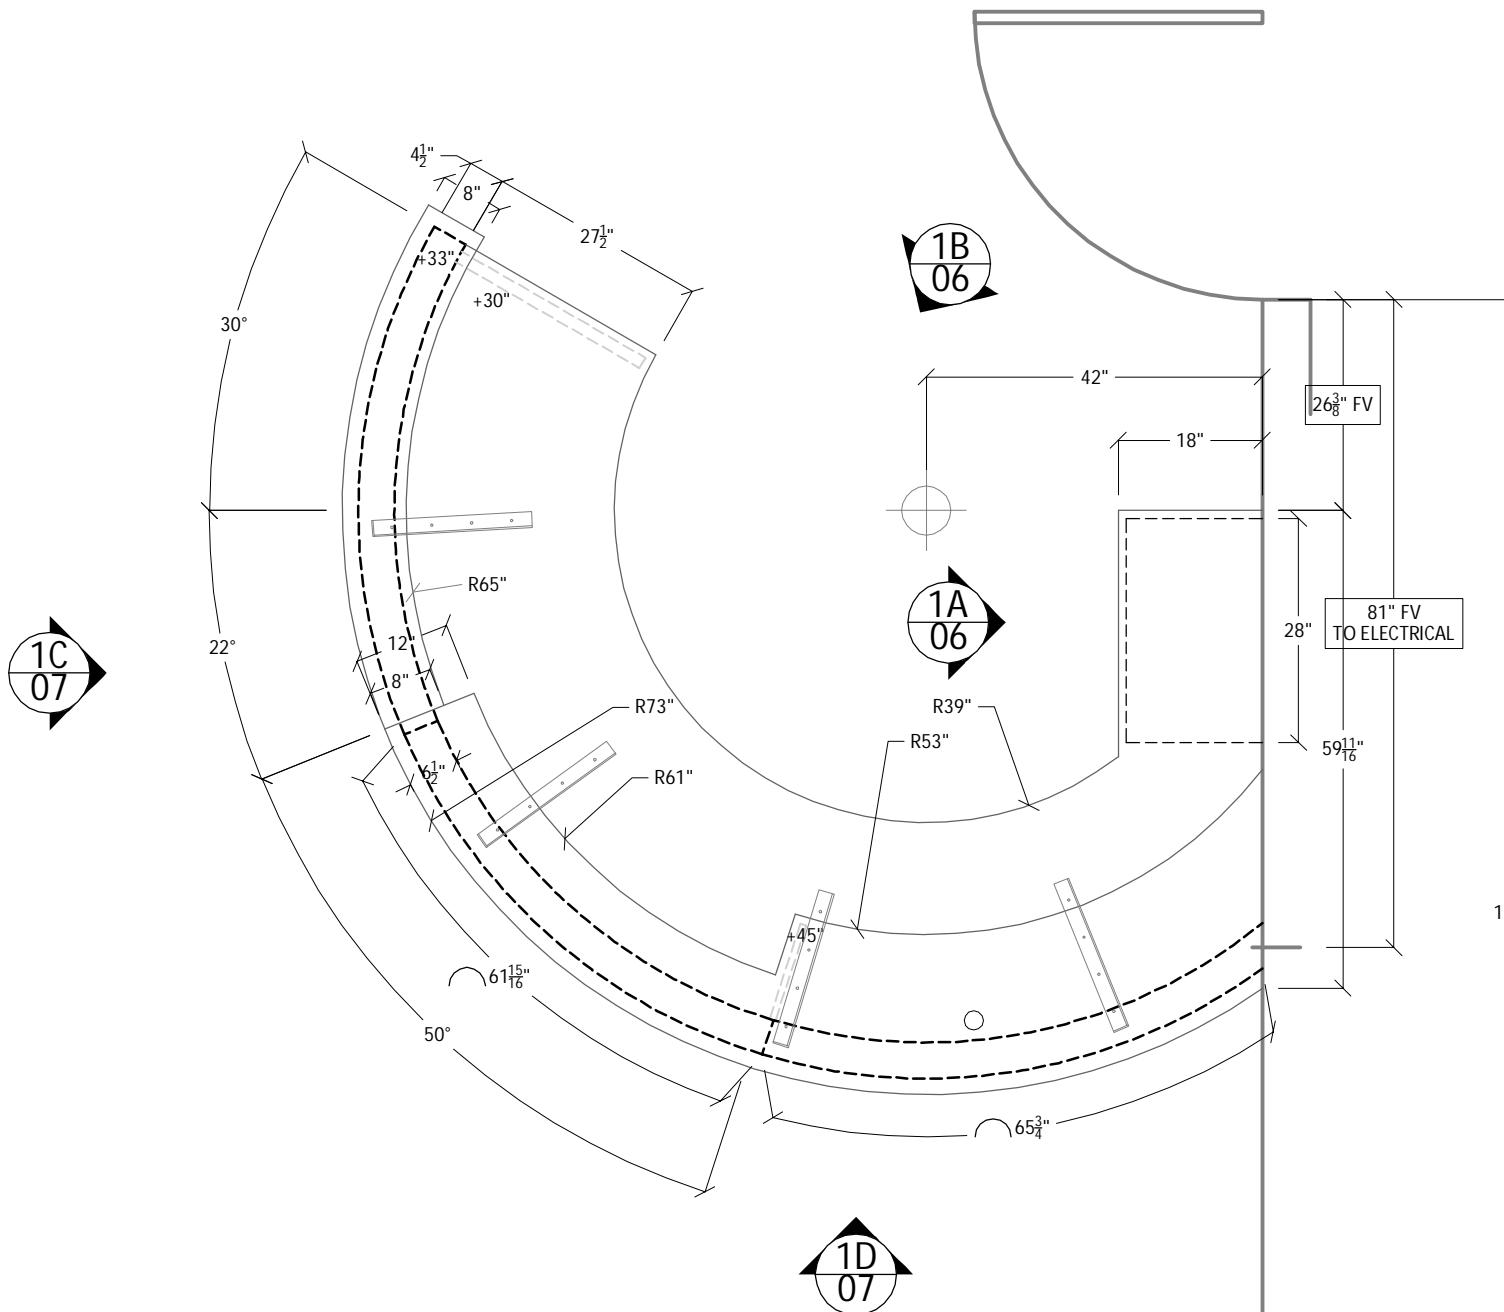




1 PLAN: RECEPTION #A01

REF: ARCH. PAGE NO. X-A302
SCALE: $\frac{1}{2}$ "=1'-0"

IF SIZE OF SHEET IS NOT 11 X 17, SCALE ACCORDINGLY.


| |
|---|
| EVERLAST WOODWORKING |
| 2555 N. Argyle, Fresno, California 93727 (559) 292-2448 - FAX (559) 292-3710 |

| | | | |
|--|---|---|---|
| PROJECT NAME: CUSD PROFESSIONAL LEARNING CENTER | CONTRACTOR/CLIENT NAME: CLOVIS UNIFIED SCHOOL DISTRICT | SCALE: | DATE: |
| LOCATION: CLOVIS, CA | ADDRESS: 1450 HERNDON AVE., CLOVIS, CA 93611 | PROJECT NUMBER: 17052 | REVISED: 10/25/17 |
| SUPER PHONE: | PHONE: (559) 327-9000 FAX: | FILE NAME: F:\MV7\EF\FD\17052 | DRAWN BY: AD REVISED BY: AD |
| | | DRAWING NUMBER: 5 | SUBMITTAL SET |

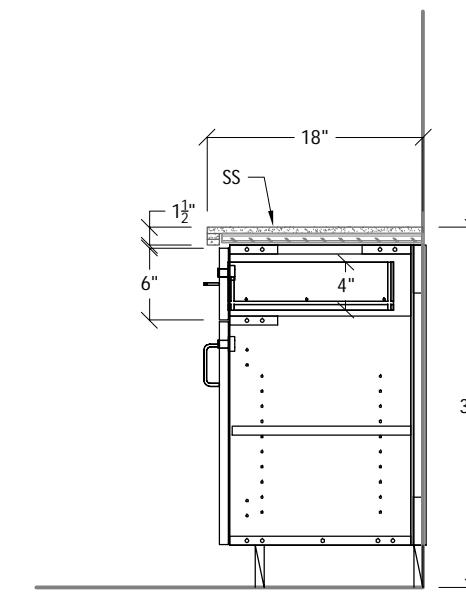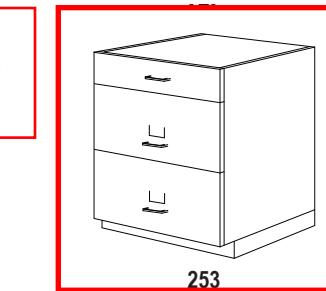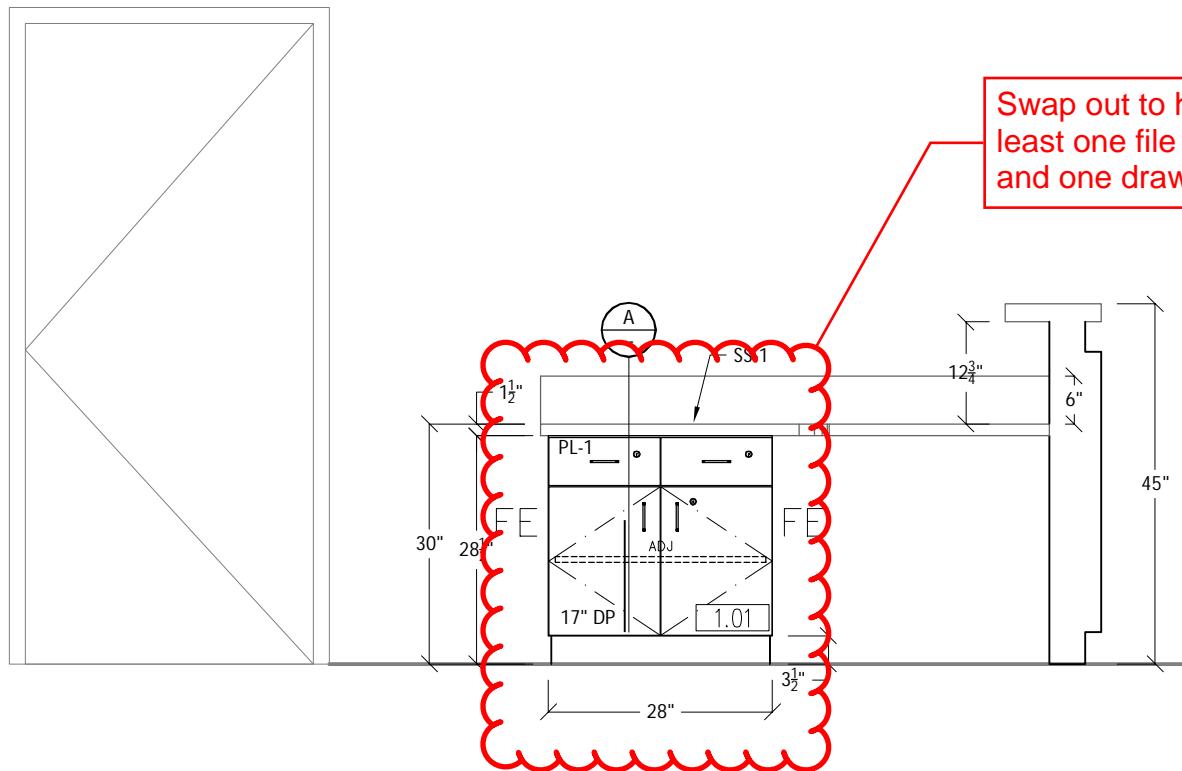

1A ELEVATION: RECEPTION #A01

REF: ARCH. PAGE NO. X-A303
SCALE: $\frac{1}{2}$ "=1'-0"

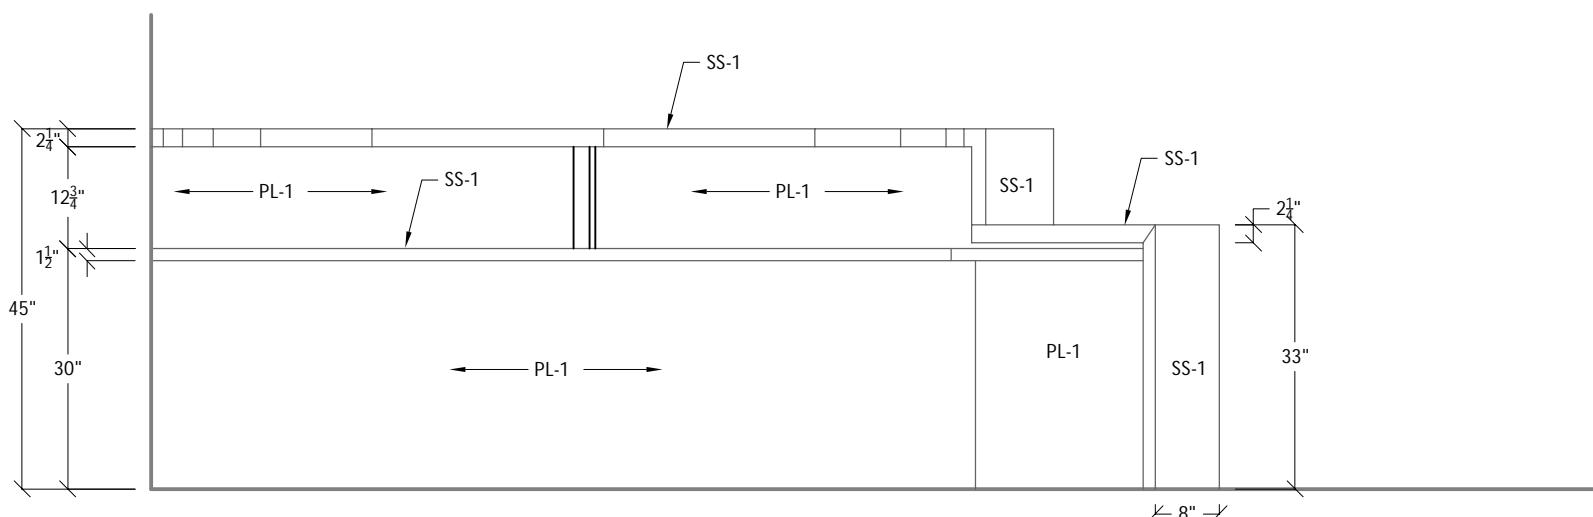


1B ELEVATION: RECEPTION #A01

REF: ARCH. PAGE NO. X-A303
SCALE: $\frac{1}{2}$ "=1'-0"

IF SIZE OF SHEET IS NOT 11 X 17, SCALE ACCORDINGLY.


| |
|---|
| EVERLAST WOODWORKING |
| 2555 N. Argyle, Fresno, California 93727 (559) 292-2448 - FAX (559) 292-3710 |

| | | | |
|--|---|--------------------------------------|-----------------------------|
| PROJECT NAME: CUSD PROFESSIONAL LEARNING CENTER | CONTRACTOR/CLIENT NAME: CLOVIS UNIFIED SCHOOL DISTRICT | SCALE: | DATE: 09/22/17 |
| LOCATION: CLOVIS, CA | ADDRESS: 1450 HERNDON AVE., CLOVIS, CA 93611 | PROJECT NUMBER: 17052 | REVISED: 10/25/17 |
| SUPER PHONE: | PHONE: (559) 327-9000 FAX: | FILE NAME: F:\MV7\EF\FD\17052 | DRAWN BY: AD REVISED BY: AD |
| | | DRAWING NUMBER: 6 | SUBMITTAL SET |

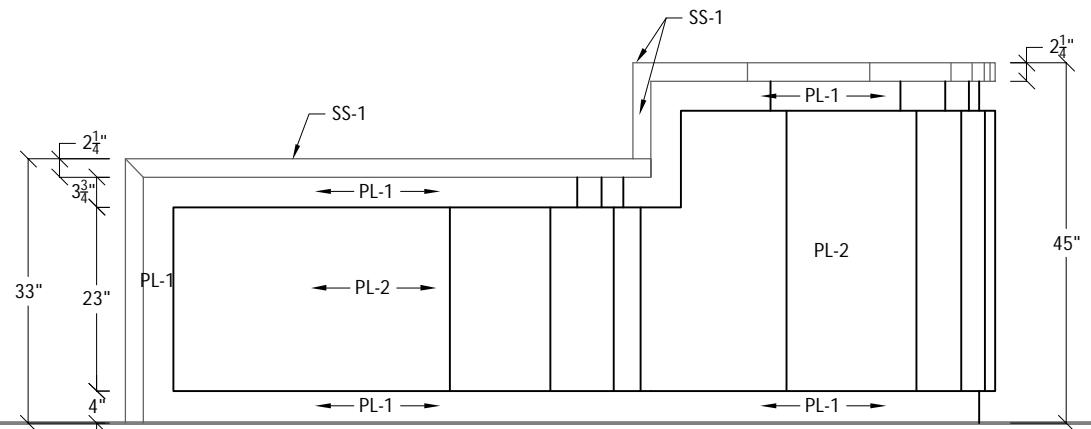


1C ELEVATION: RECEPTION #A01

REF: ARCH. PAGE NO. X-A303
SCALE: $\frac{1}{2}''=1'-0''$

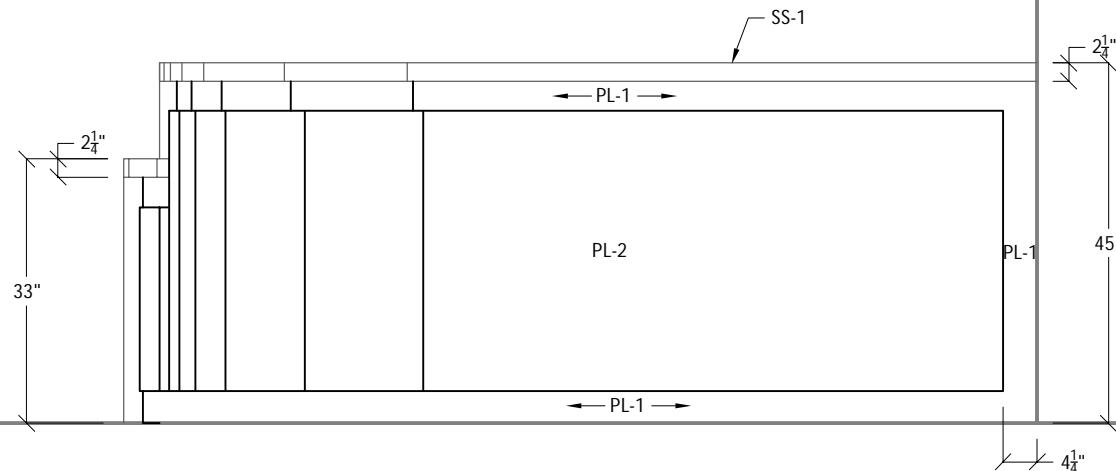

1D ELEVATION: RECEPTION #A01

REF: ARCH. PAGE NO. X-A303
SCALE: $\frac{1}{2}''=1'-0''$

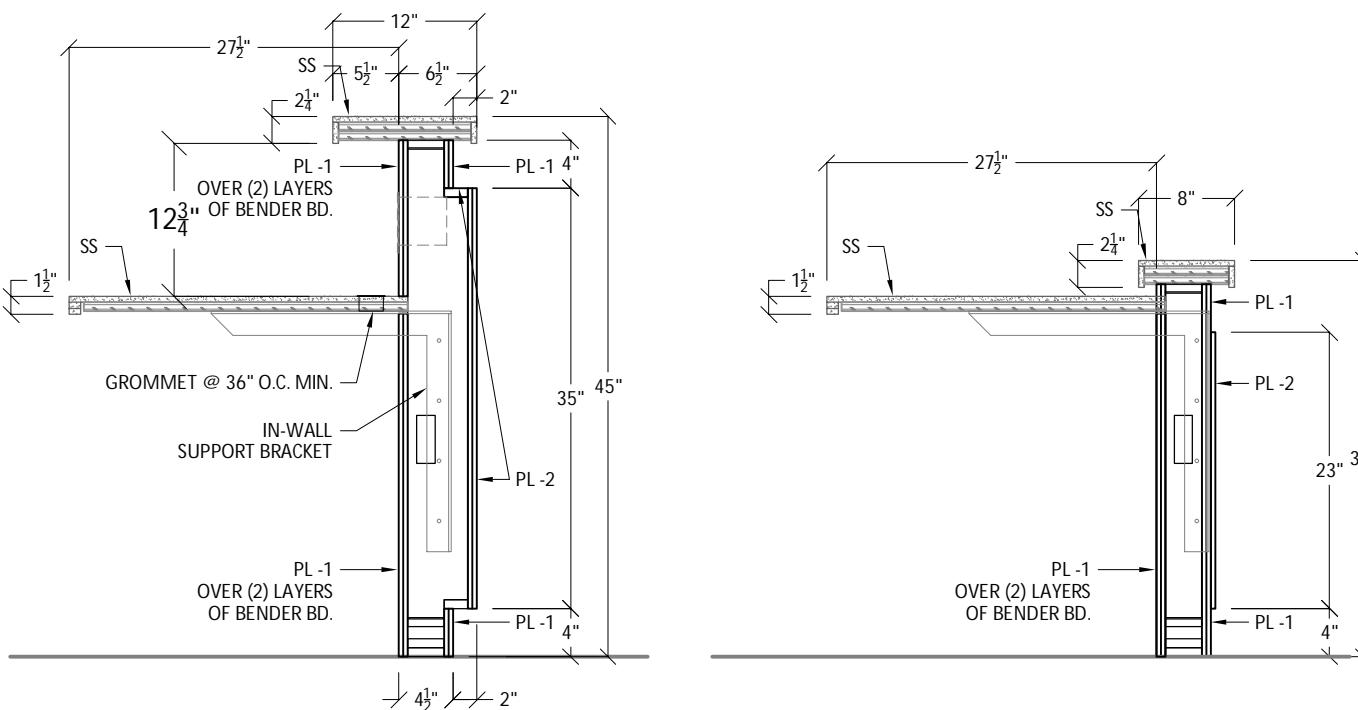



A SECTION

SCALE: $\frac{3}{4}''=1'-0''$
ARCHITECT REF PAGE NO: A1/ X-A302

B SECTION

SCALE: $\frac{3}{4}''=1'-0''$
ARCHITECT REF PAGE NO: A5/ X-A302

IF SIZE OF SHEET IS NOT 11 X 17, SCALE ACCORDINGLY.

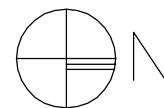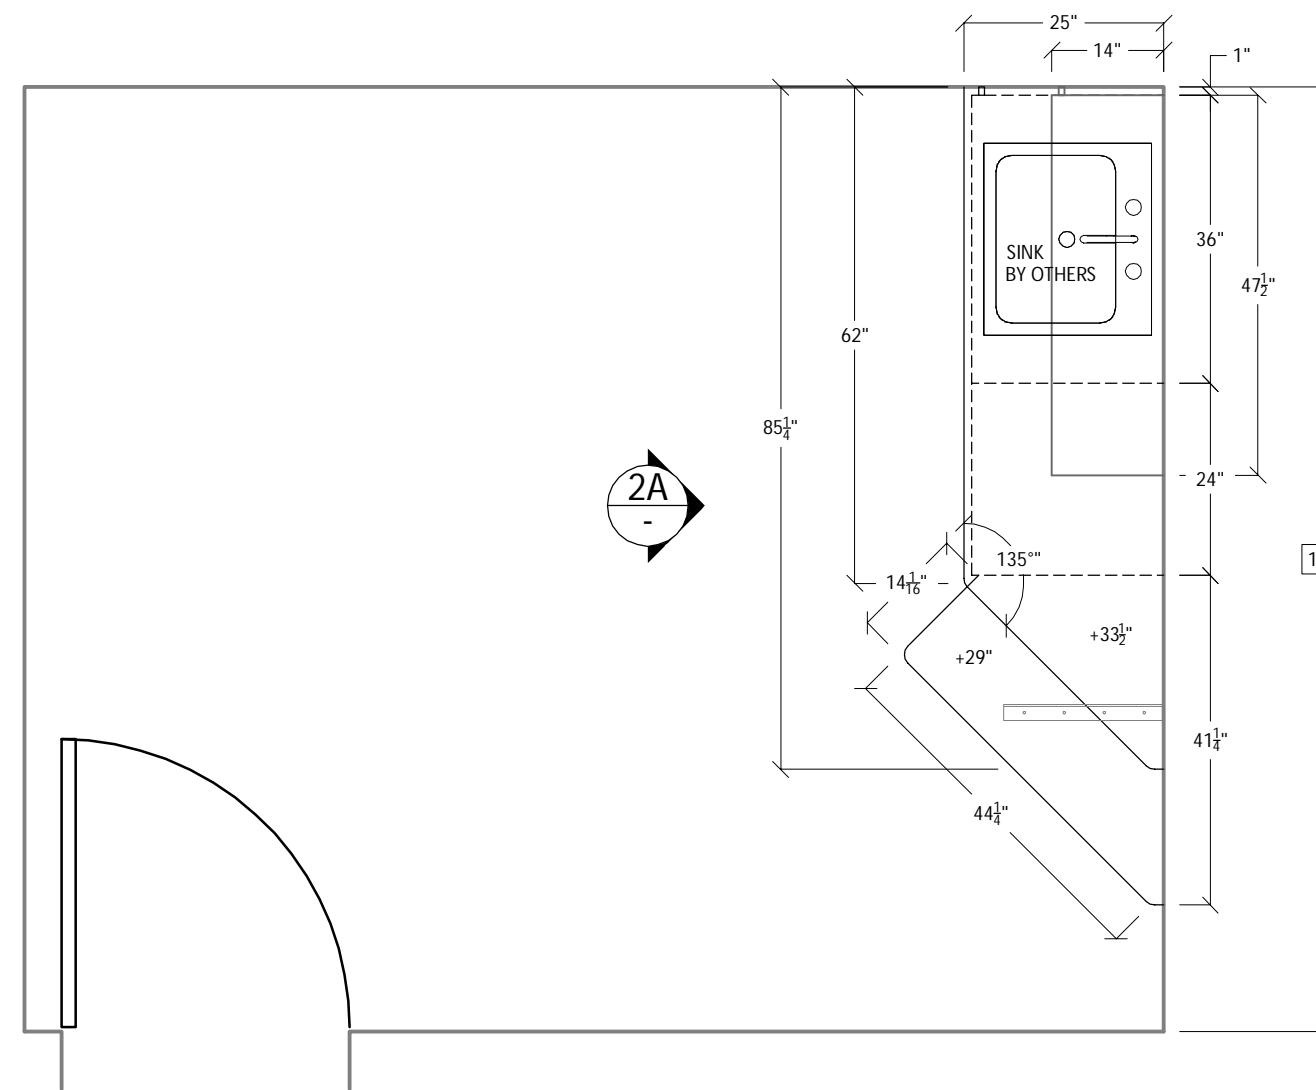


2

PLAN: EXAM ROOM 1 #E01

REF: ARCH. PAGE NO. A/A106

SCALE: $\frac{1}{2}$ " = 1'-0"

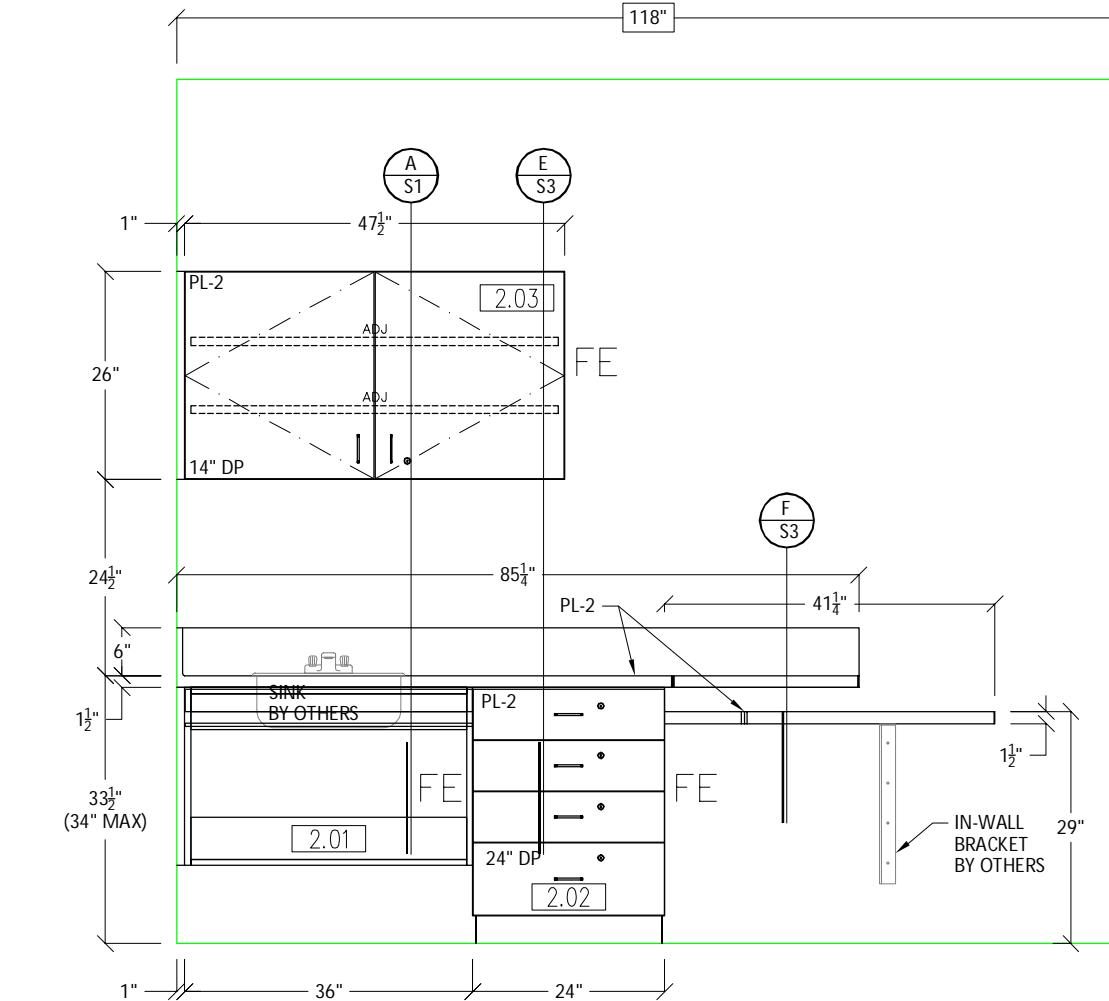

2A

ELEVATION: EXAM ROOM 1 #E01



REF: ARCH. PAGE NO. E/A601

SCALE: $\frac{1}{2}$ " = 1'-0"

IF SIZE OF SHEET IS NOT 11 X 17, SCALE ACCORDINGLY.

| | | | | |
|---|---|--|--------------------------|--------------------------------|
| EVERLAST WOODWORKING | PROJECT NAME: CUSD PROFESSIONAL LEARNING CENTER | CONTRACTOR/CLIENT NAME: CLOVIS UNIFIED SCHOOL DISTRICT | SCALE: | DATE: |
| 2555 N. Argyle, Fresno, California 93727 (559) 292-2448 - FAX (559) 292-3710 | LOCATION: CLOVIS, CA | ADDRESS: 1450 HERNDON AVE., CLOVIS, CA 93611 | PROJECT NUMBER: 17052 | 09/22/17 REVISED: 10/25/17 |
| SUPER PHONE: | PHONE: (559) 327-9000 | FAX: | DRAWING NUMBER: 8 | DRAWN BY: AD REVISED BY: AD |

| | | |
|--|----------------------------------|--------------------------------|
| CONTRACTOR/CLIENT NAME: CLOVIS UNIFIED SCHOOL DISTRICT | SCALE: | DATE: |
| ADDRESS: 1450 HERNDON AVE., CLOVIS, CA 93611 | PROJECT NUMBER: 17052 | 09/22/17 REVISED: 10/25/17 |
| PHONE: (559) 327-9000 | DRAWING NUMBER: 8 | DRAWN BY: AD REVISED BY: AD |
| FAX: | FILE NAME: F:\MV7\EF\FD\17052 | SUBMITTAL SET |

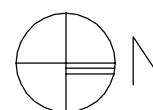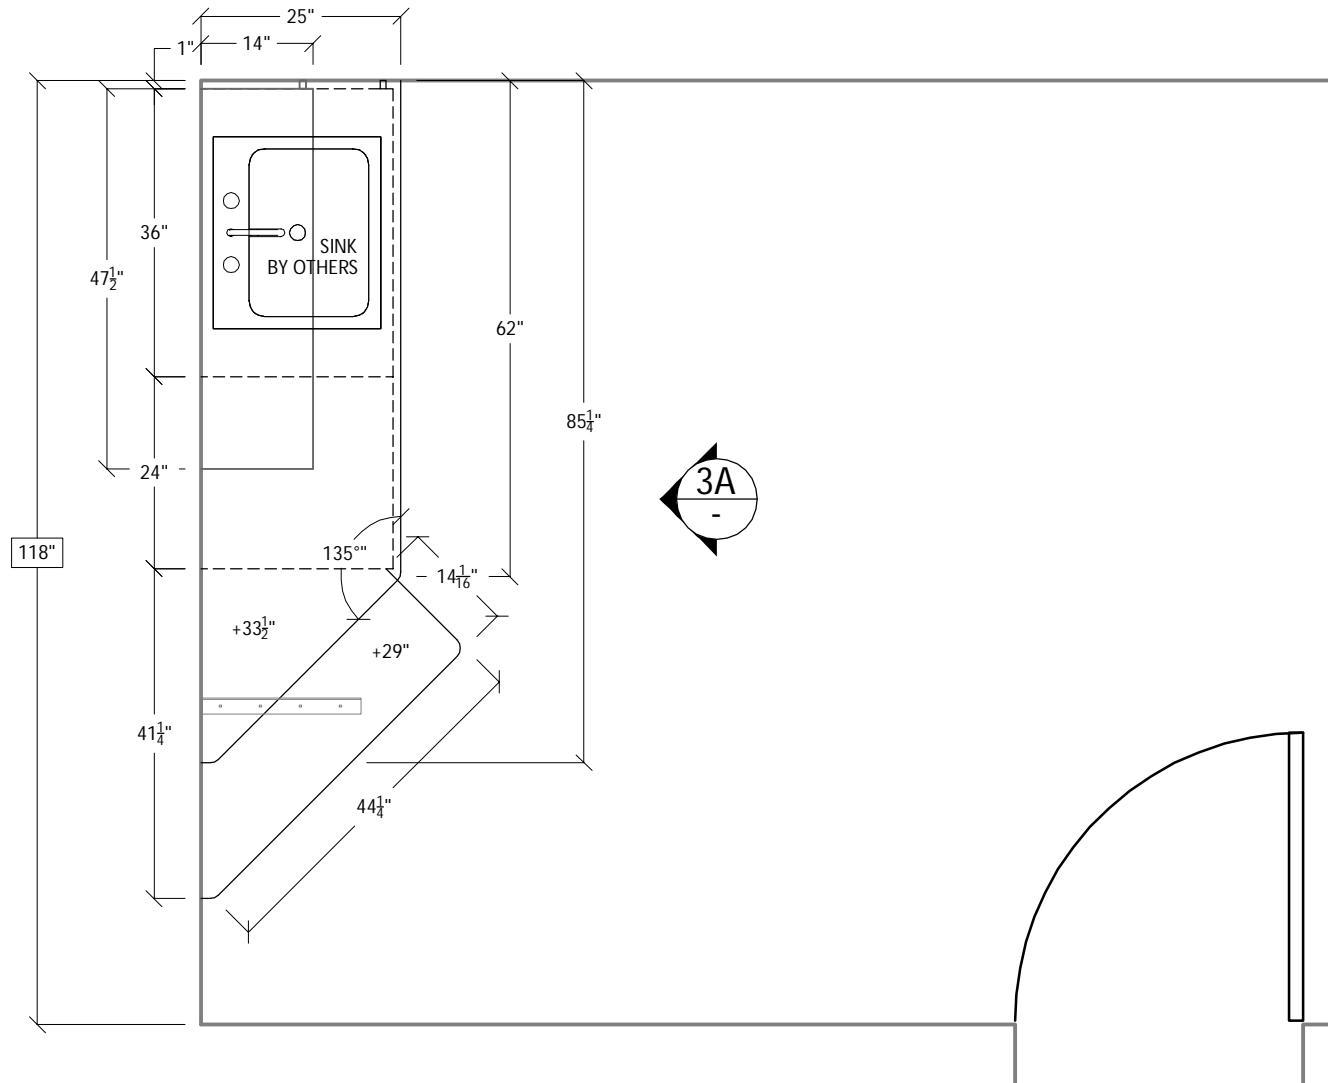

3

PLAN: EXAM ROOM 2 #E02

REF: ARCH. PAGE NO. A/A106

SCALE: $\frac{1}{2}'' = 1'-0''$



2555 N. Argyle, Fresno, California 93727
(559) 292-2448 - FAX (559) 292-3710

PROJECT
NAME:

CUSD PROFESSIONAL LEARNING CENTER

LOCATION:

CLOVIS, CA

SUPER PHONE:

CONTRACTOR/CLIENT
NAME:

CLOVIS UNIFIED SCHOOL DISTRICT


ADDRESS:

1450 HERNDON AVE., CLOVIS, CA 93611

PHONE:

(559) 327-9000

FAX:

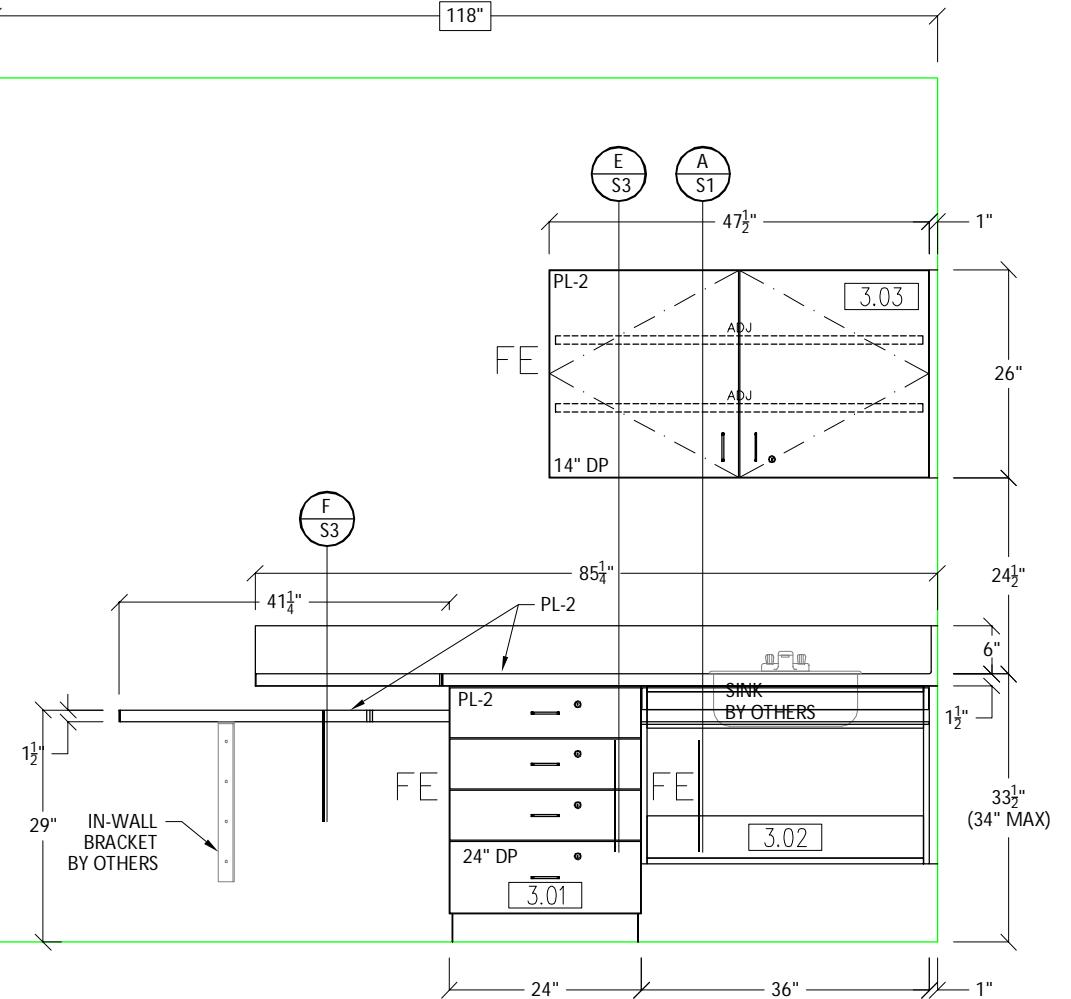

3A

ELEVATION: EXAM ROOM 2 #E02

REF: ARCH. PAGE NO. E/A601

SCALE: $\frac{1}{2}'' = 1'-0''$

IF SIZE OF SHEET IS NOT 11 X 17, SCALE ACCORDINGLY.

DATE: 09/22/17

REVISED: 10/25/17

DRAWN BY: AD REVISED BY: AD



SUBMITTAL SET


SCALE:

PROJECT NUMBER: 17052

FILE NAME: F:\MV7\EF\FD\17052

DRAWING NUMBER: 9

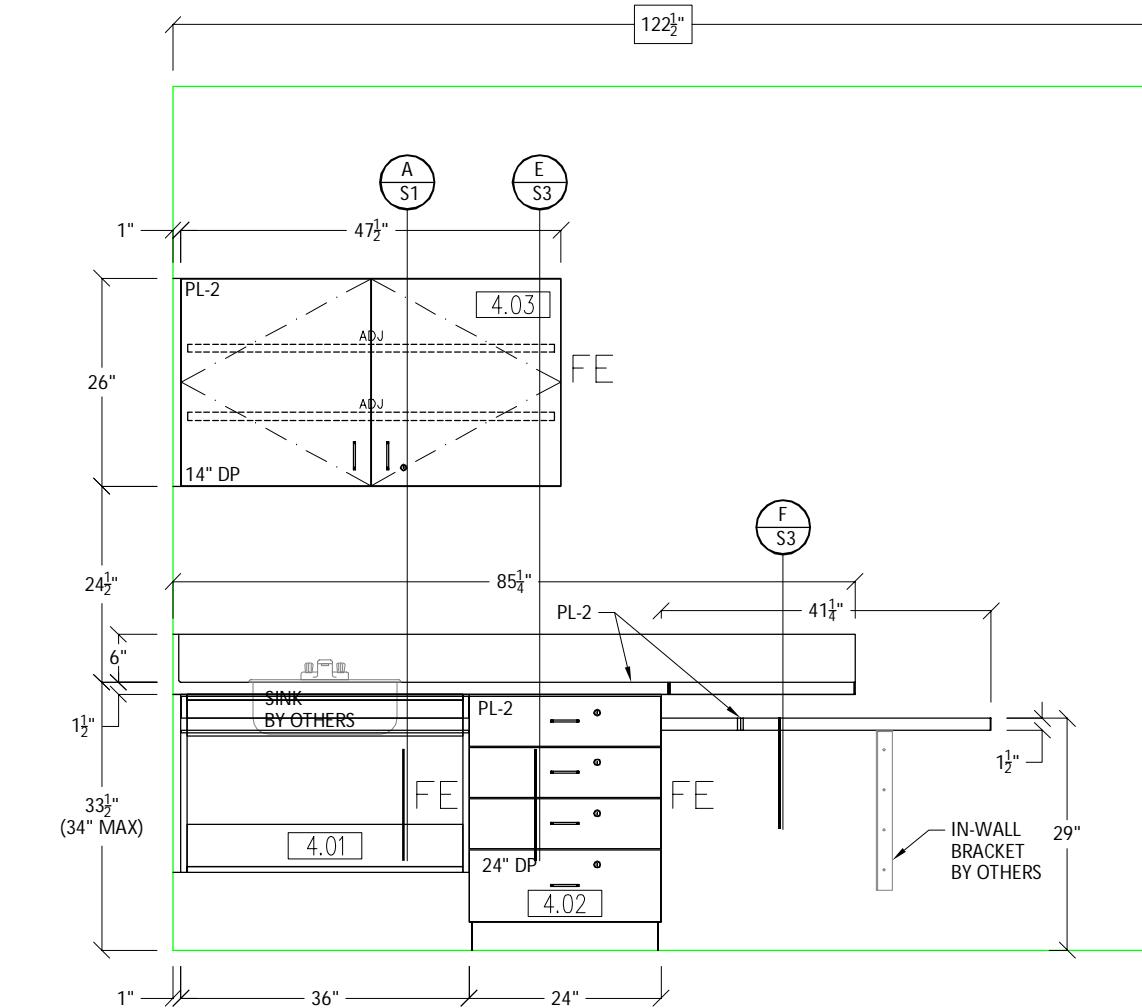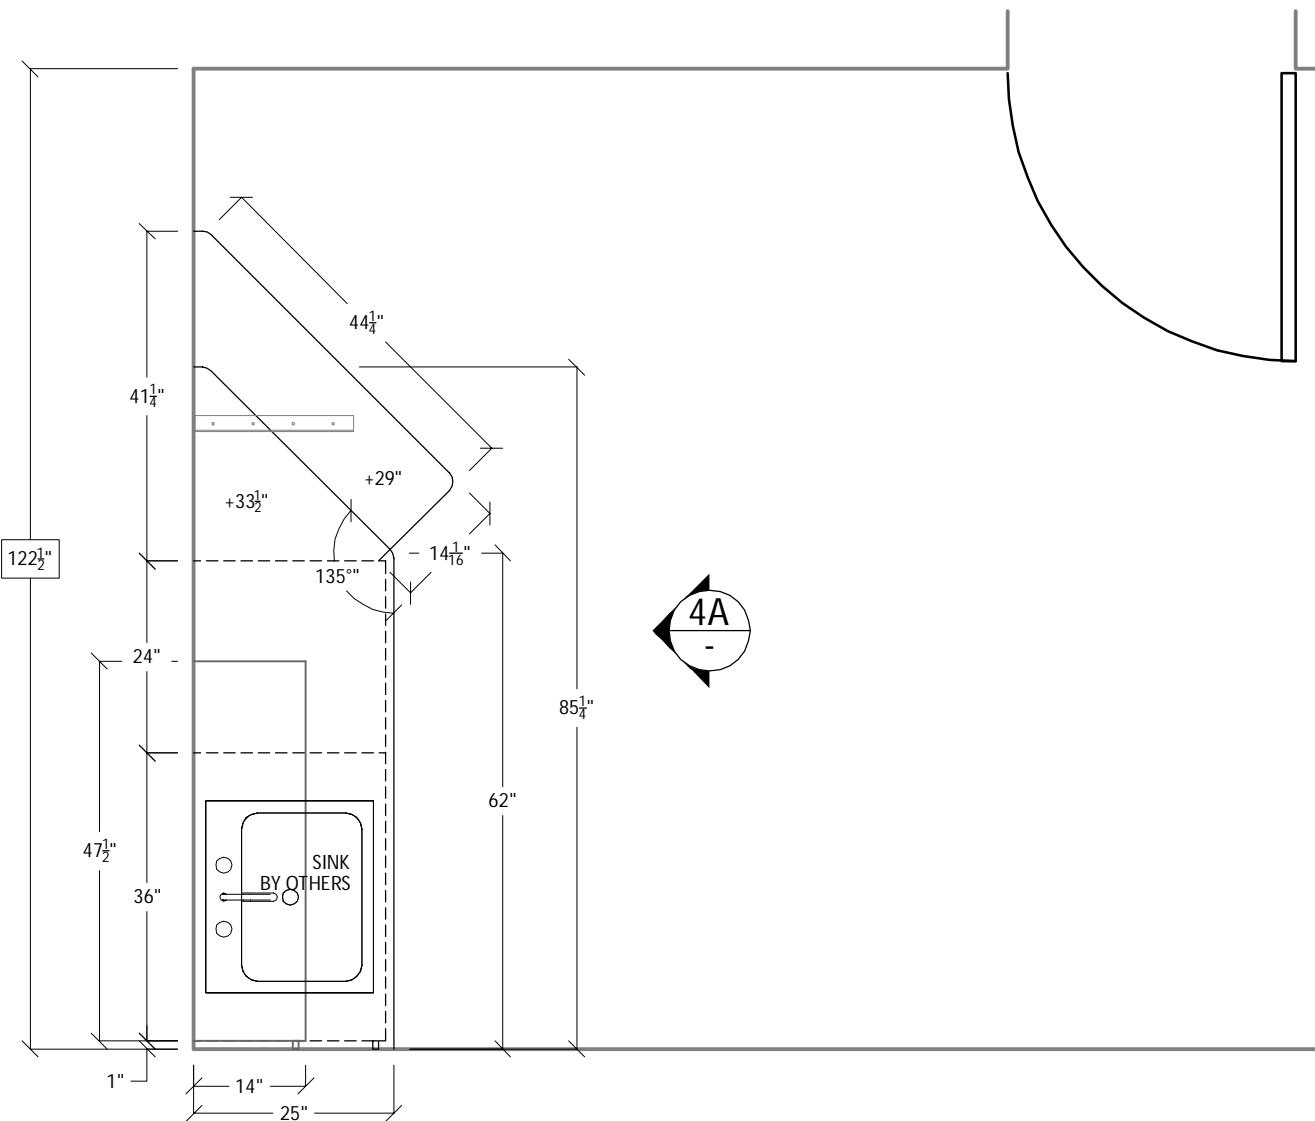

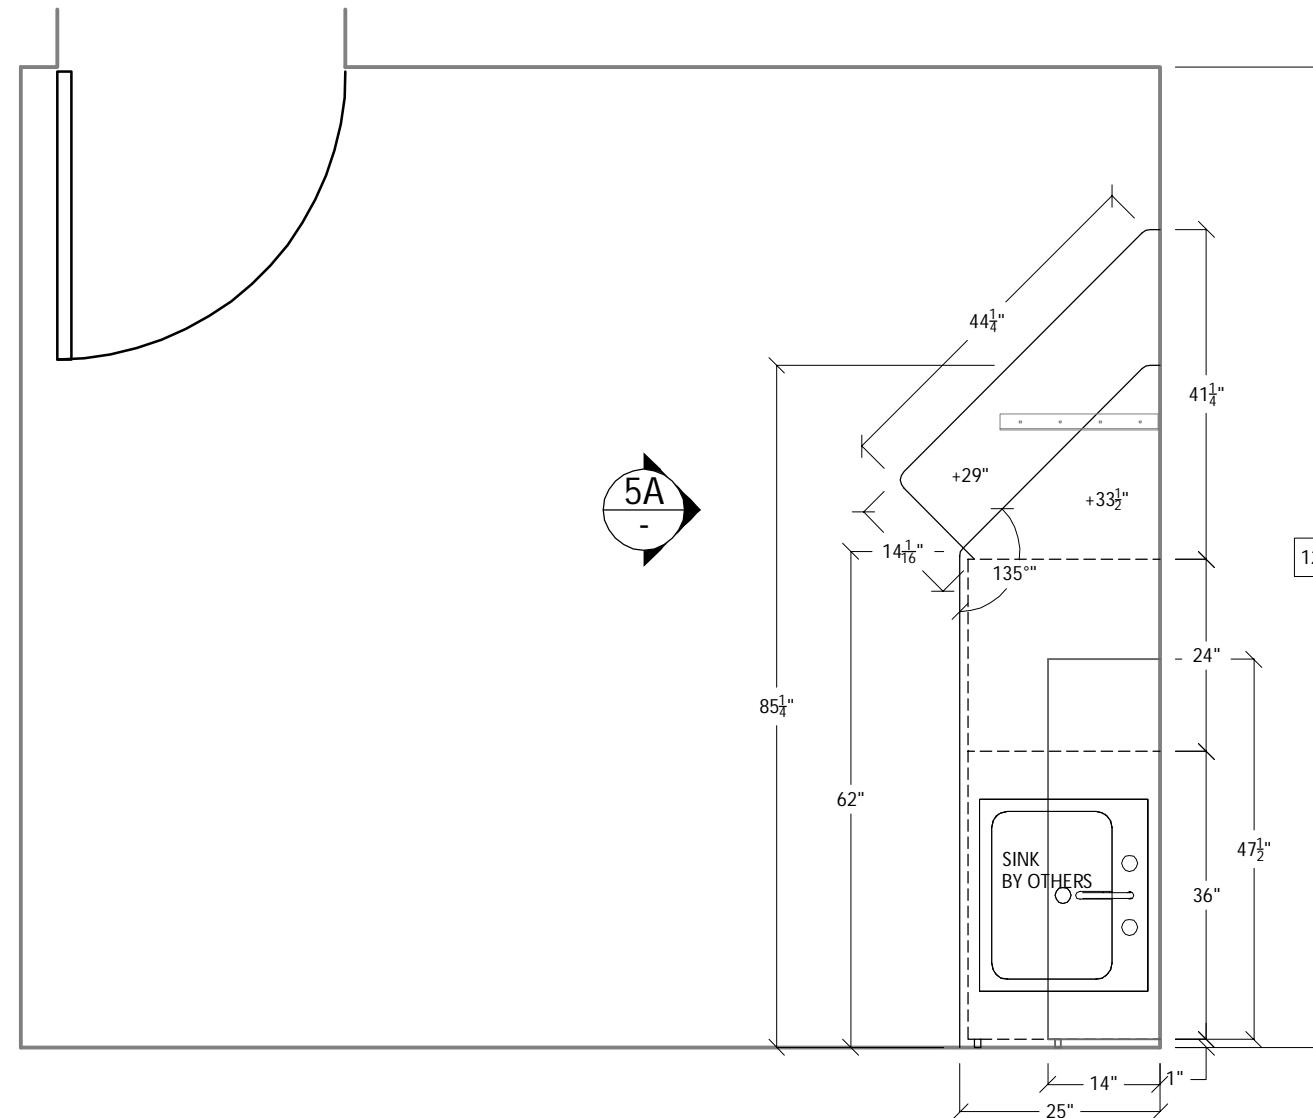


5

PLAN: EXAM ROOM 4 #E04

REF: ARCH. PAGE NO. A/A106

SCALE: $\frac{1}{2}'' = 1'-0''$

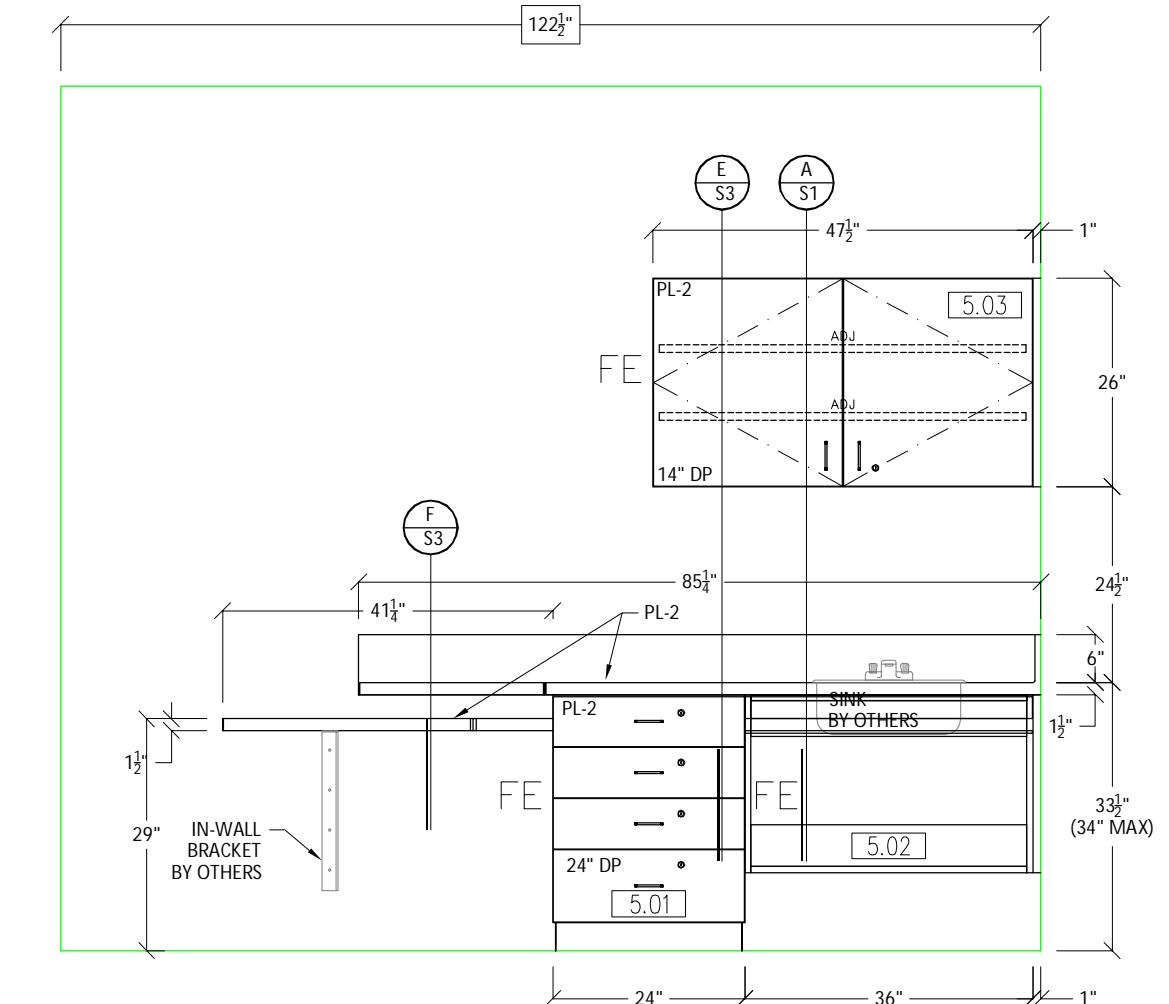

5A

ELEVATION: EXAM ROOM 4 #E04


REF: ARCH. PAGE NO. E/A601

SCALE: $\frac{1}{2}'' = 1'-0''$

IF SIZE OF SHEET IS NOT 11 X 17, SCALE ACCORDINGLY.

| | | | | |
|---|---|--|--------------------------|--------------------------------|
| EVERLAST WOODWORKING | PROJECT NAME: CUSD PROFESSIONAL LEARNING CENTER | CONTRACTOR/CLIENT NAME: CLOVIS UNIFIED SCHOOL DISTRICT | SCALE: | DATE: |
| 2555 N. Argyle, Fresno, California 93727 (559) 292-2448 - FAX (559) 292-3710 | LOCATION: CLOVIS, CA | ADDRESS: 1450 HERNDON AVE., CLOVIS, CA 93611 | PROJECT NUMBER: 17052 | 09/22/17 REVISED: 10/25/17 |
| SUPER PHONE: | PHONE: (559) 327-9000 | FAX: | DRAWING NUMBER: 11 | DRAWN BY: AD REVISED BY: AD |


| | |
|-------------------------------|---------------|
| FILE NAME: F:\MV7\EF\FD\17052 | DRAWN BY: AD |
| DRAWING NUMBER: 11 | SUBMITTAL SET |

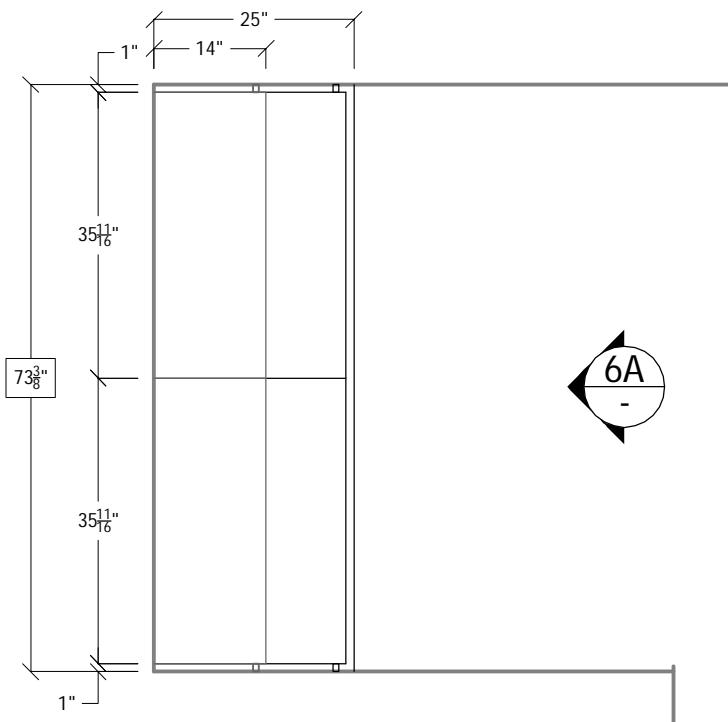

PLAN: HALL #E14

REF: ARCH. PAGE NO. A/A106

SCALE: $\frac{1}{2}'' = 1'-0''$

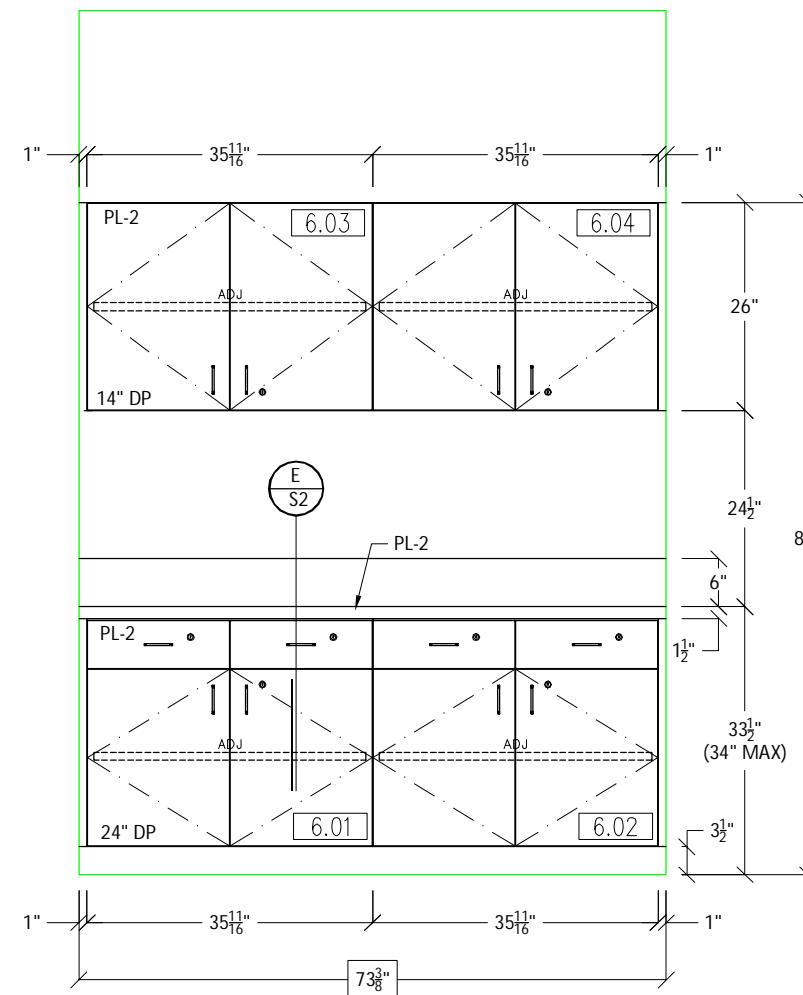

ELEVATION: HALL #E14

REF: ARCH. PAGE NO.

SCALE: $\frac{1}{2}'' = 1'-0''$

IF SIZE OF SHEET IS NOT 11 X 17, SCALE ACCORDINGLY.



2555 N. Argyle, Fresno, California 93727
(559) 292-2448 - FAX (559) 292-3710

PROJECT
NAME:
CUSD PROFESSIONAL LEARNING CENTER

LOCATION:
CLOVIS, CA



SUPER PHONE:

CONTRACTOR/CLIENT
NAME:
CLOVIS UNIFIED SCHOOL DISTRICT

ADDRESS:
1450 HERNDON AVE., CLOVIS, CA 93611

PHONE: (559) 327-9000 FAX:

| | |
|-------------------------------|-----------------------------|
| SCALE: | DATE: 09/22/17 |
| PROJECT NUMBER: | REVISED: 10/25/17 |
| FILE NAME: F:\MV7\EF\FD\17052 | DRAWN BY: AD REVISED BY: AD |
| DRAWING NUMBER: 12 | SUBMITTAL SET |

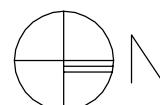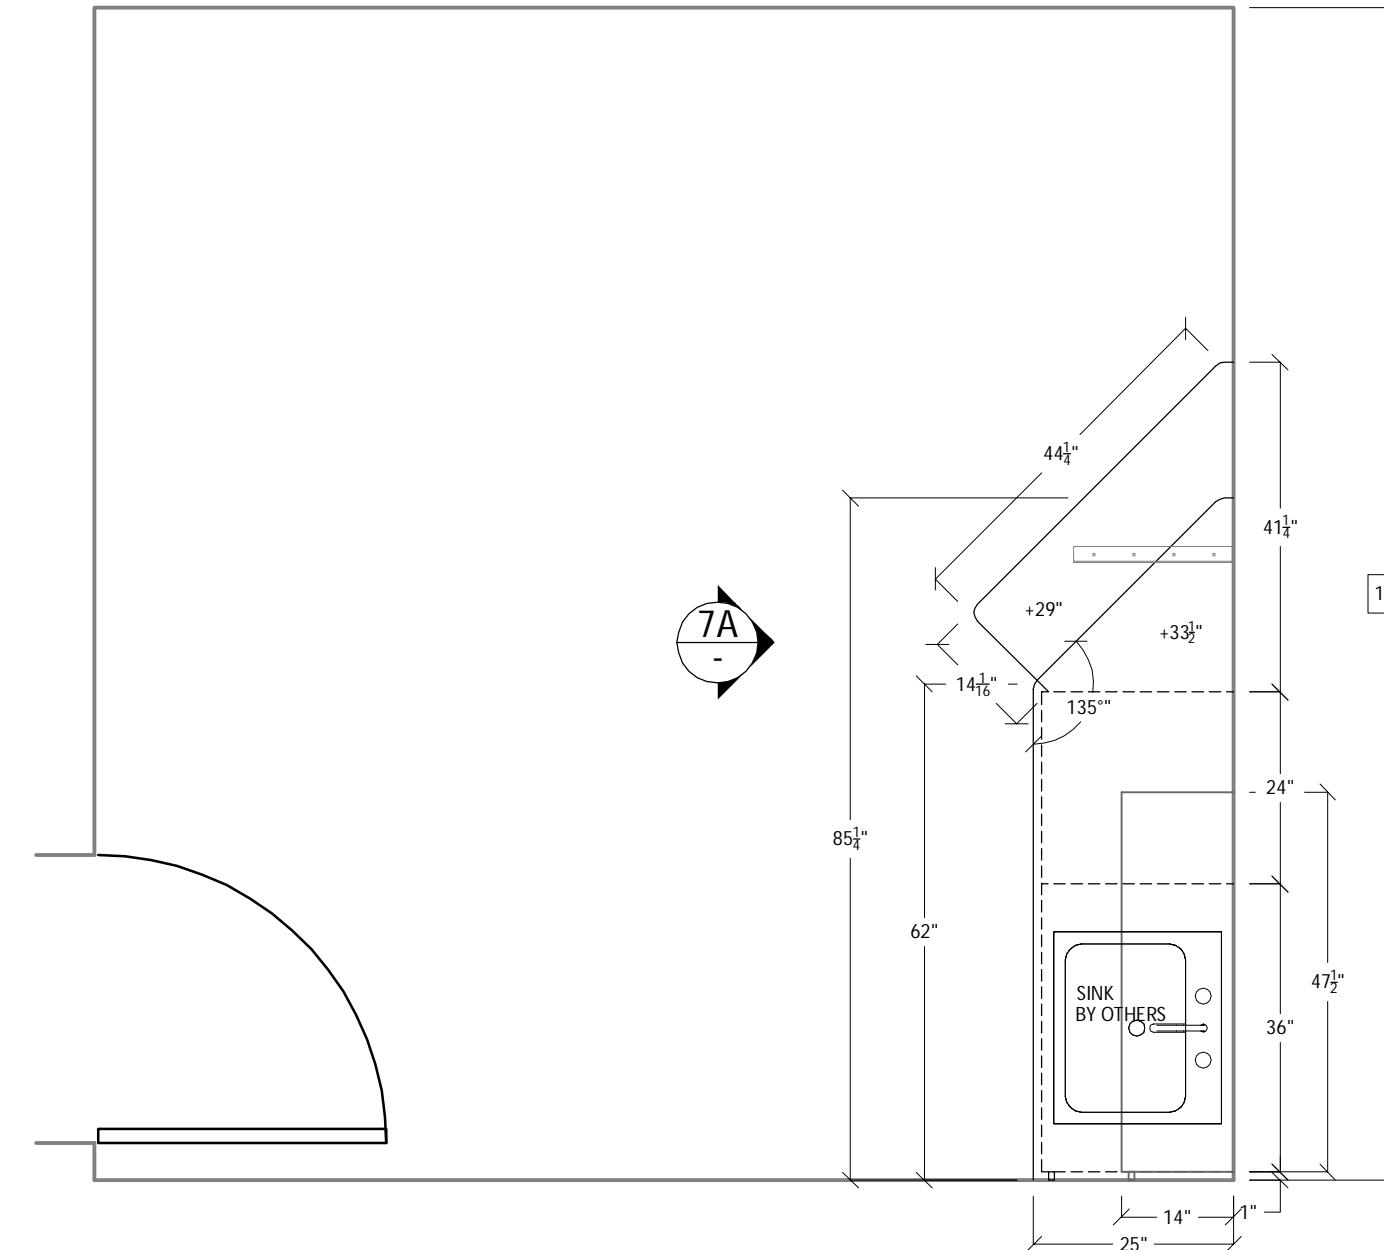


7

PLAN: EXAM ROOM 5 #E05

REF: ARCH. PAGE NO. A/A106

SCALE: $\frac{1}{2}$ " = 1'-0"

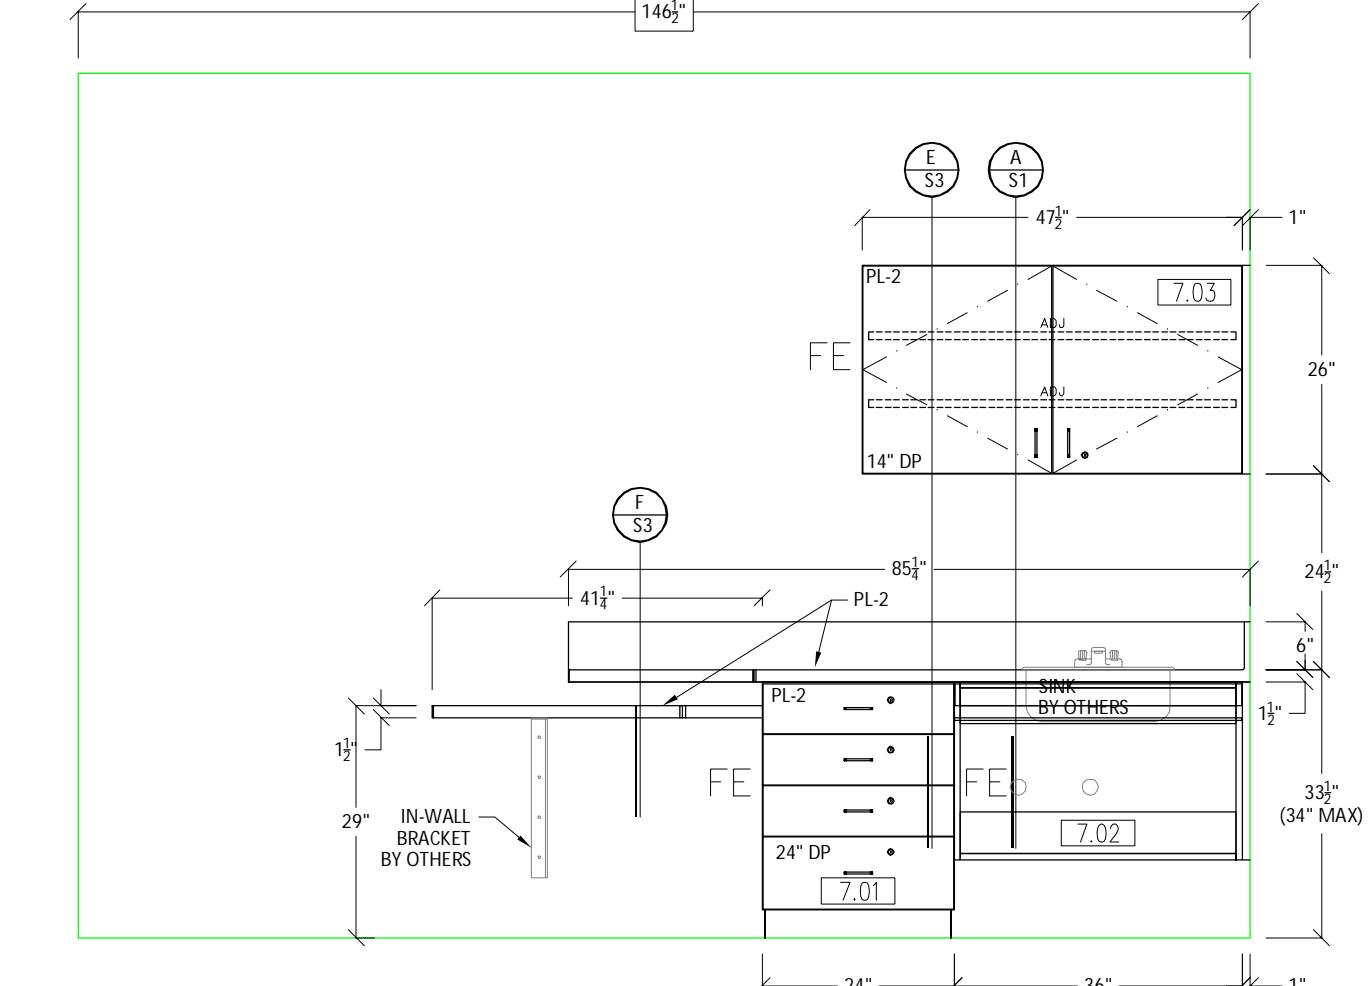

7A

ELEVATION: EXAM ROOM 5 #E05


REF: ARCH. PAGE NO. E/A601

SCALE: $\frac{1}{2}$ " = 1'-0"

IF SIZE OF SHEET IS NOT 11 X 17, SCALE ACCORDINGLY.

| | | | | |
|---|---|--|-------------------------------|-----------------------------|
| EVERLAST WOODWORKING | PROJECT NAME: CUSD PROFESSIONAL LEARNING CENTER | CONTRACTOR/CLIENT NAME: CLOVIS UNIFIED SCHOOL DISTRICT | SCALE: | DATE: 09/22/17 |
| 2555 N. Argyle, Fresno, California 93727 (559) 292-2448 - FAX (559) 292-3710 | LOCATION: CLOVIS, CA | ADDRESS: 1450 HERNDON AVE., CLOVIS, CA 93611 | PROJECT NUMBER: 17052 | REVISED: 10/25/17 |
| SUPER PHONE: | PHONE: (559) 327-9000 | FAX: | FILE NAME: F:\MV7\EF\FD\17052 | DRAWN BY: AD REVISED BY: AD |

| | |
|--------------------|---------------|
| DRAWING NUMBER: 13 | SUBMITTAL SET |
|--------------------|---------------|

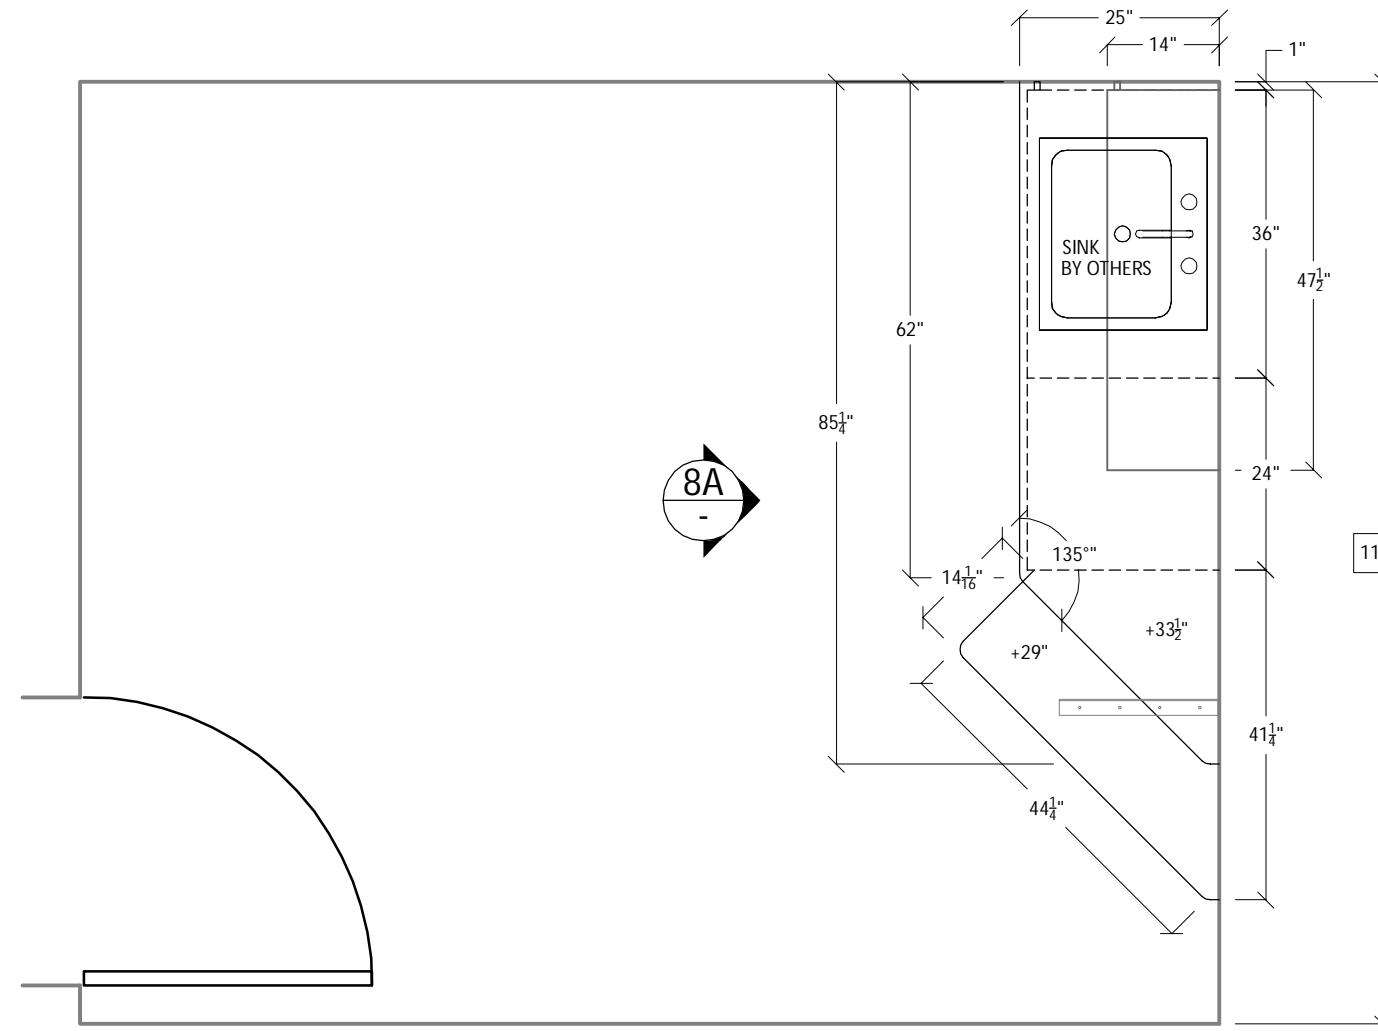


8

PLAN: EXAM ROOM 6 #E06

REF: ARCH. PAGE NO. A/A106

SCALE: $\frac{1}{2}''=1'-0''$

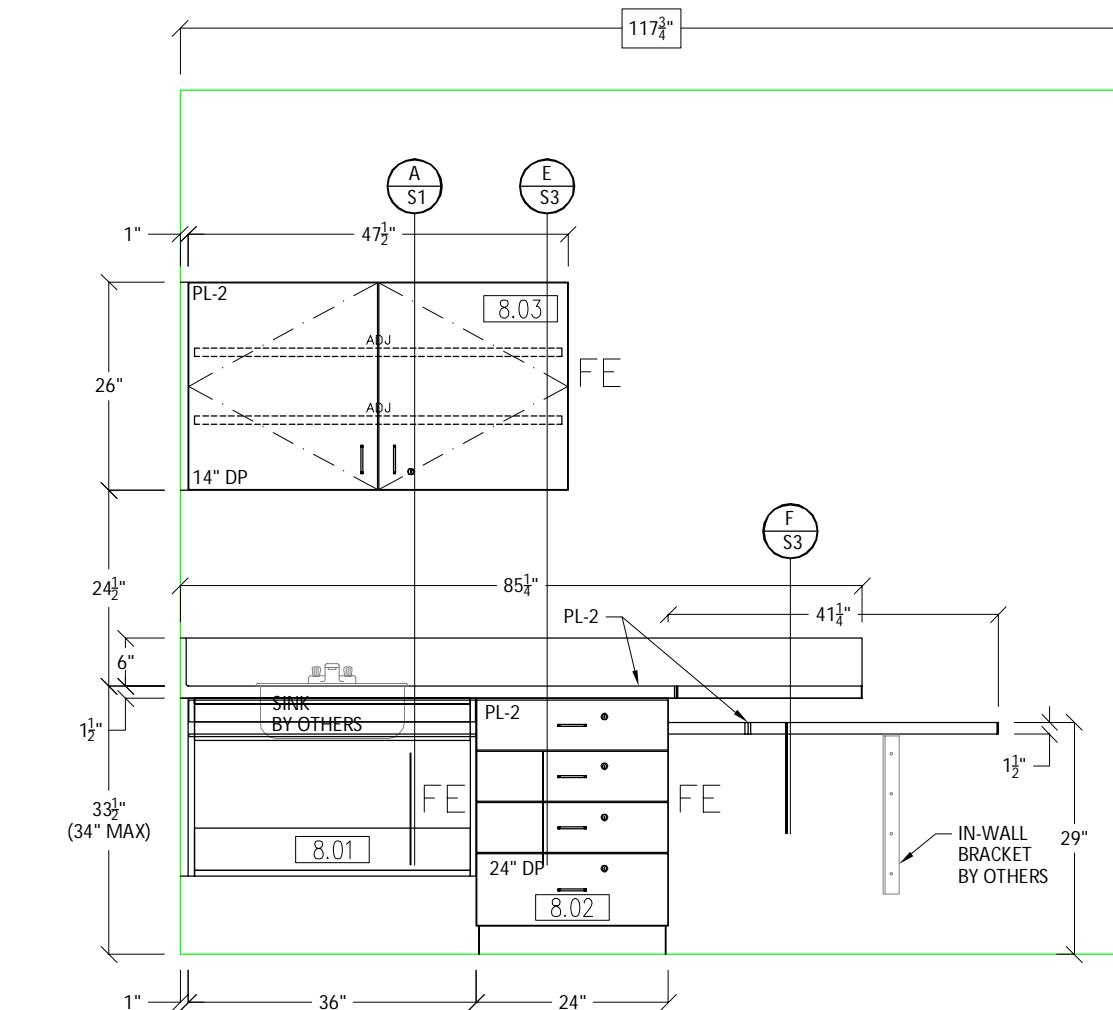

8A

ELEVATION: EXAM ROOM 6 #E06



REF: ARCH. PAGE NO. E/A601

SCALE: $\frac{1}{2}''=1'-0''$

IF SIZE OF SHEET IS NOT 11 X 17, SCALE ACCORDINGLY.

| | | | | |
|---|---|--|--------------------------|--------------------------------|
| EVERLAST WOODWORKING | PROJECT NAME: CUSD PROFESSIONAL LEARNING CENTER | CONTRACTOR/CLIENT NAME: CLOVIS UNIFIED SCHOOL DISTRICT | SCALE: | DATE: |
| 2555 N. Argyle, Fresno, California 93727 (559) 292-2448 - FAX (559) 292-3710 | LOCATION: CLOVIS, CA | ADDRESS: 1450 HERNDON AVE., CLOVIS, CA 93611 | PROJECT NUMBER: 17052 | 09/22/17 REVISED: 10/25/17 |
| SUPER PHONE: | PHONE: (559) 327-9000 | FAX: | DRAWING NUMBER: 14 | DRAWN BY: AD REVISED BY: AD |

| | |
|----------------------------------|--------------------------------|
| FILE NAME: F:\MV7\EF\FD\17052 | DRAWN BY: AD REVISED BY: AD |
| DRAWING NUMBER: 14 | SUBMITTAL SET |

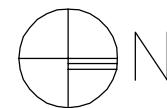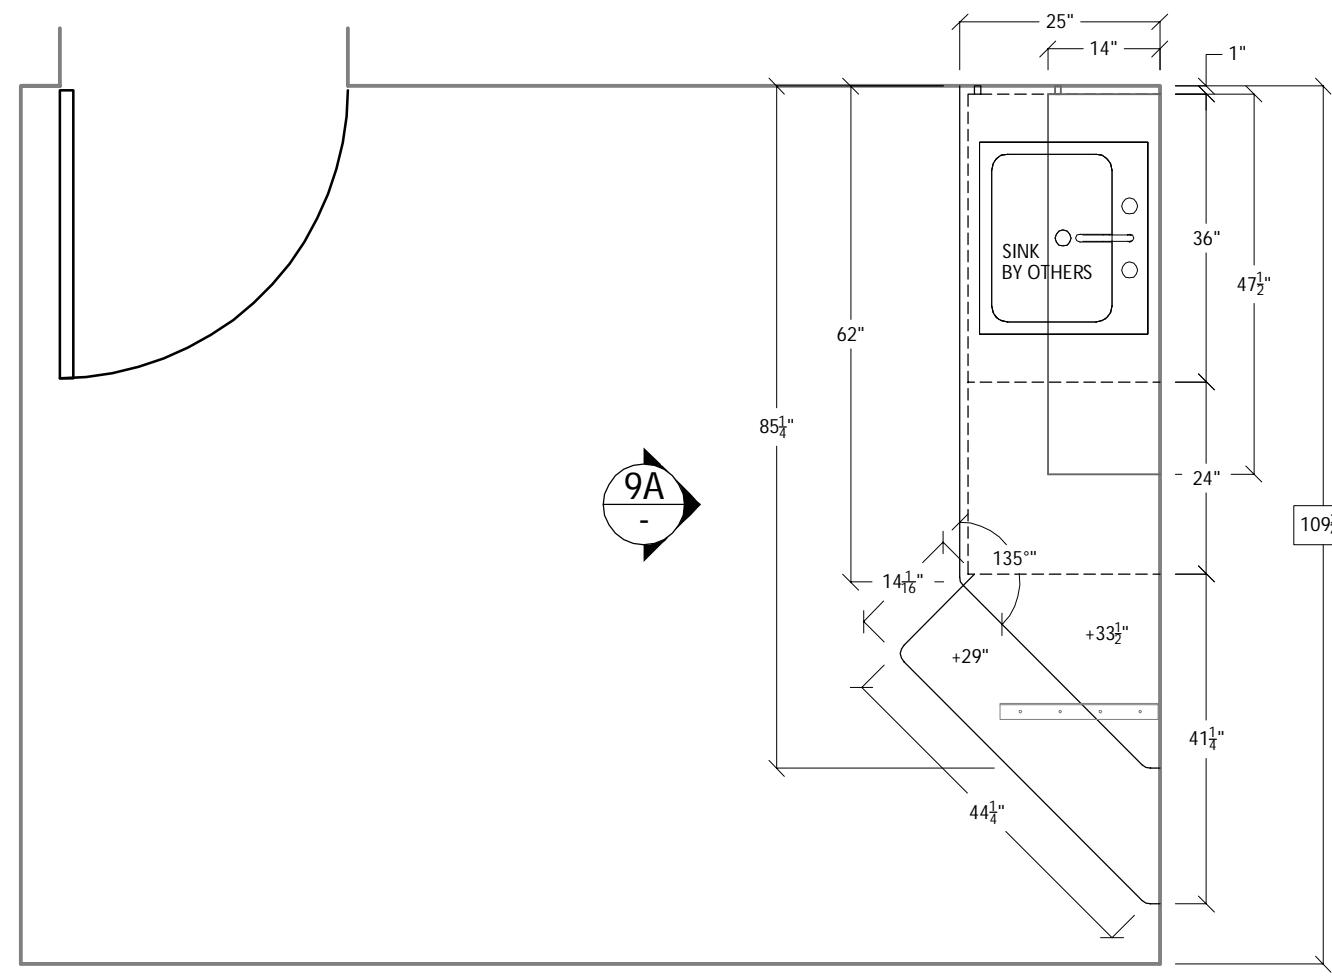


9

PLAN: EXAM ROOM 7 #E07

REF: ARCH. PAGE NO. A/A106

SCALE: $\frac{1}{2}'' = 1'-0''$

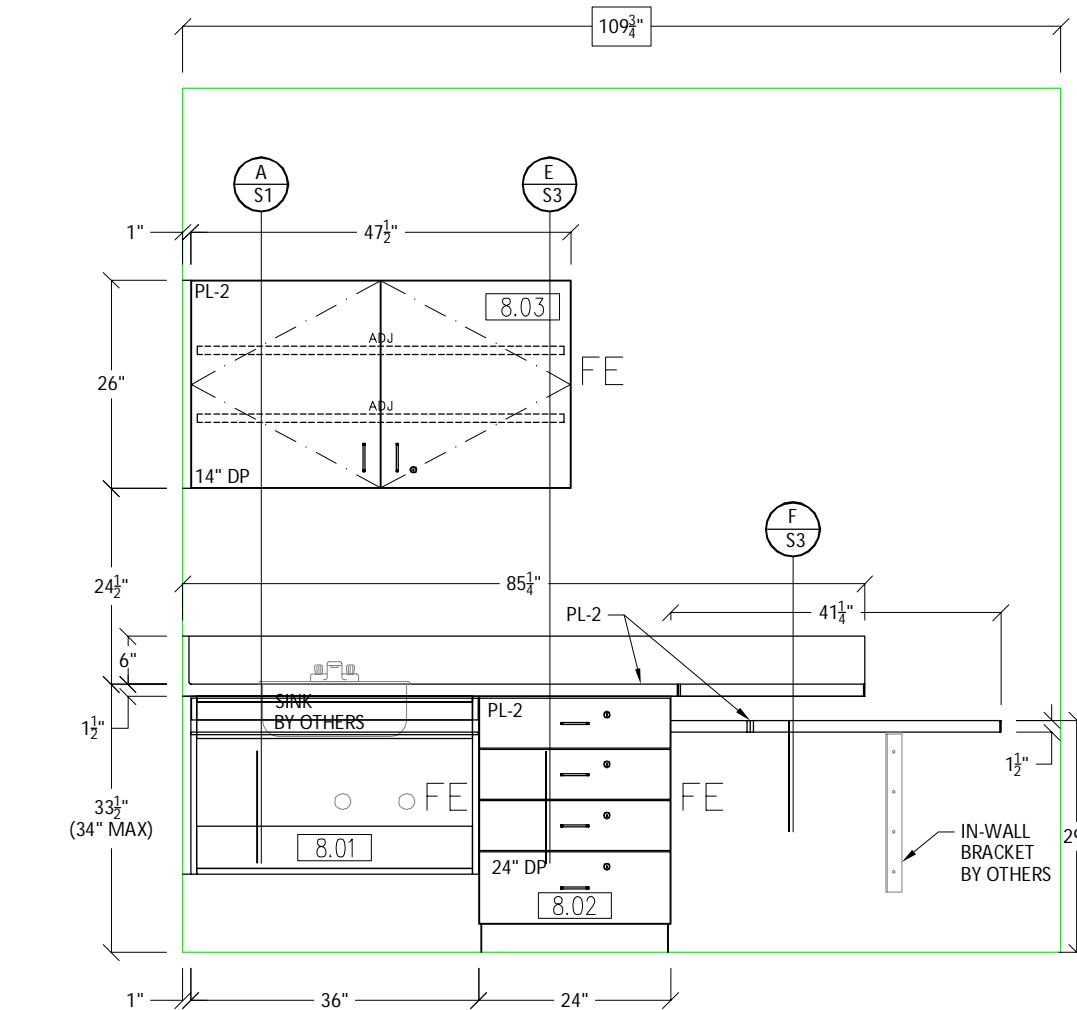

9A

ELEVATION: EXAM ROOM 7 #E07



REF: ARCH. PAGE NO. E/A601

SCALE: $\frac{1}{2}'' = 1'-0''$

IF SIZE OF SHEET IS NOT 11 X 17, SCALE ACCORDINGLY.

| | | | | |
|---|---|--|-----------------------|-----------------------------|
| EVERLAST WOODWORKING | PROJECT NAME: CUSD PROFESSIONAL LEARNING CENTER | CONTRACTOR/CLIENT NAME: CLOVIS UNIFIED SCHOOL DISTRICT | SCALE: | DATE: 09/22/17 |
| 2555 N. Argyle, Fresno, California 93727 (559) 292-2448 - FAX (559) 292-3710 | LOCATION: CLOVIS, CA | ADDRESS: 1450 HERNDON AVE., CLOVIS, CA 93611 | PROJECT NUMBER: 17052 | REVISED: 10/25/17 |
| SUPER PHONE: | PHONE: (559) 327-9000 | FAX: | DRAWING NUMBER: 15 | DRAWN BY: AD REVISED BY: AD |

| | |
|-------------------------------|---------------|
| FILE NAME: F:\MV7\EF\FD\17052 | DRAWN BY: AD |
| DRAWING NUMBER: 15 | SUBMITTAL SET |

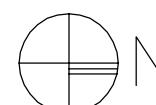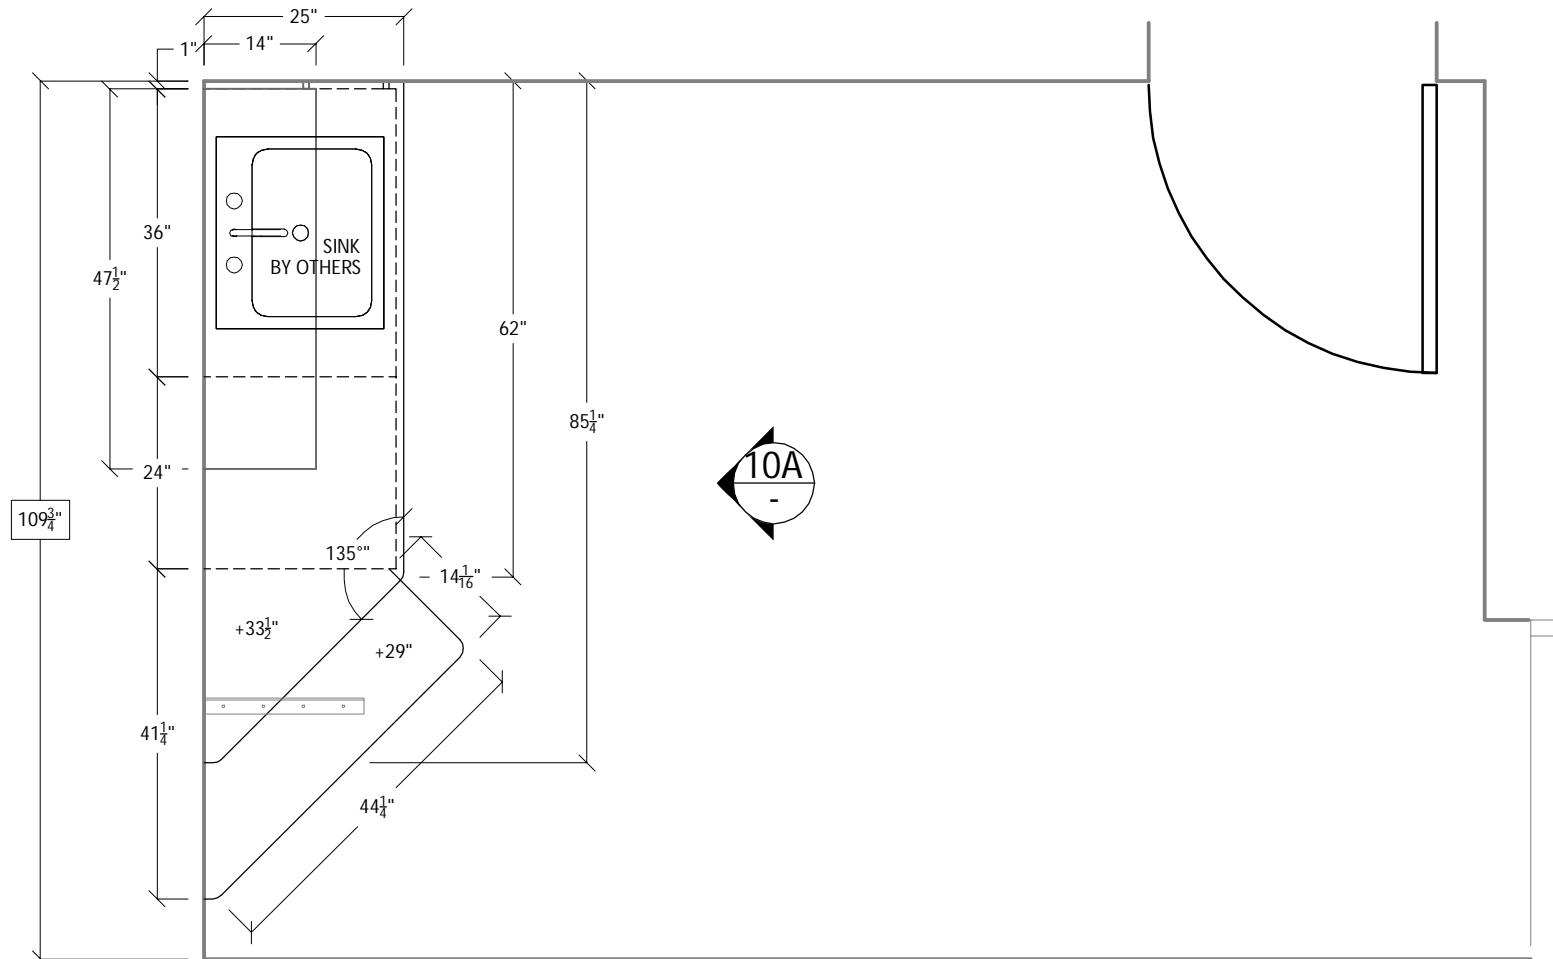


10 PLAN: EXAM ROOM 8 #E08

REF: ARCH. PAGE NO. A/A106

SCALE: $\frac{1}{2}'' = 1'-0''$



2555 N. Argyle, Fresno, California 93727
(559) 292-2448 - FAX (559) 292-3710

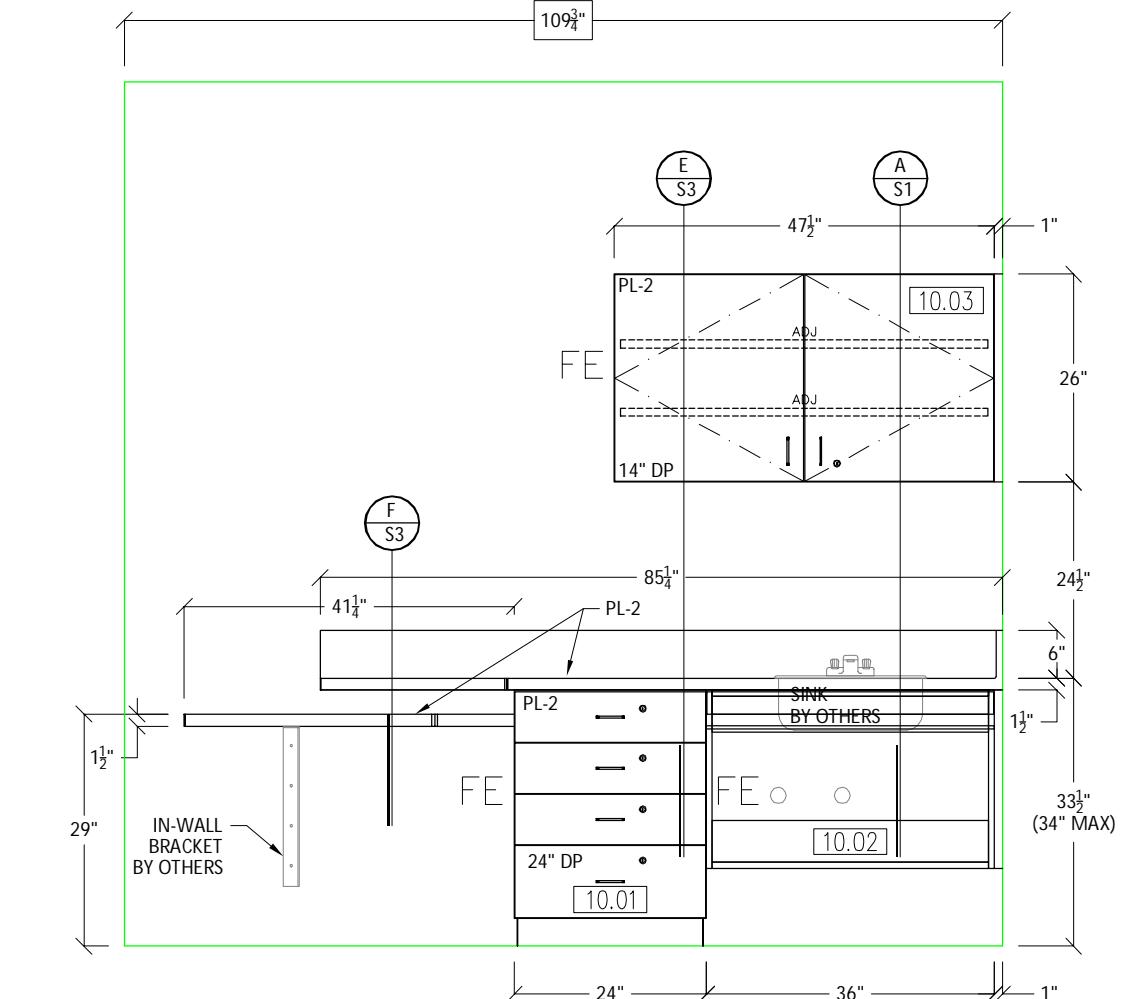

10A ELEVATION: EXAM ROOM 8 #E08

REF: ARCH. PAGE NO. E/A602



SCALE: $\frac{1}{2}'' = 1'-0''$

IF SIZE OF SHEET IS NOT 11 X 17, SCALE ACCORDINGLY.

| | | |
|--|---|---|
| PROJECT NAME: CUSD PROFESSIONAL LEARNING CENTER | CONTRACTOR/CLIENT NAME: CLOVIS UNIFIED SCHOOL DISTRICT | SCALE: |
| LOCATION: CLOVIS, CA | ADDRESS: 1450 HERNDON AVE., CLOVIS, CA 93611 | PROJECT NUMBER: 17052 |
| SUPER PHONE: | PHONE: (559) 327-9000 FAX: | FILE NAME: F:\MV7\EF\FD\17052 |
| | | DRAWN BY: AD REVISED BY: AD |

| | |
|----------------------------|---------------------------|
| PHONE: (559) 327-9000 FAX: | DRAWING NUMBER: 16 |
|----------------------------|---------------------------|

| |
|----------------------|
| SUBMITTAL SET |
|----------------------|

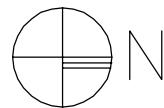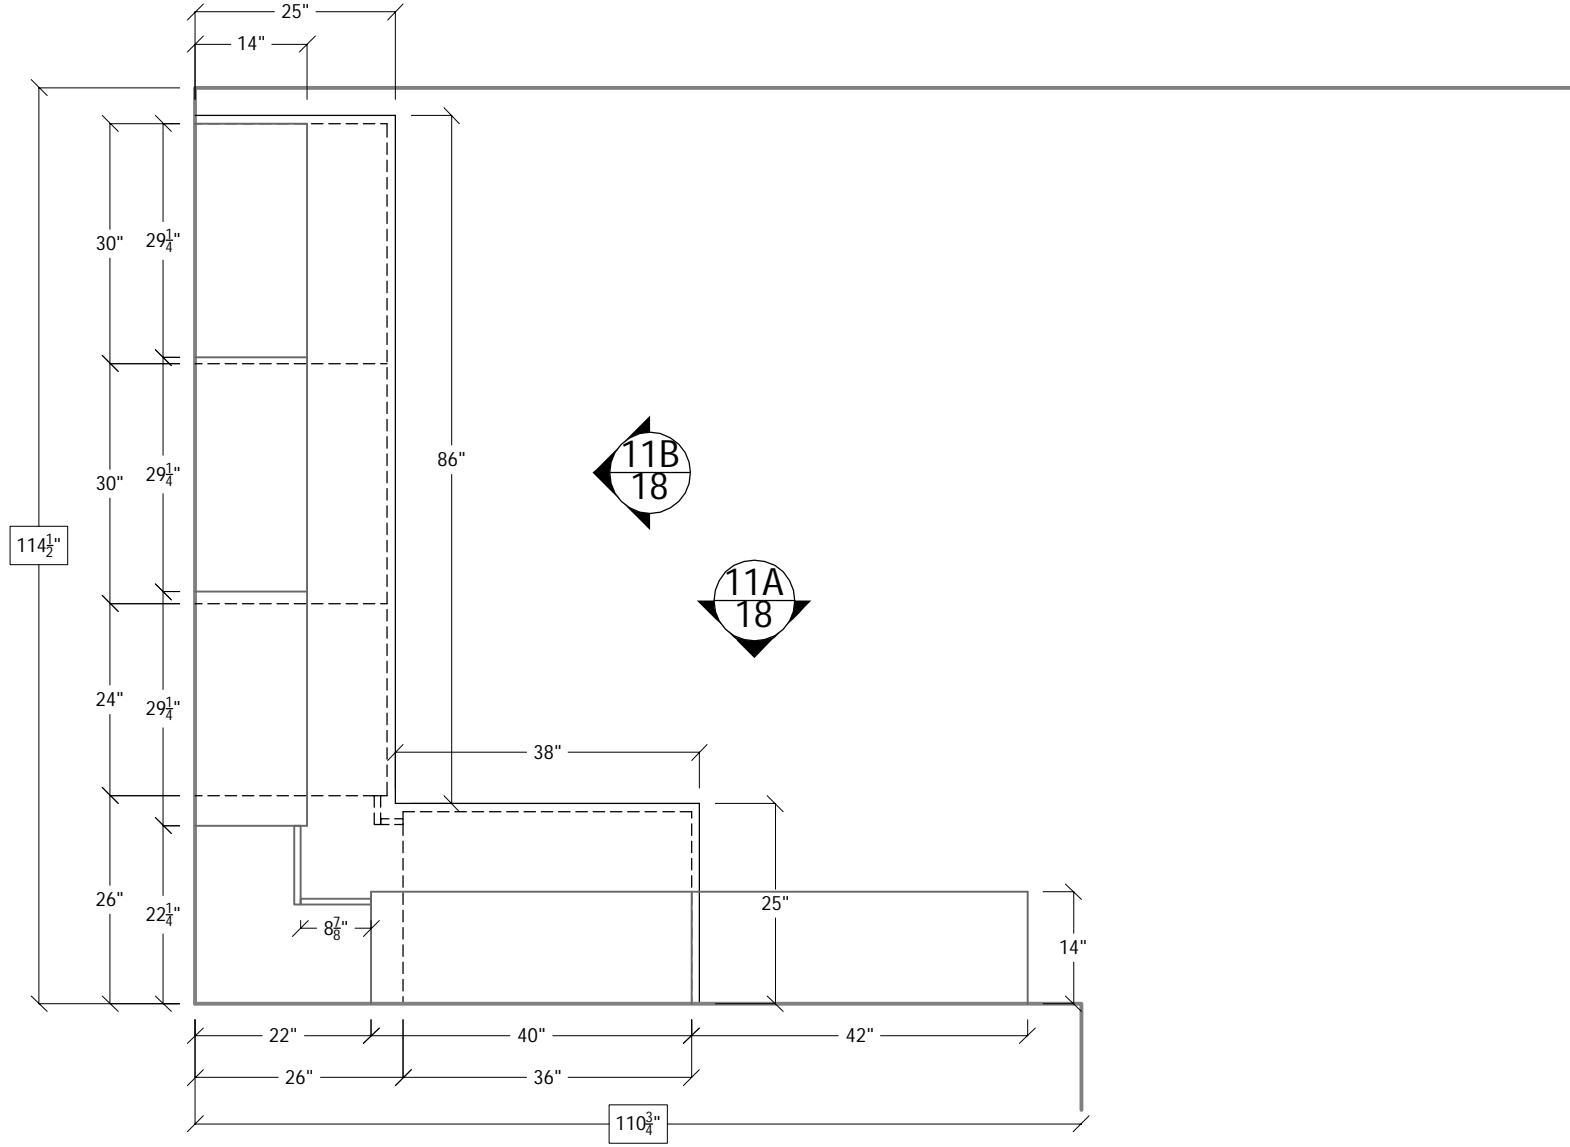

11

PLAN: BREAK ROOM #E19


REF: ARCH. PAGE NO. A/A106

SCALE: $\frac{1}{2}$ "=1'-0"

IF SIZE OF SHEET IS NOT 11 X 17, SCALE ACCORDINGLY.

| |
|---|
| EVERLAST WOODWORKING |
| 2555 N. Argyle, Fresno, California 93727 (559) 292-2448 - FAX (559) 292-3710 |


| | | | |
|--|---|---|---|
| PROJECT NAME: CUSD PROFESSIONAL LEARNING CENTER | CONTRACTOR/CLIENT NAME: CLOVIS UNIFIED SCHOOL DISTRICT | SCALE: | DATE: |
| LOCATION: CLOVIS, CA | ADDRESS: 1450 HERNDON AVE., CLOVIS, CA 93611 | PROJECT NUMBER: 17052 | REVISED: 10/25/17 |
| SUPER PHONE: | PHONE: (559) 327-9000 FAX: | FILE NAME: F:\MV7\EF\FD\17052 | DRAWN BY: AD REVISED BY: AD |
| | | DRAWING NUMBER: 17 | SUBMITTAL SET |

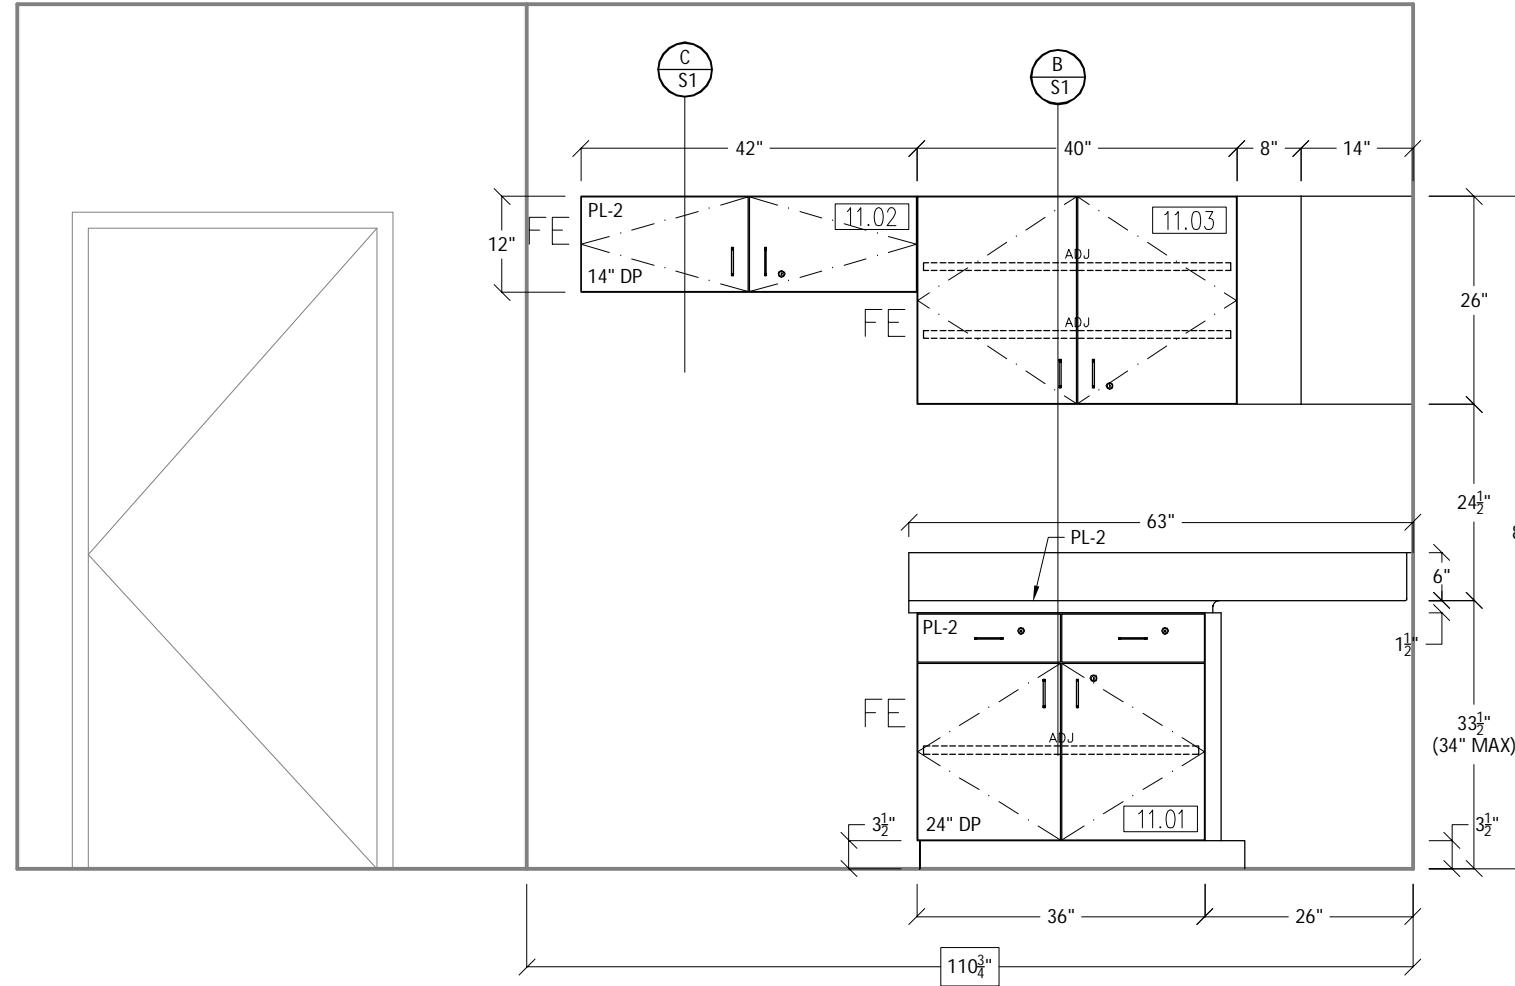

11A ELEVATION: BREAK ROOM #E19

REF: ARCH. PAGE NO. E19/A603

SCALE: $\frac{1}{2}'' = 1'-0''$

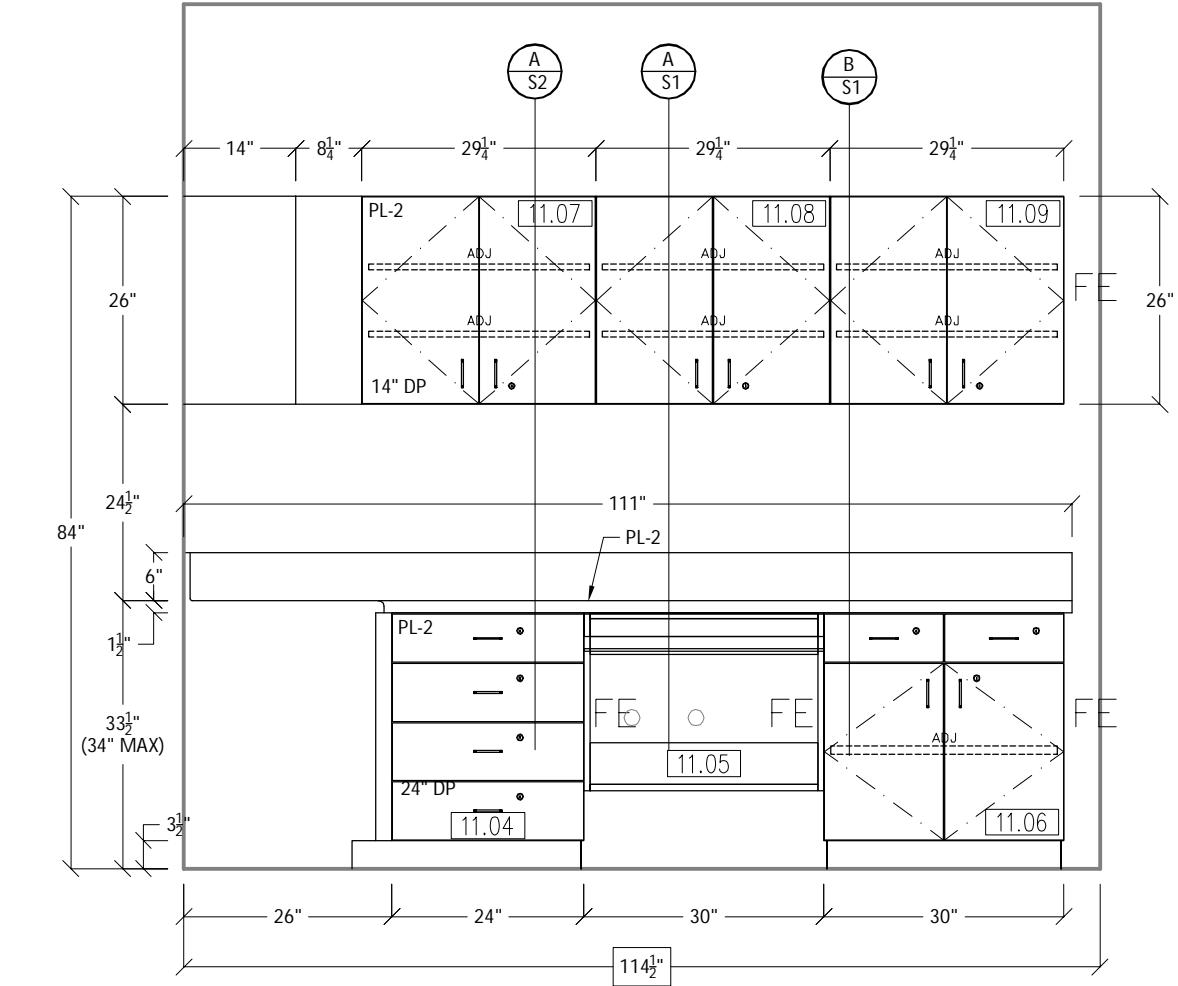

11B ELEVATION: BREAK ROOM #E19

REF: ARCH. PAGE NO. E/A603

SCALE: $\frac{1}{2}'' = 1'-0''$

IF SIZE OF SHEET IS NOT 11 X 17, SCALE ACCORDINGLY.




2555 N. Argyle, Fresno, California 93727
(559) 292-2448 - FAX (559) 292-3710

PROJECT
NAME:
CUSD PROFESSIONAL LEARNING CENTER
LOCATION:
CLOVIS, CA
SUPER PHONE:

CONTRACTOR/CLIENT
NAME:
CLOVIS UNIFIED SCHOOL DISTRICT
ADDRESS:
1450 HERNDON AVE., CLOVIS, CA 93611
PHONE: (559) 327-9000 FAX:

| SCALE: | DATE: |
|-------------------------------|-------------------|
| PROJECT NUMBER: 17052 | 09/22/17 |
| FILE NAME: F:\MV7\EF\FD\17052 | REVISED: 10/25/17 |
| DRAWN BY: AD | REVISED BY: AD |
| SUBMITTAL SET | |

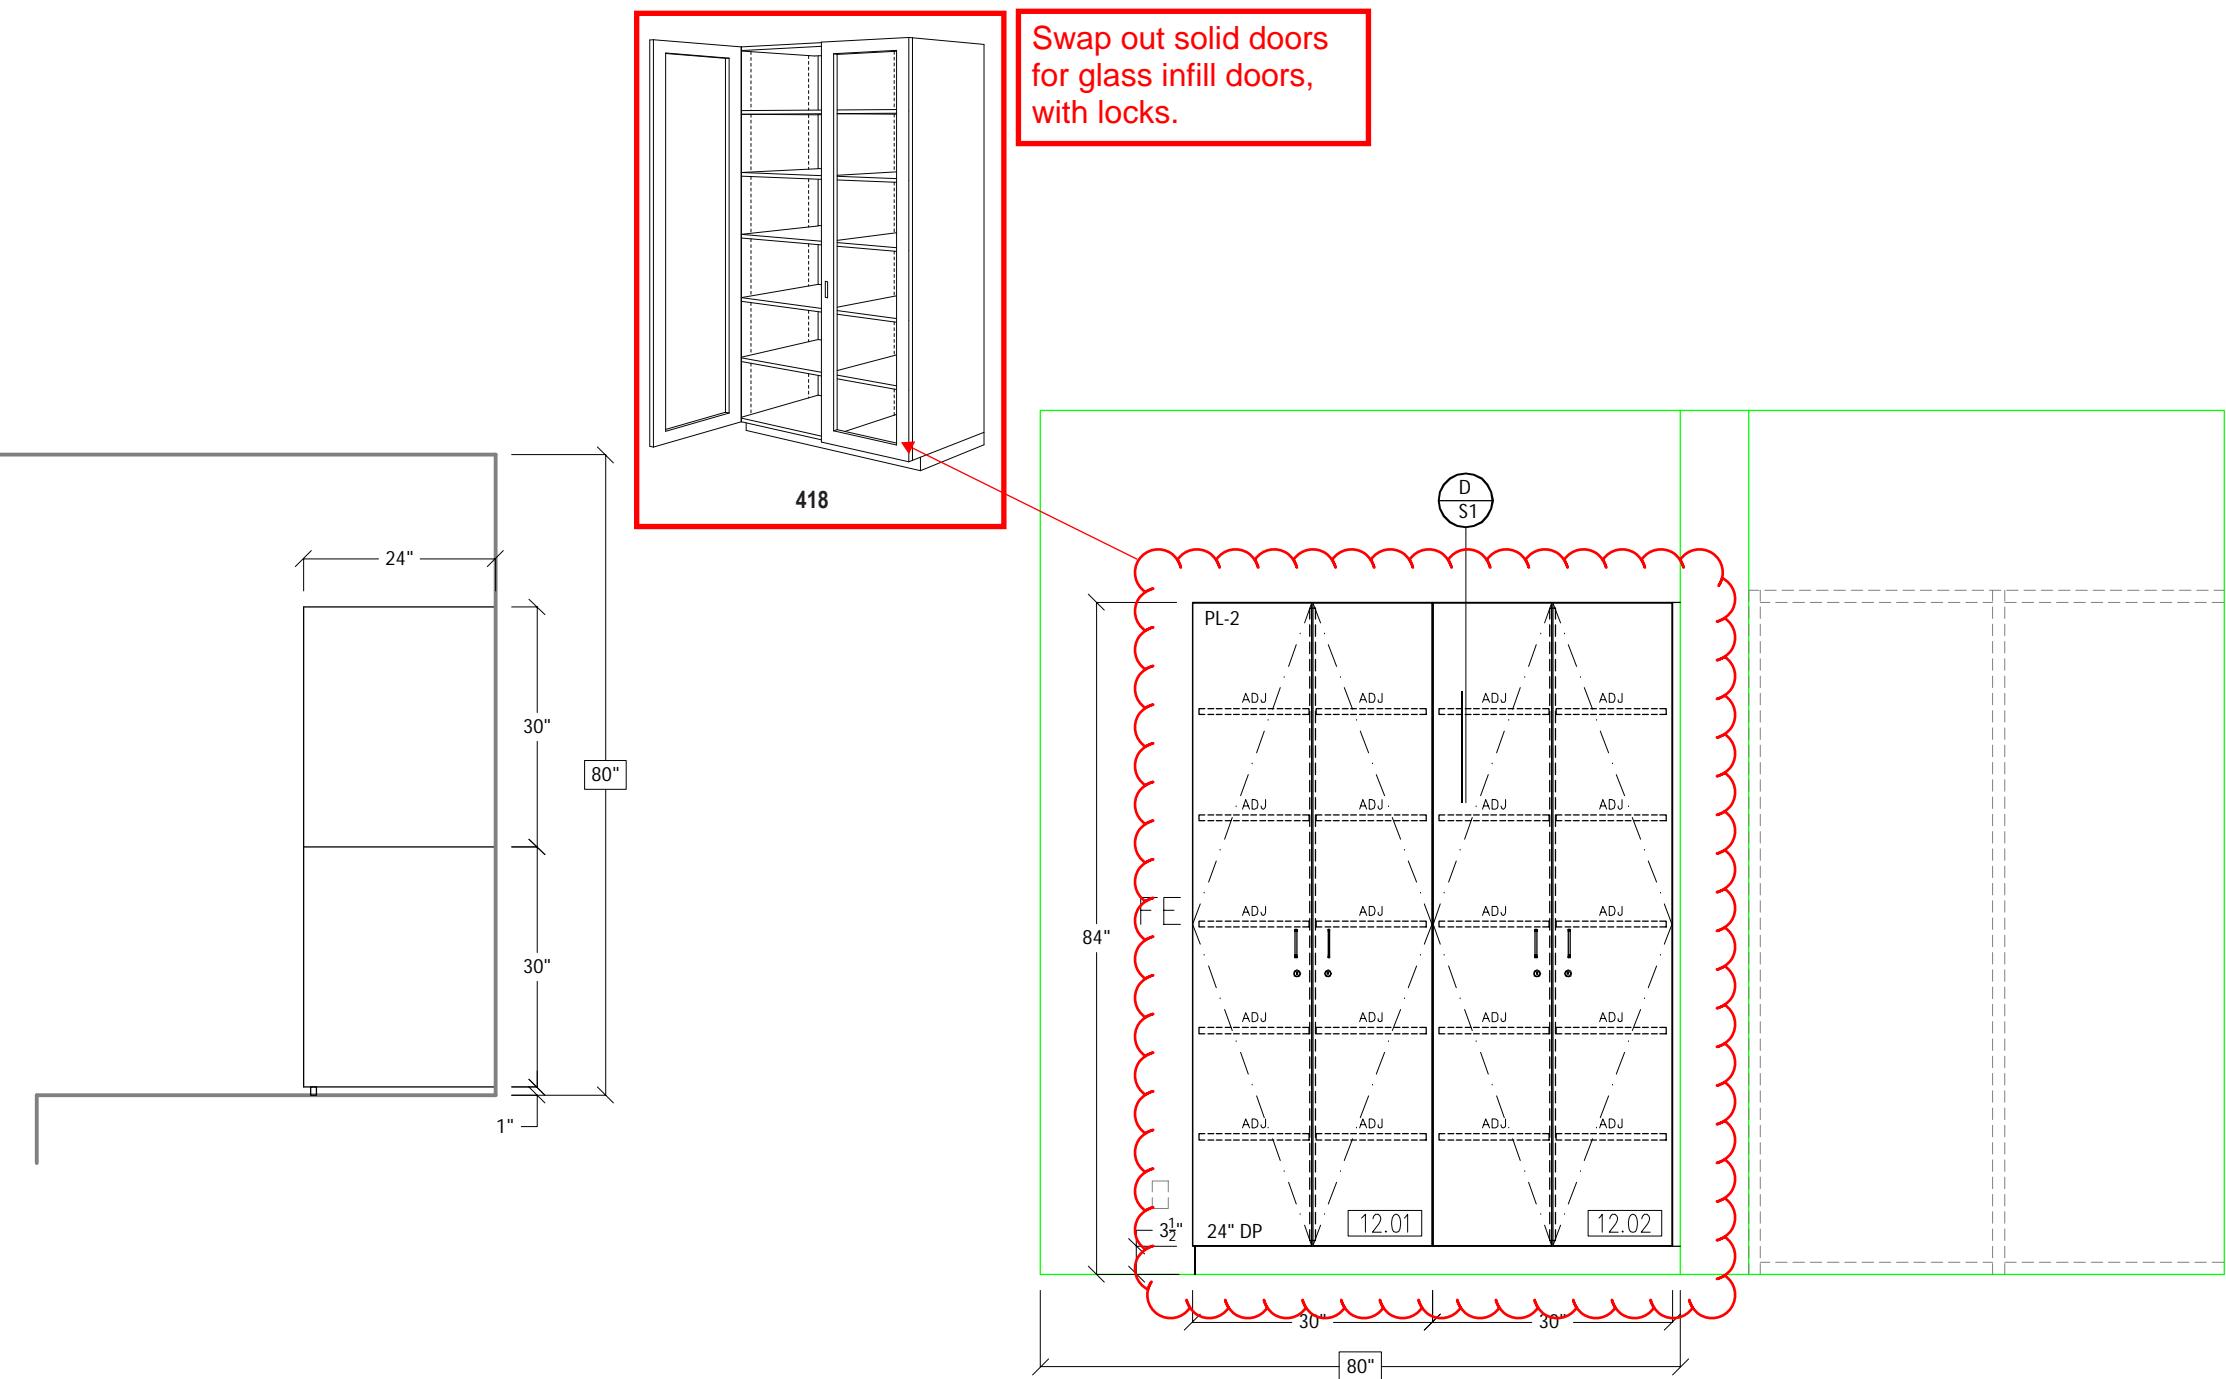

12

PLAN: CLINICIANS OFFICE #E12

REF: ARCH. PAGE NO. A/A106

SCALE: $\frac{1}{2}$ " = 1'-0"

EVERLAST
WOODWORKING

2555 N. Argyle, Fresno, California 93727
(559) 292-2448 - FAX (559) 292-3710

12A



ELEVATION: CLINICIANS OFFICE #E12

REF: ARCH. PAGE NO. E/A602

SCALE: $\frac{1}{2}$ " = 1'-0"

IF SIZE OF SHEET IS NOT 11 X 17, SCALE ACCORDINGLY.

| | | | |
|---|--|-------------------------------|-----------------------------|
| PROJECT NAME: CUSD PROFESSIONAL LEARNING CENTER | CONTRACTOR/CLIENT NAME: CLOVIS UNIFIED SCHOOL DISTRICT | SCALE: | DATE: |
| | | PROJECT NUMBER: 17052 | REVISED: 10/25/17 |
| LOCATION: CLOVIS, CA | ADDRESS: 1450 HERNDON AVE., CLOVIS, CA 93611 | FILE NAME: F:\MV7\EF\FD\17052 | DRAWN BY: AD REVISED BY: AD |
| SUPER PHONE: | PHONE: (559) 327-9000 FAX: | DRAWING NUMBER: 19 | SUBMITTAL SET |

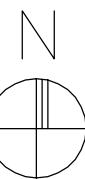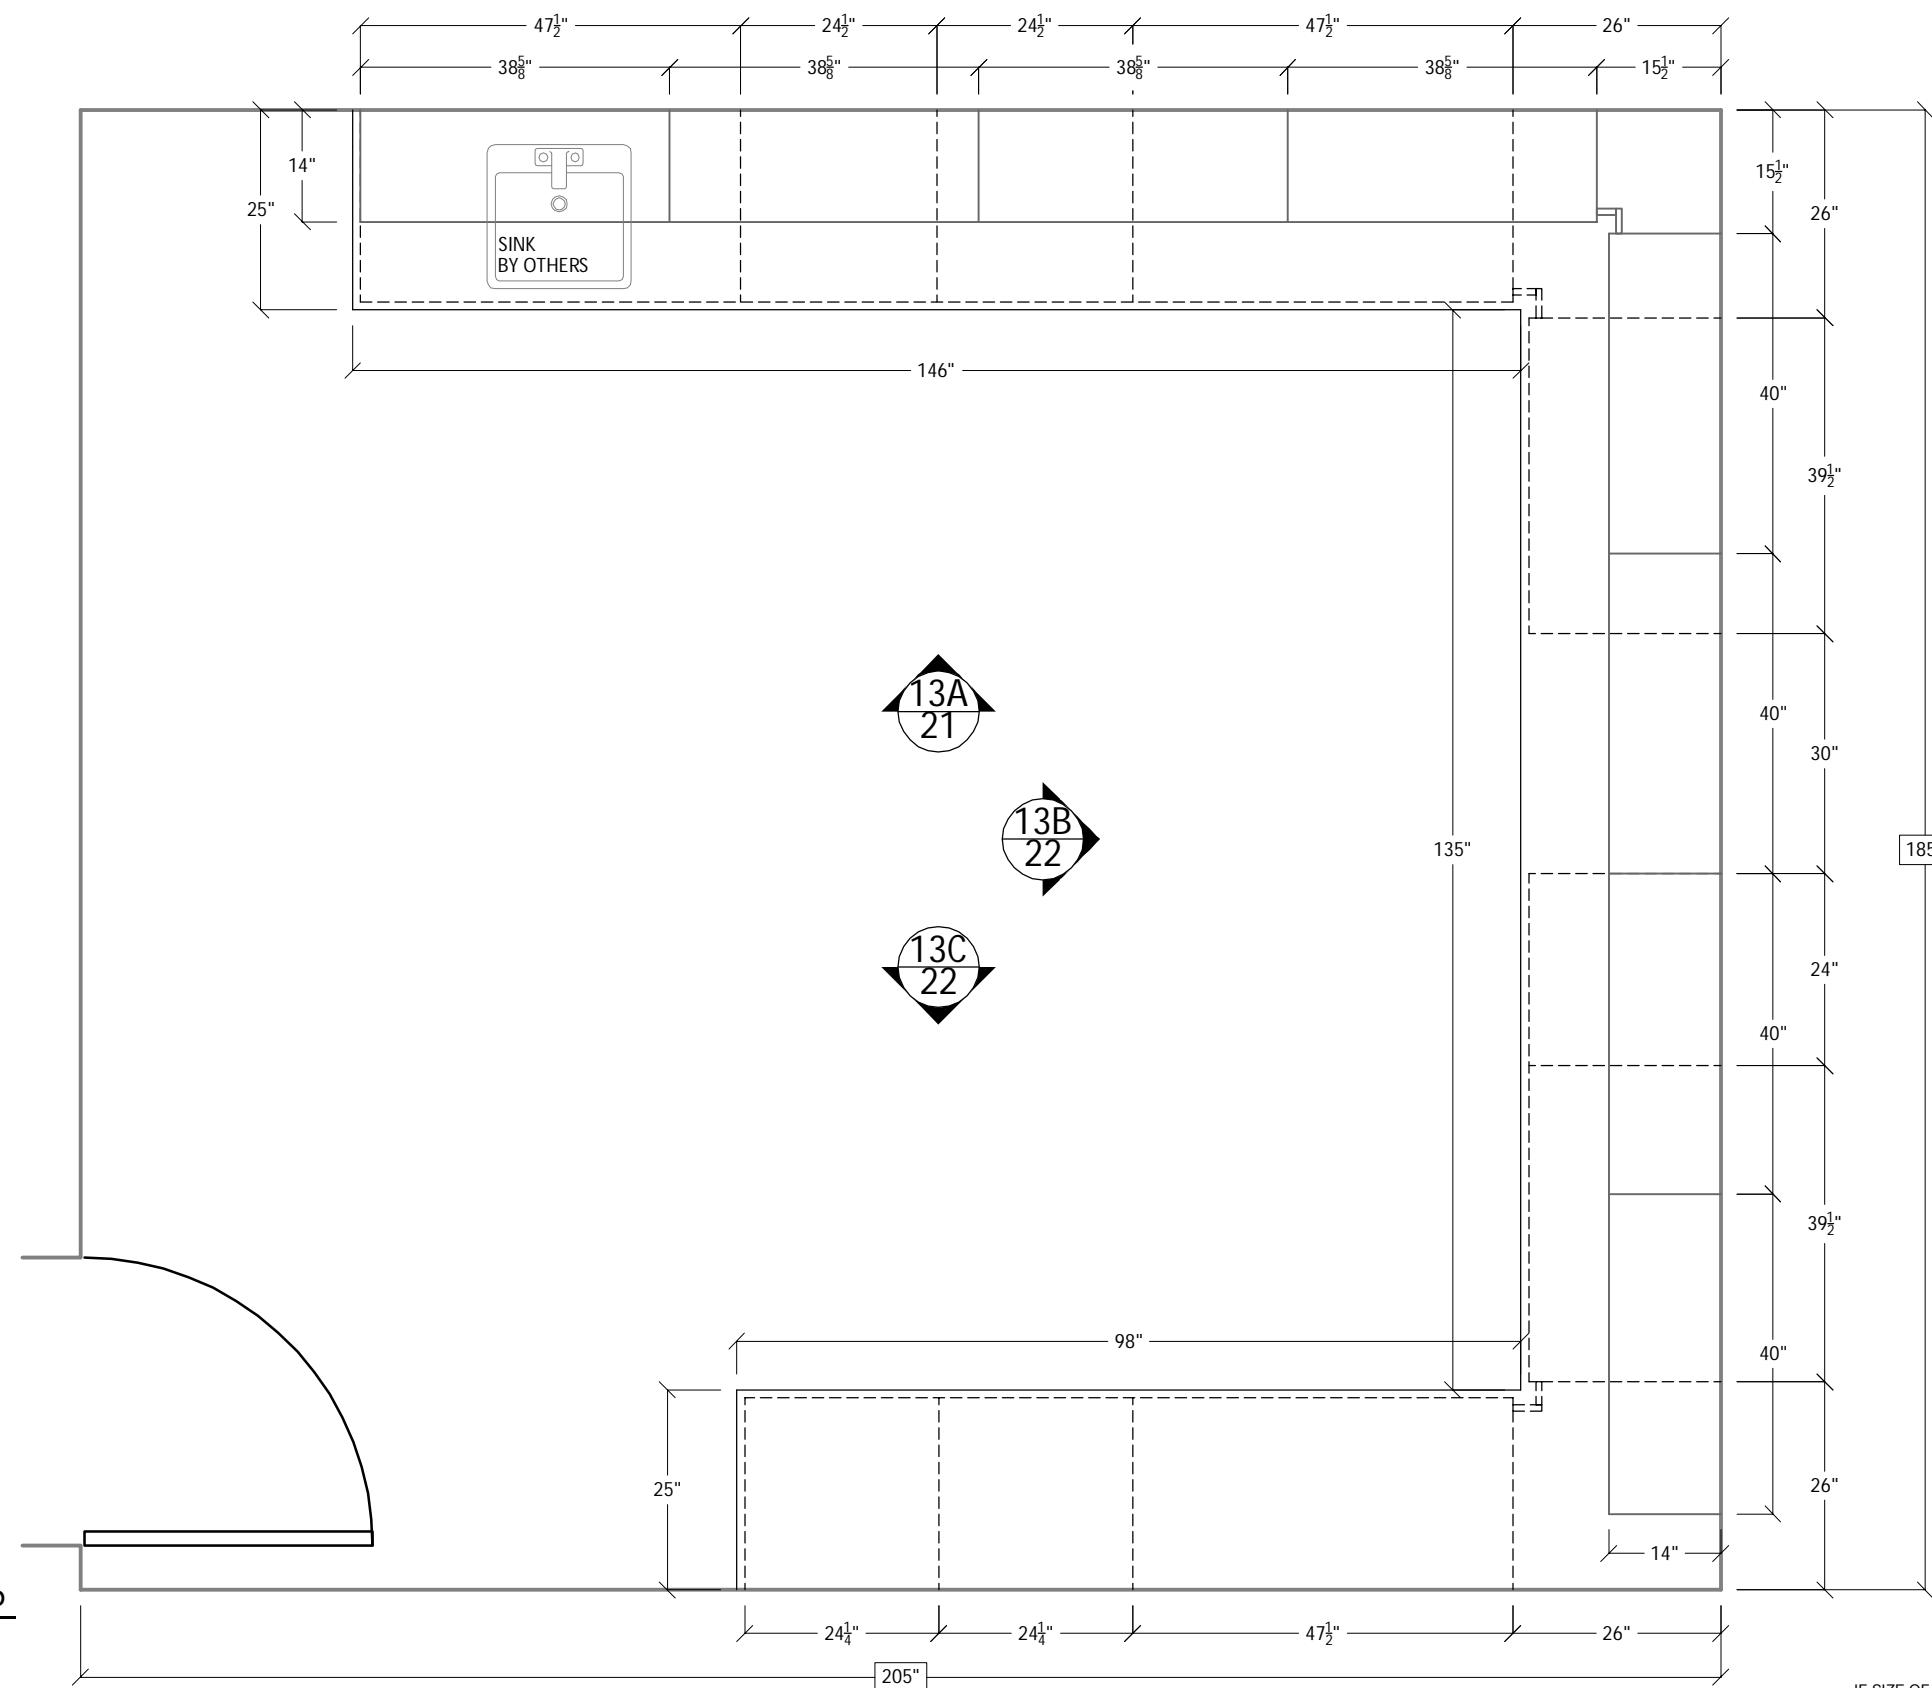


13 PLAN: LAB AREA #E16

REF: ARCH. PAGE NO. A/A106
SCALE: $\frac{1}{2}$ "=1'-0"

IF SIZE OF SHEET IS NOT 11 X 17, SCALE ACCORDINGLY.

| |
|---|
| EVERLAST WOODWORKING |
| 2555 N. Argyle, Fresno, California 93727 (559) 292-2448 - FAX (559) 292-3710 |

| | | | |
|--|---|---|--|
| PROJECT NAME: CUSD PROFESSIONAL LEARNING CENTER | CONTRACTOR/CLIENT NAME: CLOVIS UNIFIED SCHOOL DISTRICT | SCALE: PROJECT NUMBER: 17052 | DATE: REVISED: 09/22/17 |
| LOCATION: CLOVIS, CA | ADDRESS: 1450 HERNDON AVE., CLOVIS, CA 93611 | FILE NAME: F:\MV7\EF\FD\17052 | DRAWN BY: REVISED BY: AD AD |
| SUPER PHONE: | PHONE: (559) 327-9000 FAX: | DRAWING NUMBER: 20 | SUBMITTAL SET |

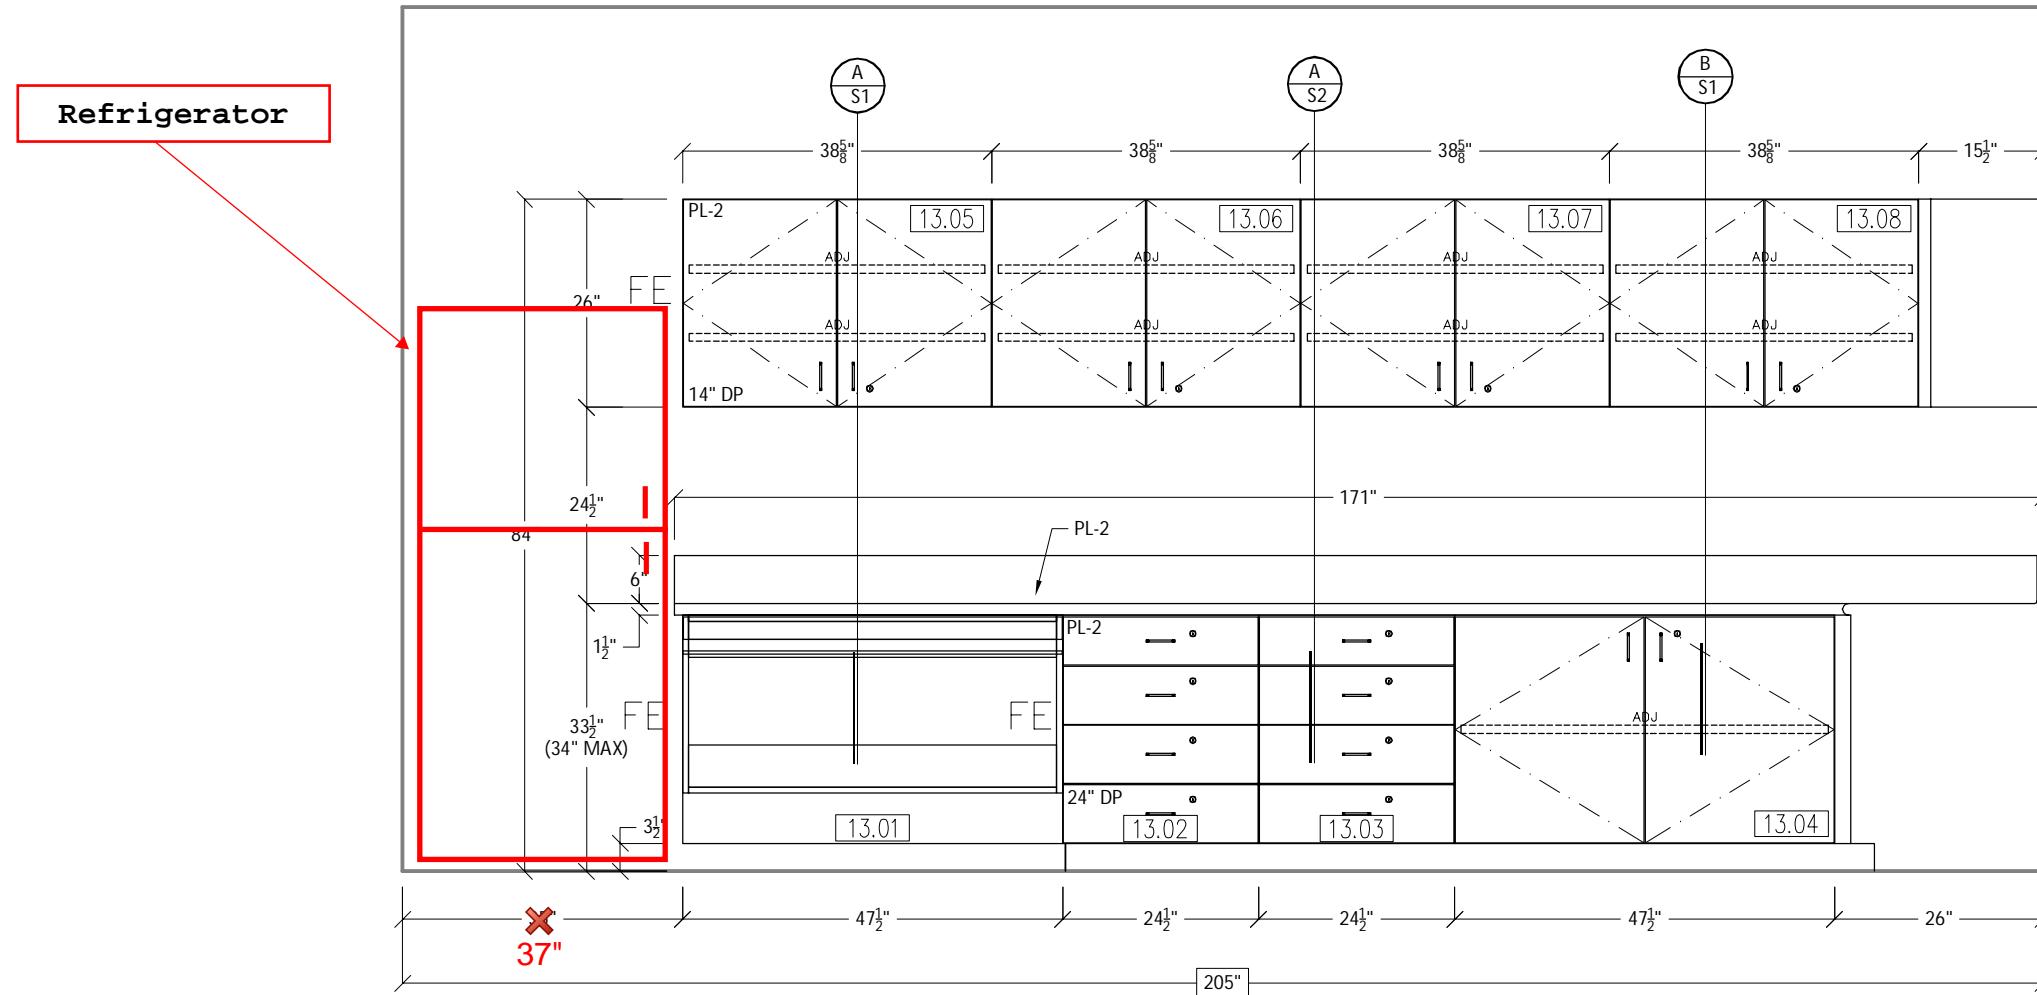

13A

ELEVATION: LAB AREA #E16


REF: ARCH. PAGE NO. E/A603

SCALE: $\frac{1}{2}$ "=1'-0"

IF SIZE OF SHEET IS NOT 11 X 17, SCALE ACCORDINGLY.

**EVERLAST
WOODWORKING**
2555 N. Argyle, Fresno, California 93727
(559) 292-2448 - FAX (559) 292-3710


| | | | |
|--|---|----------------------------------|----------------------|
| PROJECT NAME: CUSD PROFESSIONAL LEARNING CENTER | CONTRACTOR/CLIENT NAME: CLOVIS UNIFIED SCHOOL DISTRICT | SCALE: | DATE: |
| | | PROJECT NUMBER: 17052 | REVISED: 10/25/17 |
| LOCATION: CLOVIS, CA | ADDRESS: 1450 HERNDON AVE., CLOVIS, CA 93611 | FILE NAME: F:\MV7\EF\FD\17052 | DRAWN BY: AD |
| SUPER PHONE: | PHONE: (559) 327-9000 FAX: | DRAWING NUMBER: 21 | REVISED BY: AD |
| | | | SUBMITTAL SET |

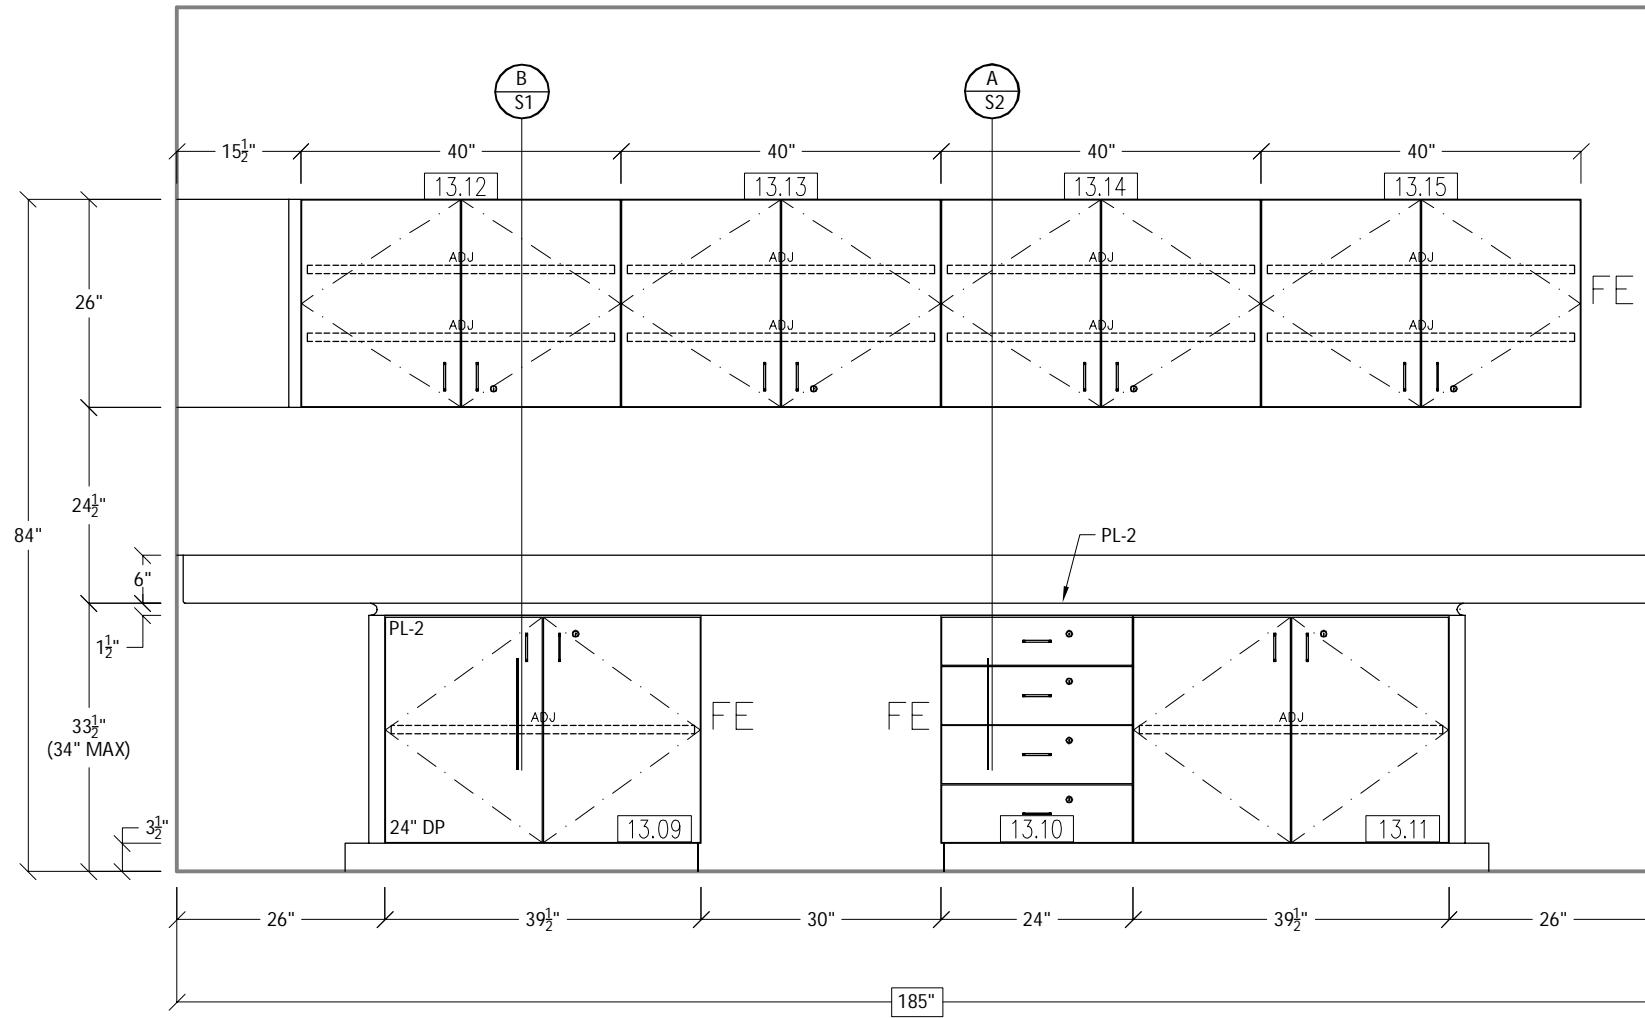

13B ELEVATION: LAB AREA #E16

REF: ARCH. PAGE NO. E/A603

SCALE: $\frac{1}{2}'' = 1'-0''$

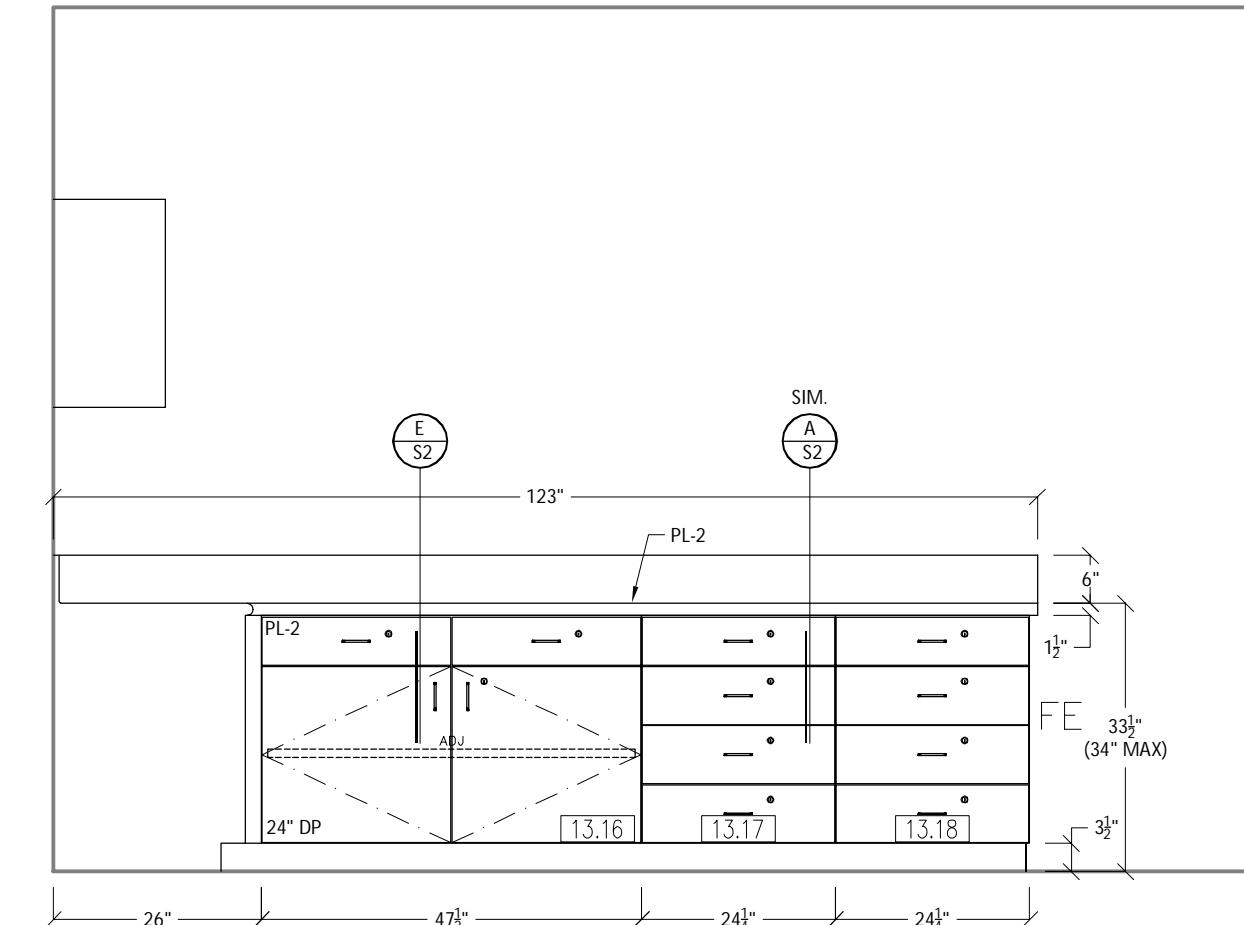


13C ELEVATION: LAB AREA #E16

REF: ARCH. PAGE NO. E/A603

SCALE: $\frac{1}{2}'' = 1'-0''$

IF SIZE OF SHEET IS NOT 11 X 17, SCALE ACCORDINGLY.

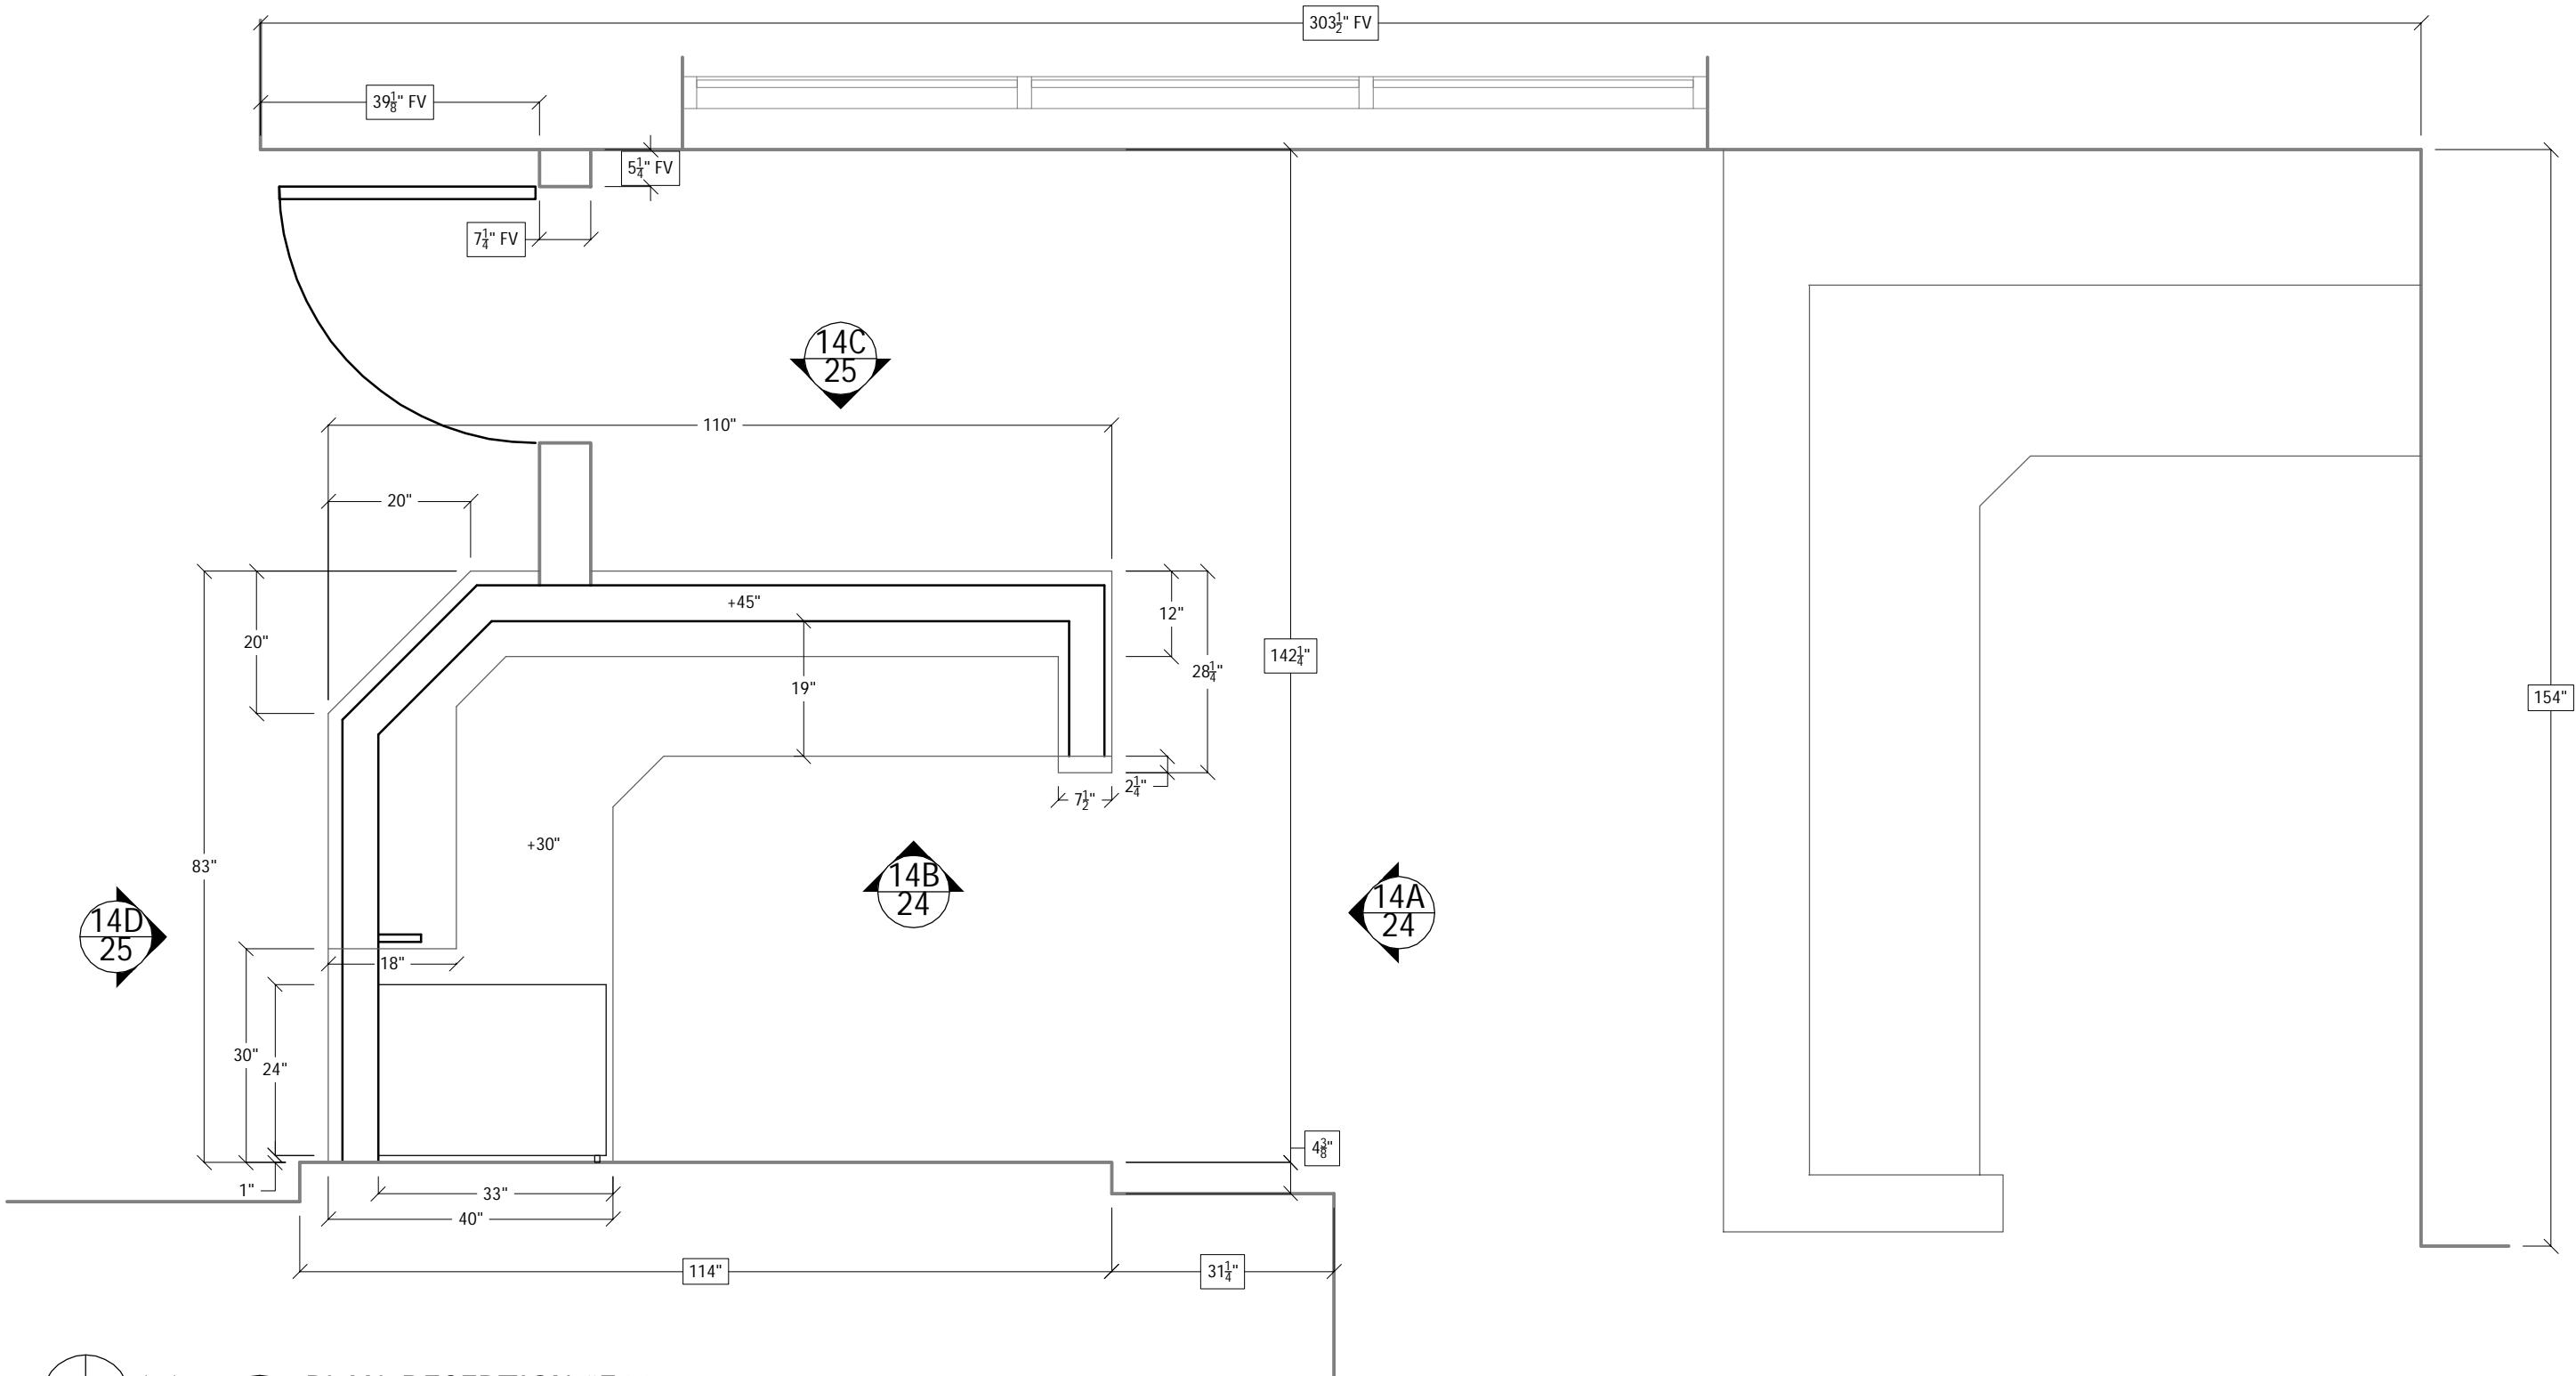

14

PLAN: RECEPTION #E11

REF: ARCH. PAGE NO. A/A106, X/A302

SCALE: $\frac{1}{2}'' = 1'-0''$


IF SIZE OF SHEET IS NOT 11 X 17, SCALE ACCORDINGLY.

**EVERLAST
WOODWORKING**
2555 N. Argyle, Fresno, California 93727
(559) 292-2448 - FAX (559) 292-3710

PROJECT
NAME:
CUSD PROFESSIONAL LEARNING CENTER
LOCATION:
CLOVIS, CA
SUPER PHONE:

CONTRACTOR/CLIENT
NAME:
CLOVIS UNIFIED SCHOOL DISTRICT
ADDRESS:
1450 HERNDON AVE., CLOVIS, CA 93611
PHONE: (559) 327-9000 FAX:


| SCALE: | DATE: |
|-------------------------------|-------------------|
| PROJECT NUMBER: 17052 | 09/22/17 |
| FILE NAME: F:\MV7\EF\FD\17052 | REVISED: 10/25/17 |
| DRAWN BY: AD | REVISED BY: AD |
| SUBMITTAL SET | |

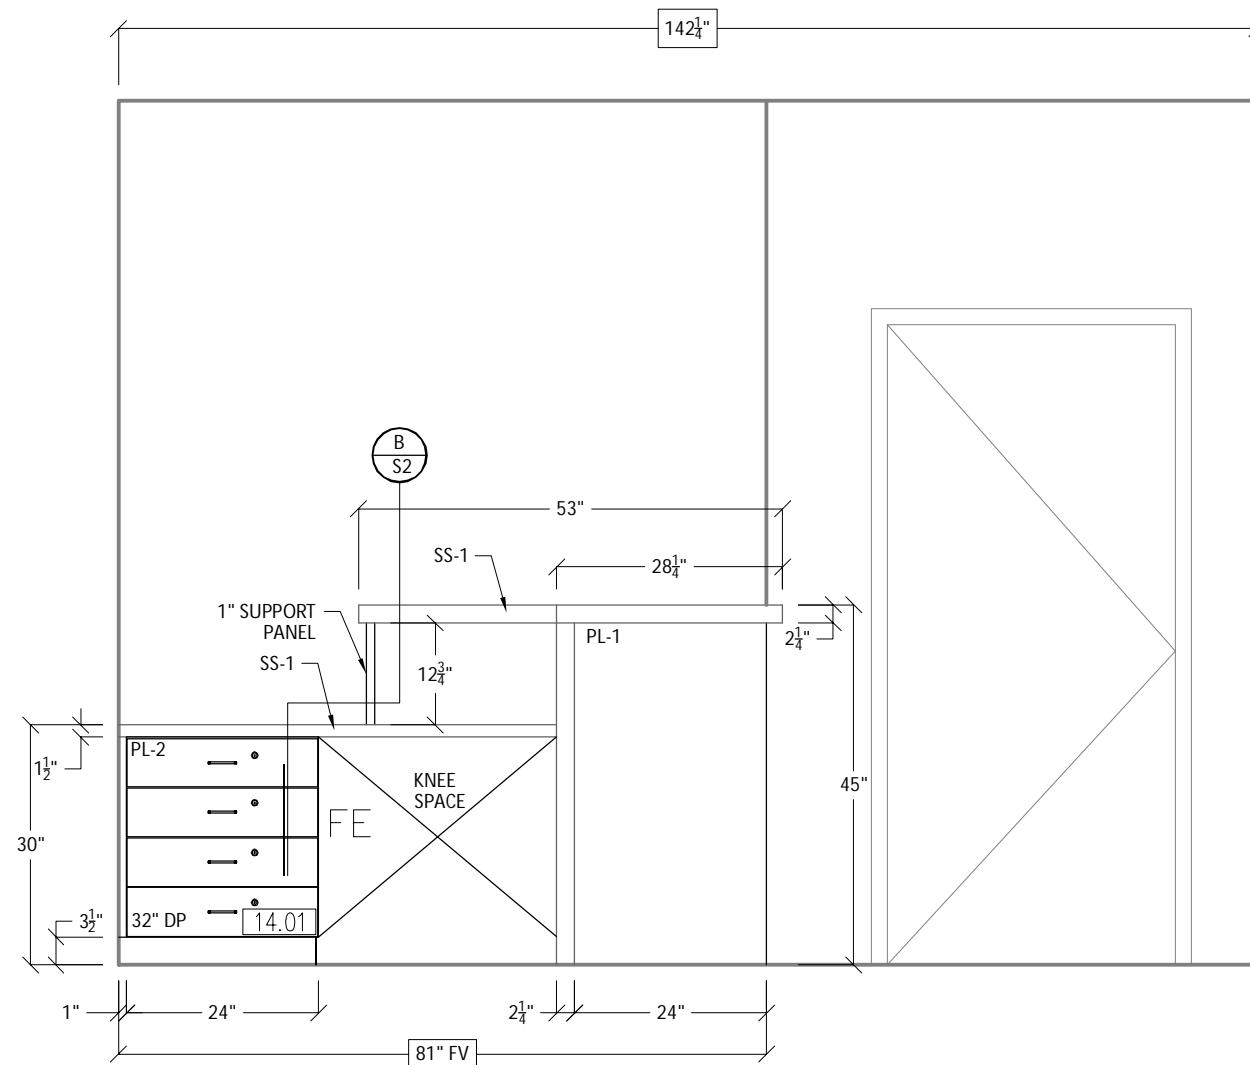

14A ELEVATION: RECEPTION #E11

REF: ARCH. PAGE NO. X/A303

SCALE: $\frac{1}{2}'' = 1'-0''$

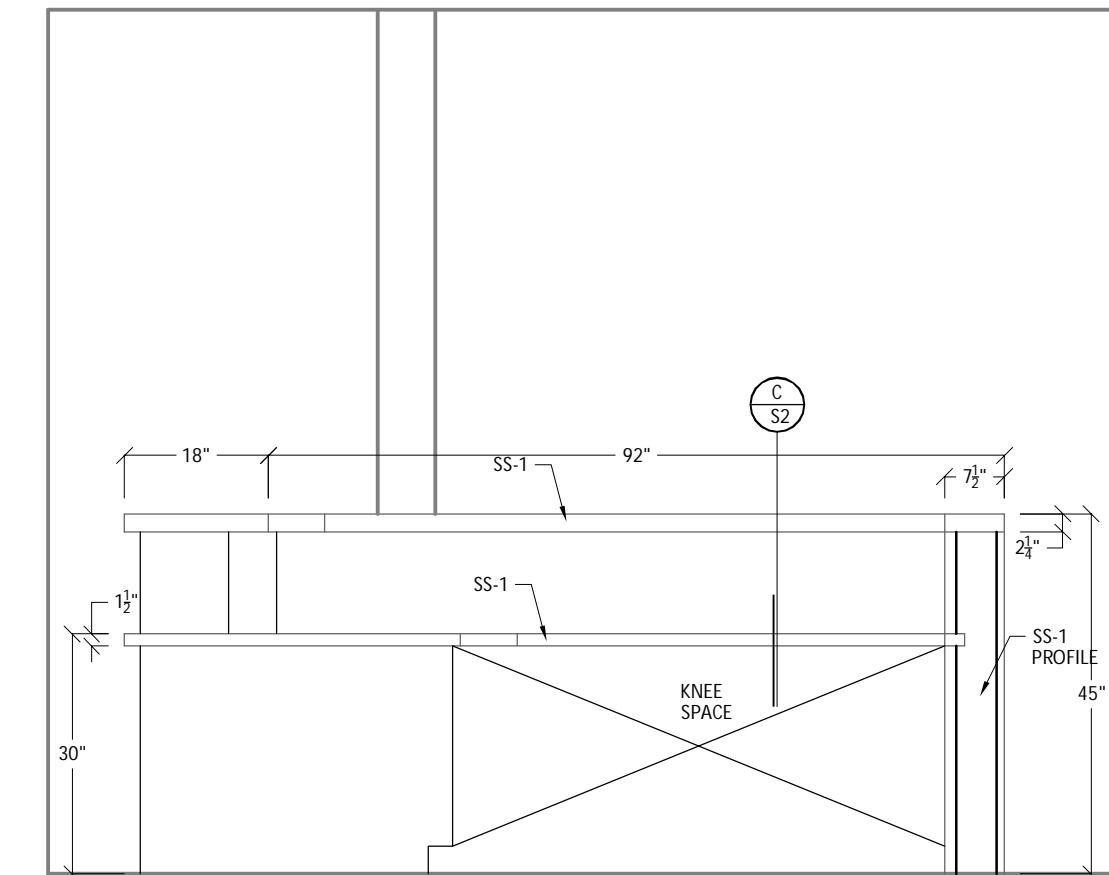

14B ELEVATION: RECEPTION #E11

REF: ARCH. PAGE NO. X/A303

SCALE: $\frac{1}{2}'' = 1'-0''$


IF SIZE OF SHEET IS NOT 11 X 17, SCALE ACCORDINGLY.



2555 N. Argyle, Fresno, California 93727
(559) 292-2448 - FAX (559) 292-3710

| | |
|--|---|
| PROJECT NAME: CUSD PROFESSIONAL LEARNING CENTER | CONTRACTOR/CLIENT NAME: CLOVIS UNIFIED SCHOOL DISTRICT |
| LOCATION: CLOVIS, CA | ADDRESS: 1450 HERNDON AVE., CLOVIS, CA 93611 |
| SUPER PHONE: | PHONE: (559) 327-9000 FAX: |


| | |
|--------------------------------------|---|
| SCALE: | DATE: 09/22/17 |
| PROJECT NUMBER: | REVISED: 10/25/17 |
| FILE NAME: F:\MV7\EF\FD\17052 | DRAWN BY: AD REVISED BY: AD |
| DRAWING NUMBER: 24 | SUBMITTAL SET |

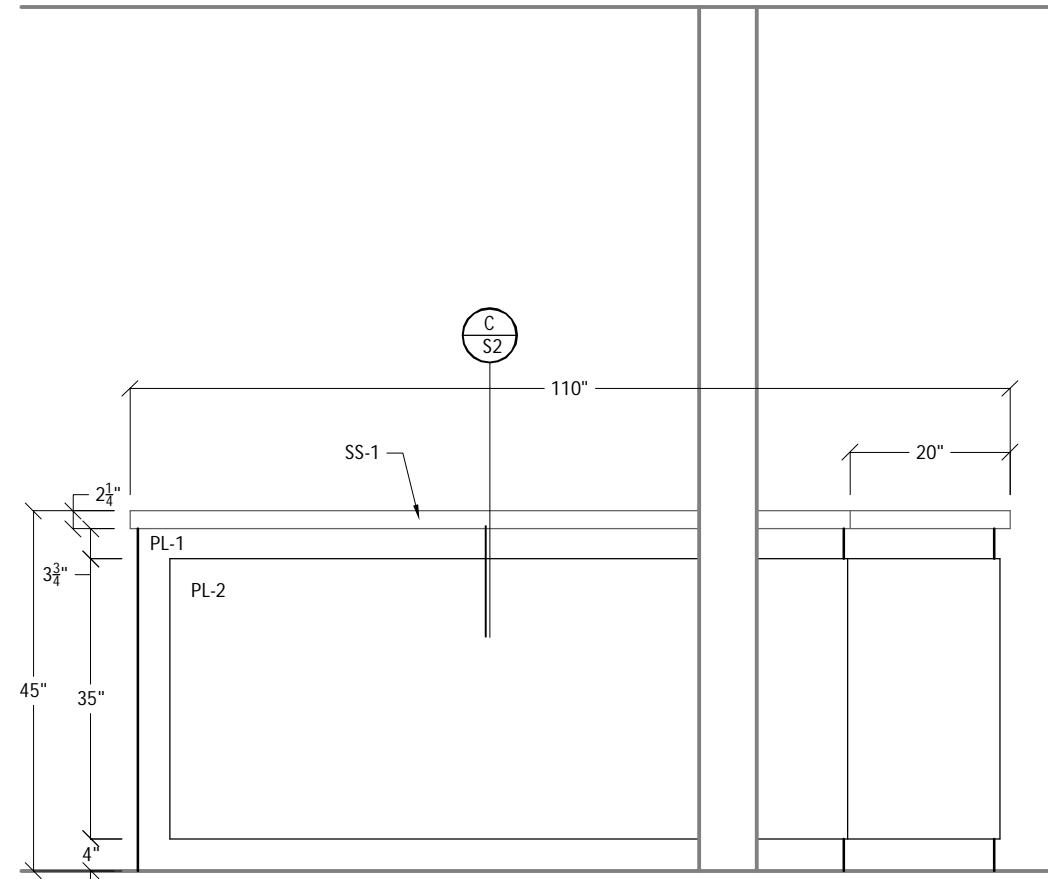

14C ELEVATION: RECEPTION #E11

REF: ARCH. PAGE NO. X/A303

SCALE: $\frac{1}{2}'' = 1'-0''$

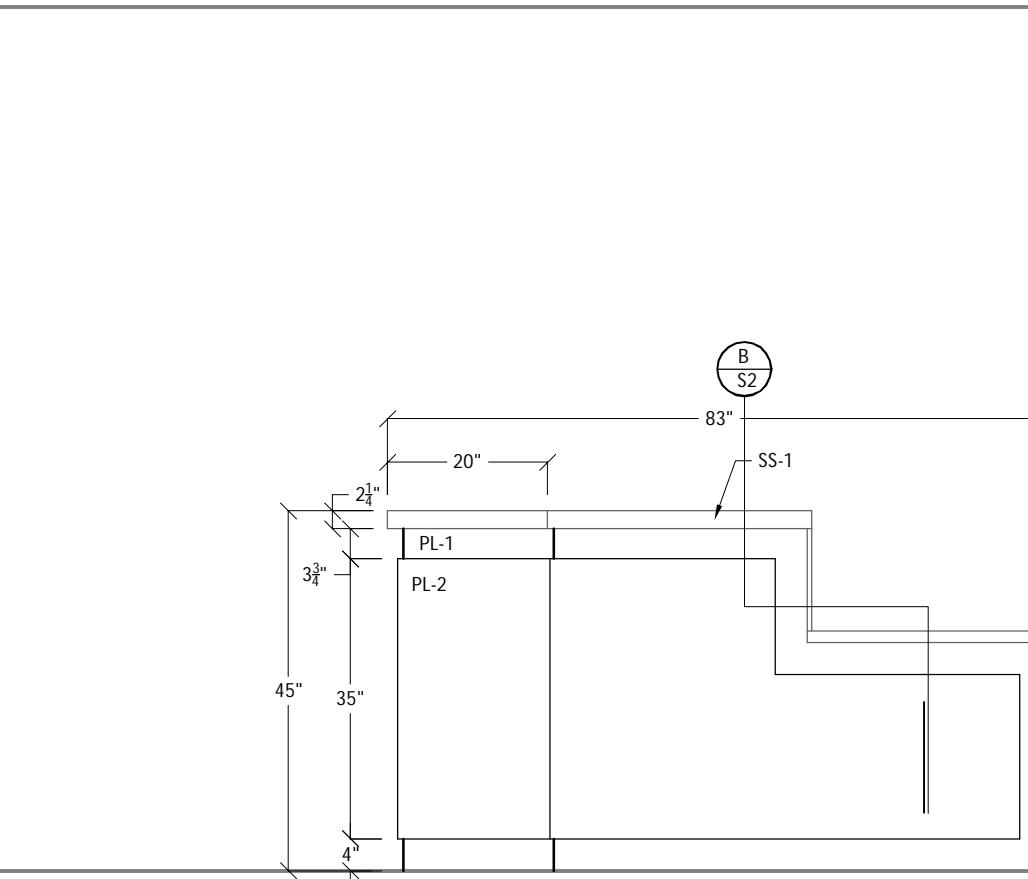

14D ELEVATION: RECEPTION #E11


REF: ARCH. PAGE NO. X/A303

SCALE: $\frac{1}{2}'' = 1'-0''$

IF SIZE OF SHEET IS NOT 11 X 17, SCALE ACCORDINGLY.

| |
|---|
| EVERLAST WOODWORKING |
| 2555 N. Argyle, Fresno, California 93727 (559) 292-2448 - FAX (559) 292-3710 |

| | | | |
|--|---|---|---|
| PROJECT NAME: CUSD PROFESSIONAL LEARNING CENTER | CONTRACTOR/CLIENT NAME: CLOVIS UNIFIED SCHOOL DISTRICT | SCALE: | DATE: 09/22/17 |
| LOCATION: CLOVIS, CA | ADDRESS: 1450 HERNDON AVE., CLOVIS, CA 93611 | PROJECT NUMBER: 17052 | REVISED: 10/25/17 |
| SUPER PHONE: | PHONE: (559) 327-9000 FAX: | FILE NAME: F:\MV7\EF\FD\17052 | DRAWN BY: AD REVISED BY: AD |
| | | DRAWING NUMBER: 25 | SUBMITTAL SET |

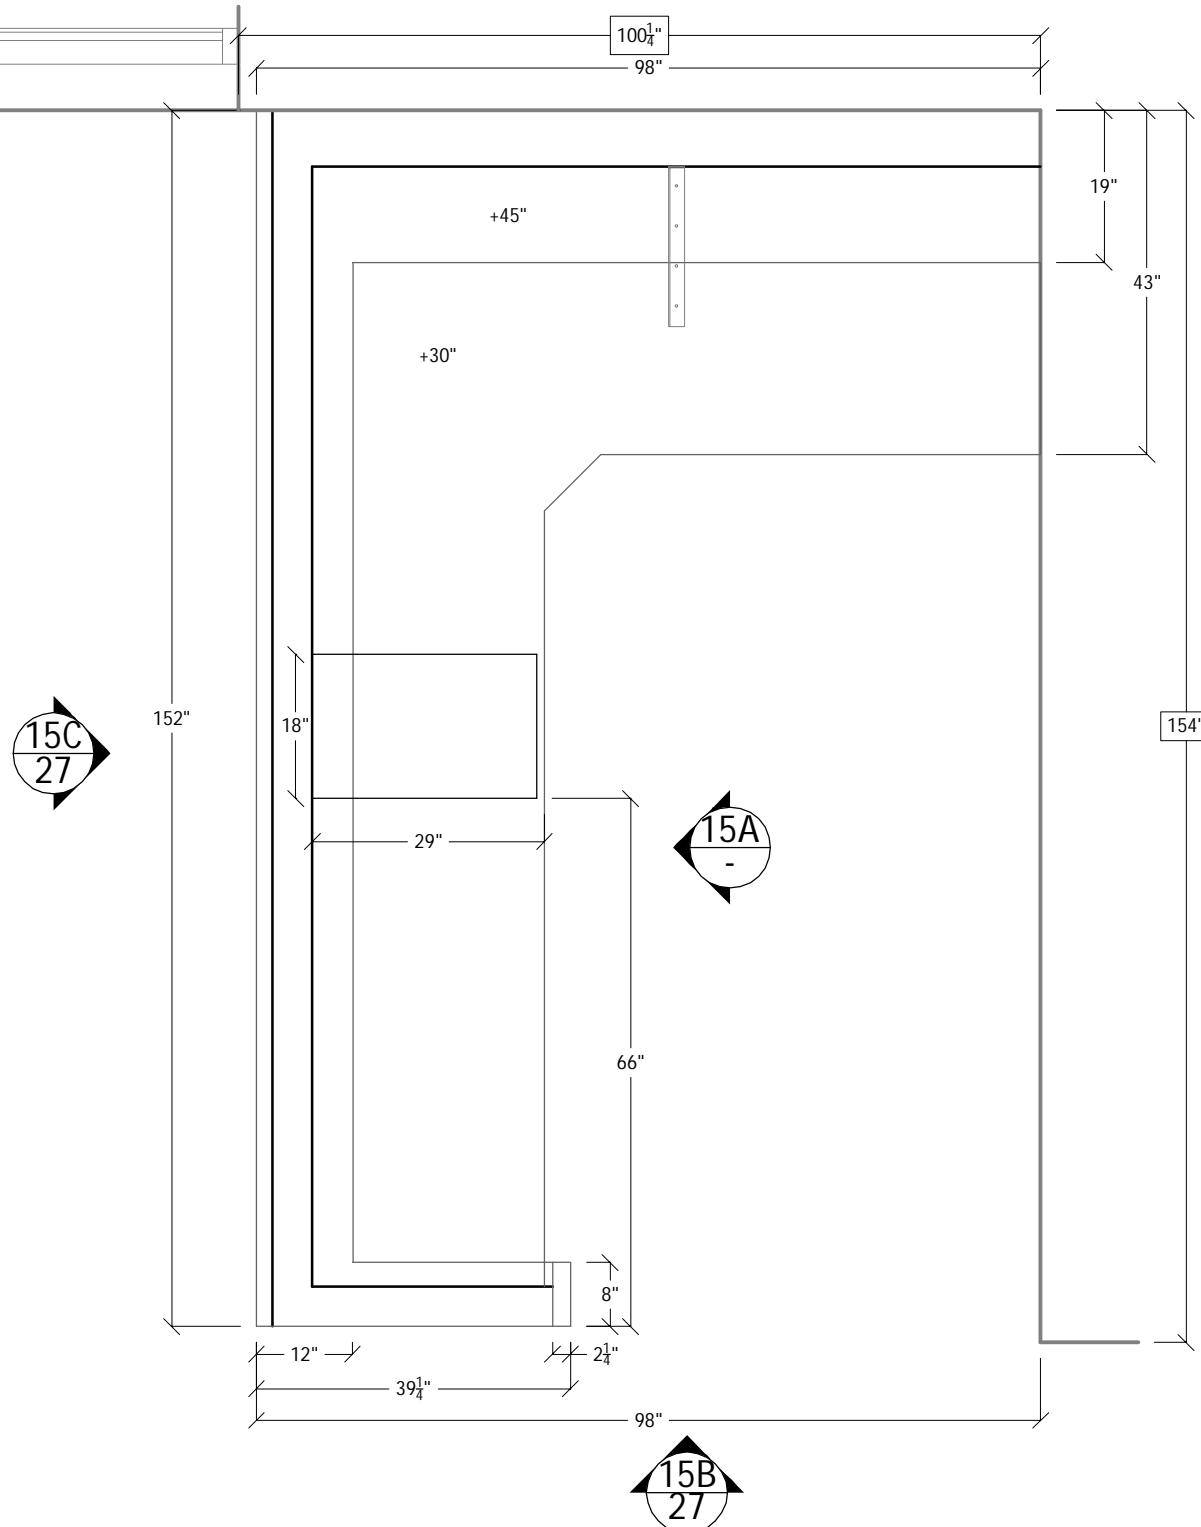


15 PLAN: MEDICAL STAFF WORK STATION #E13

REF: ARCH. PAGE NO. A/A106, X/A302

SCALE: $\frac{1}{2}''=1'-0''$



2555 N. Argyle, Fresno, California 93727
(559) 292-2448 - FAX (559) 292-3710

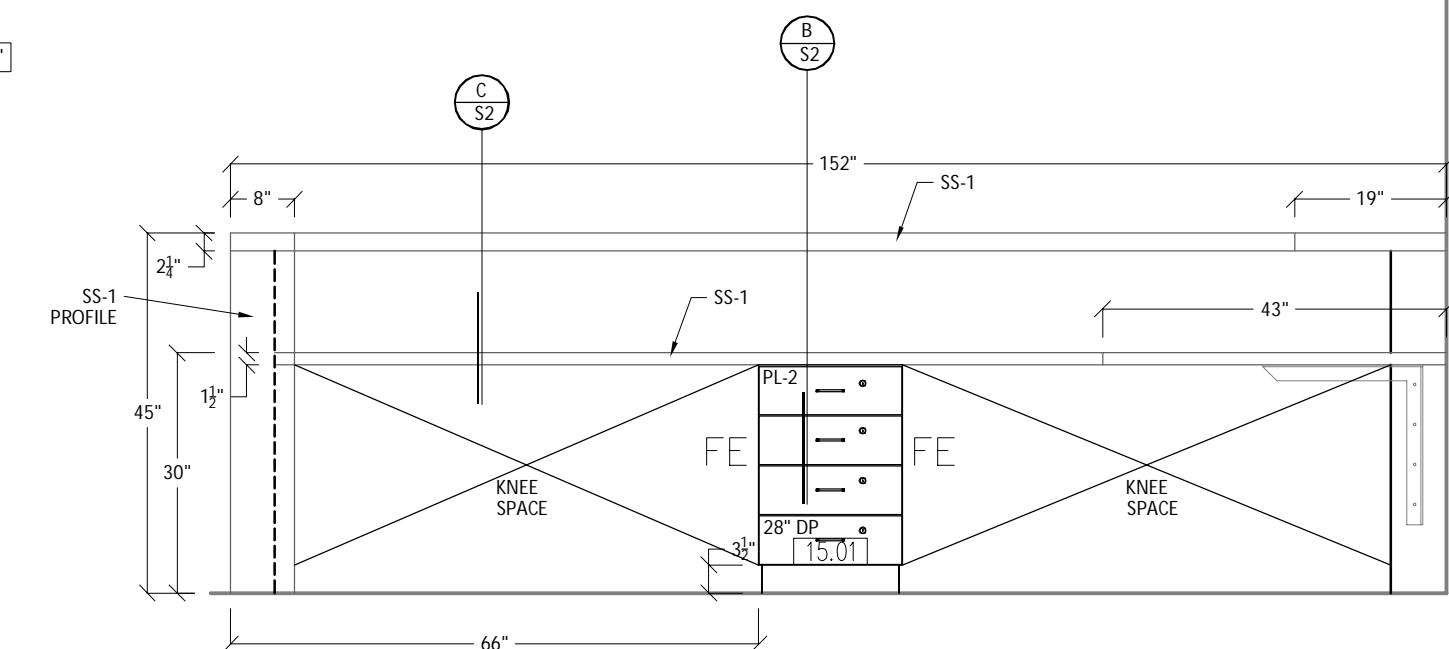


15A ELEVATION: MEDICAL STAFF WORK STATION #E13

REF: ARCH. PAGE NO. X/A303

SCALE: $\frac{1}{2}''=1'-0''$

IF SIZE OF SHEET IS NOT 11 X 17, SCALE ACCORDINGLY.


| | | | |
|--|---|--------------------------------------|---|
| PROJECT NAME: CUSD PROFESSIONAL LEARNING CENTER | CONTRACTOR/CLIENT NAME: CLOVIS UNIFIED SCHOOL DISTRICT | SCALE: | DATE: 09/22/17 |
| | | PROJECT NUMBER: 17052 | REVISED: 10/25/17 |
| LOCATION: CLOVIS, CA | ADDRESS: 1450 HERNDON AVE., CLOVIS, CA 93611 | FILE NAME: F:\MV7\EF\FD\17052 | DRAWN BY: AD REVISED BY: AD |
| SUPER PHONE: | PHONE: (559) 327-9000 FAX: | DRAWING NUMBER: 26 | SUBMITTAL SET |

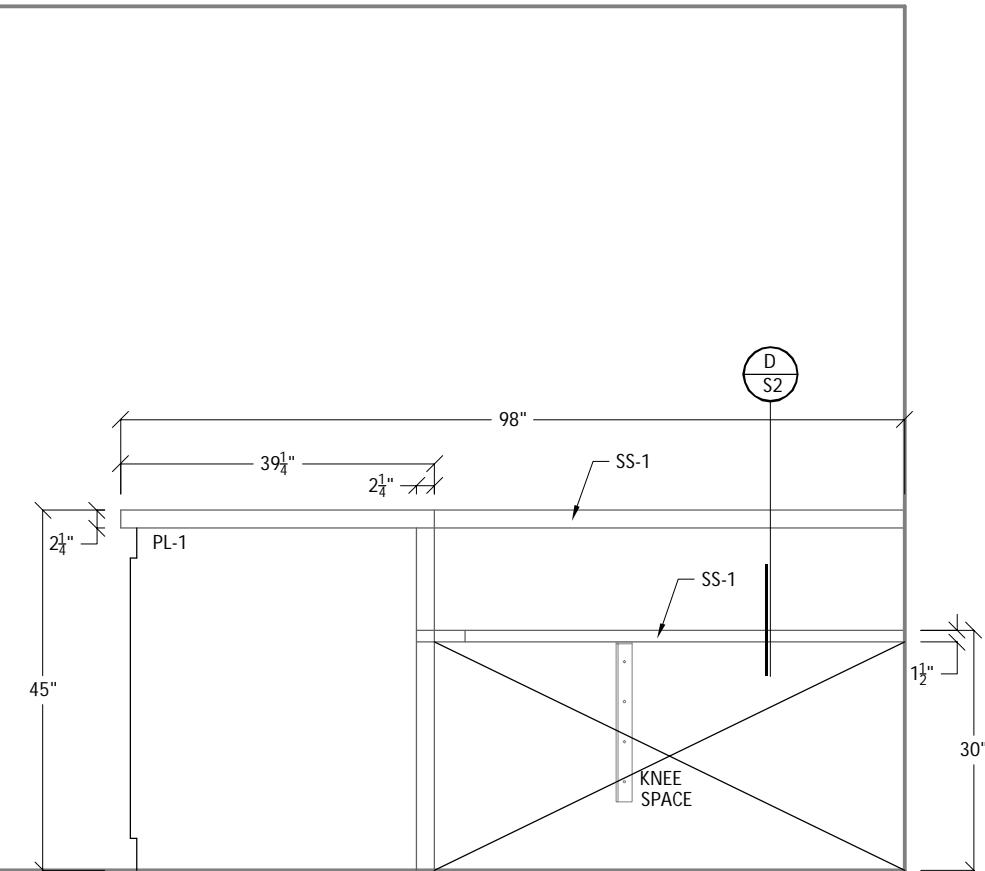

15B ELEVATION: MEDICAL STAFF WORK STATION #E13

REF: ARCH. PAGE NO. X/A303

SCALE: $\frac{1}{2}$ " = 1'-0"

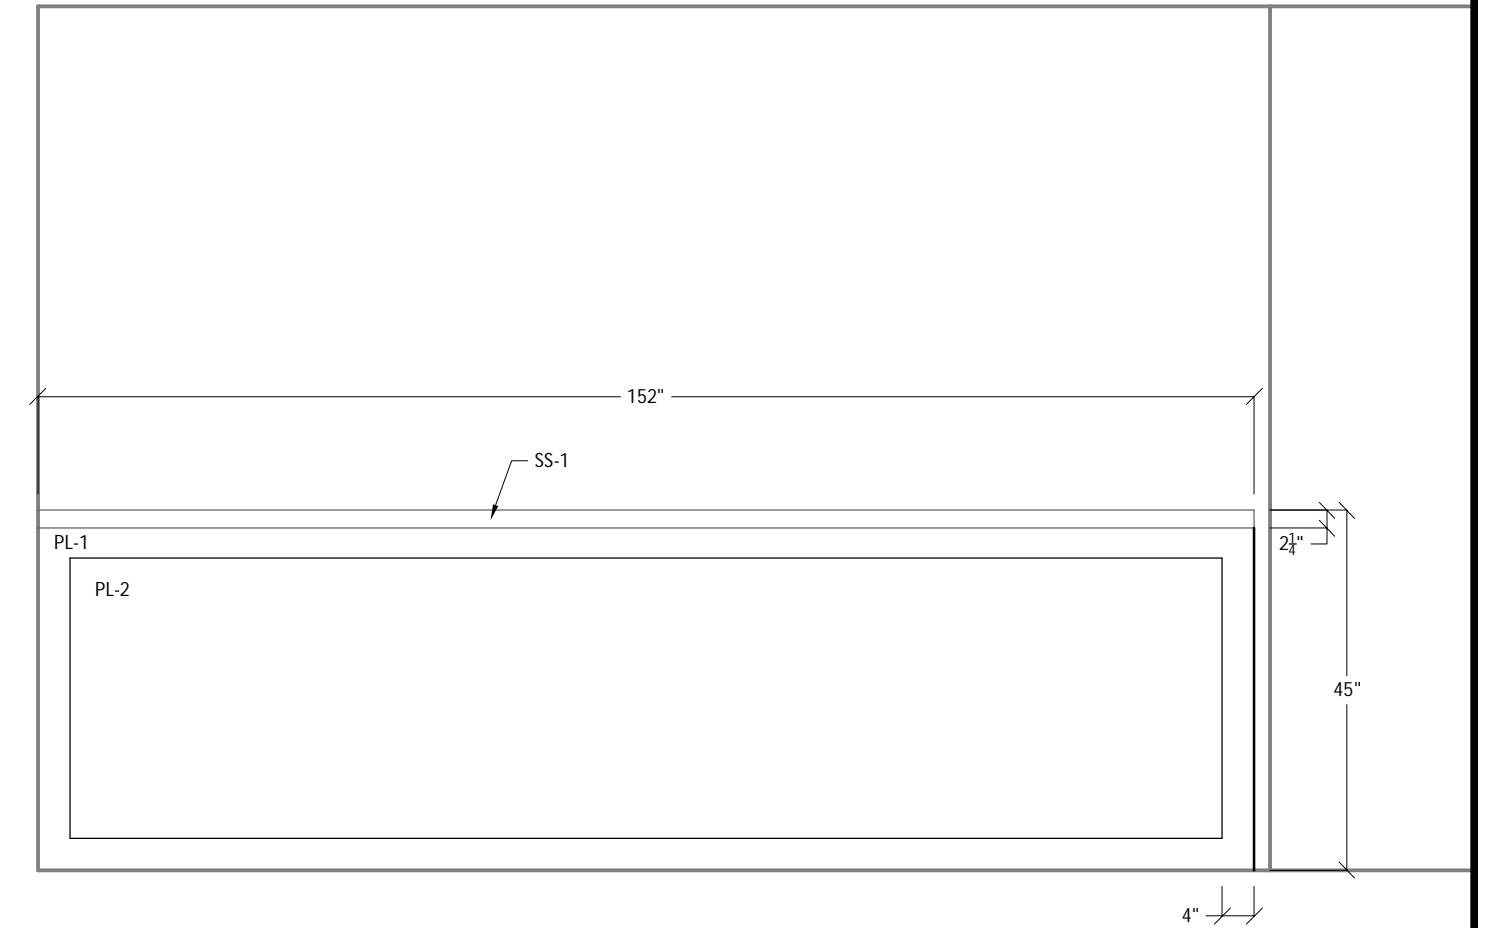

15C ELEVATION: MEDICAL STAFF WORK STATION #E13


REF: ARCH. PAGE NO. X/A303

SCALE: $\frac{1}{2}$ " = 1'-0"

IF SIZE OF SHEET IS NOT 11 X 17, SCALE ACCORDINGLY.

| |
|---|
| EVERLAST WOODWORKING |
| 2555 N. Argyle, Fresno, California 93727 (559) 292-2448 - FAX (559) 292-3710 |

| | | | |
|--|---|---|---|
| PROJECT NAME: CUSD PROFESSIONAL LEARNING CENTER | CONTRACTOR/CLIENT NAME: CLOVIS UNIFIED SCHOOL DISTRICT | SCALE: | DATE: |
| LOCATION: CLOVIS, CA | ADDRESS: 1450 HERNDON AVE., CLOVIS, CA 93611 | PROJECT NUMBER: 17052 | REVISED: 10/25/17 |
| SUPER PHONE: | PHONE: (559) 327-9000 FAX: | FILE NAME: F:\MV7\EF\FD\17052 | DRAWN BY: AD REVISED BY: AD |
| | | DRAWING NUMBER: 27 | SUBMITTAL SET |

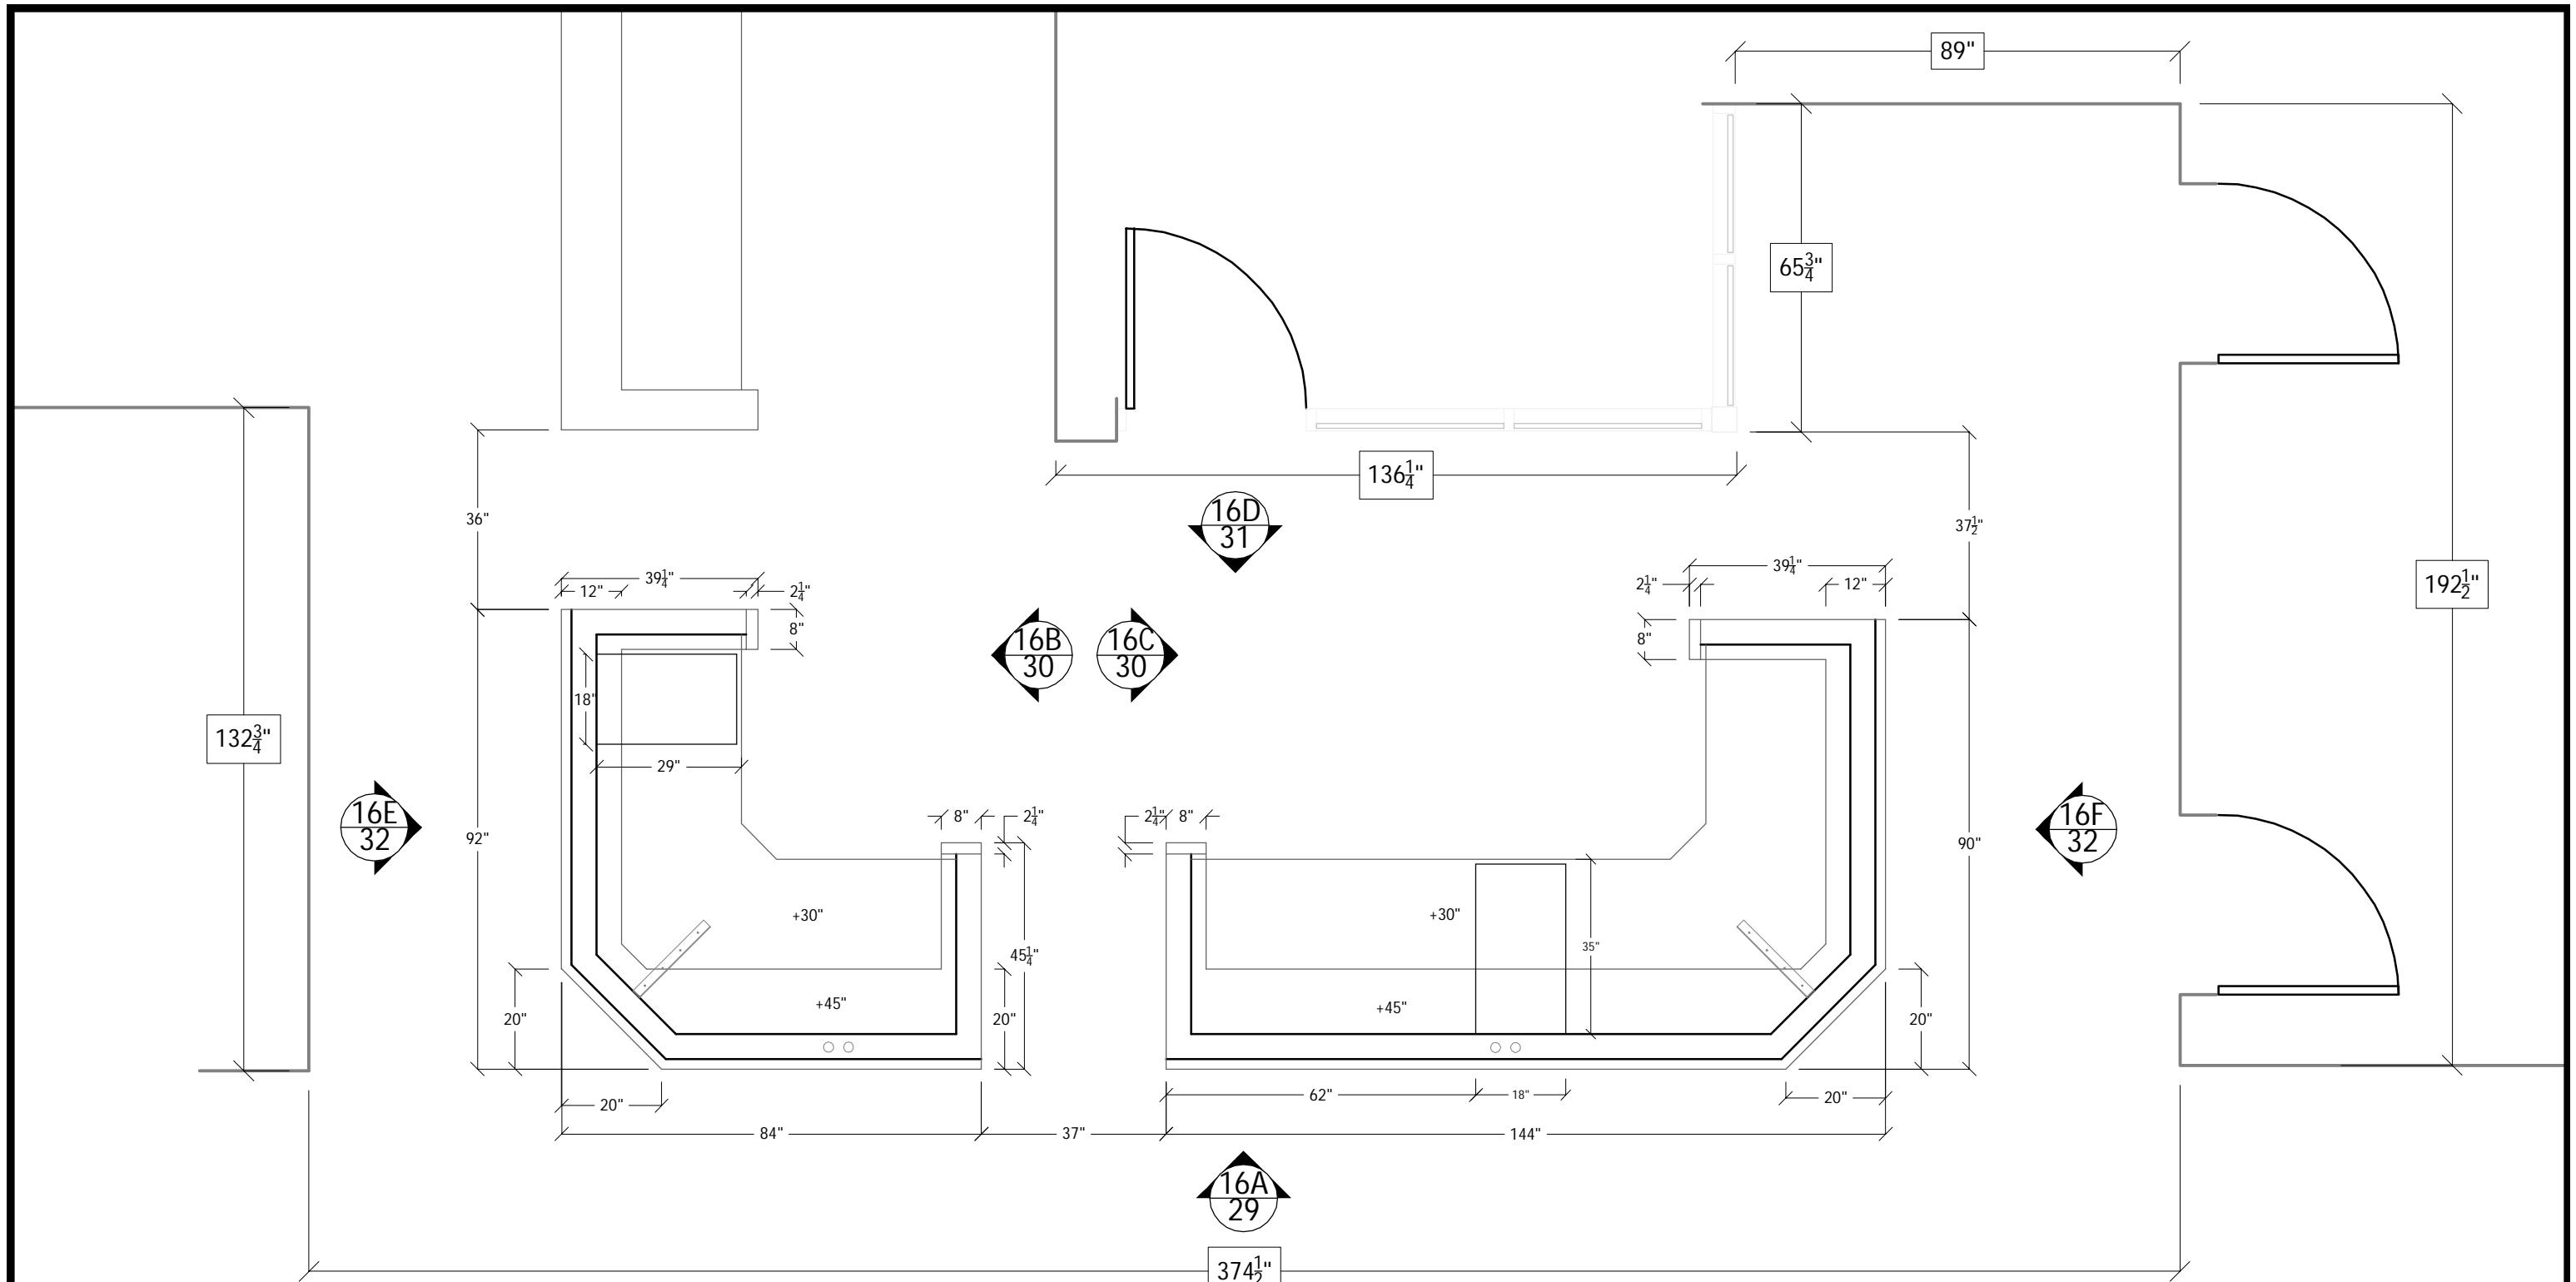

A circle divided into four quadrants by a horizontal and vertical line. The bottom-left quadrant contains three horizontal lines.

16 PLAN: MEDICAL STAFF WORK STATION #E13

REF: ARCH. PAGE NO. A/A106, X/A302


SCALE: $\frac{3}{8}'' = 1'-0''$

IF SIZE OF SHEET IS NOT 11 X 17, SCALE ACCORDINGLY.



2555 N. Argyle, Fresno, California 93727
(559) 292-2448 - FAX (559) 292-3710

| | | | | |
|--|---|---|-----------------|-----------------|
| PROJECT NAME: CUSD PROFESSIONAL LEARNING CENTER | CONTRACTOR/CLIENT NAME: CLOVIS UNIFIED SCHOOL DISTRICT | SCALE: | DATE: | 09/22/17 |
| | | PROJECT NUMBER: | 17052 | REVISED: |
| LOCATION: CLOVIS, CA | ADDRESS: 1450 HERNDON AVE., CLOVIS, CA 93611 | FILE NAME: F:\MV7\EF\FD\17052 | DRAWN BY: | AD |
| SUPER PHONE: | PHONE: (559) 327-9000 | FAX: | DRAWING NUMBER: | 28 |
| SUBMITTAL SET | | | | |

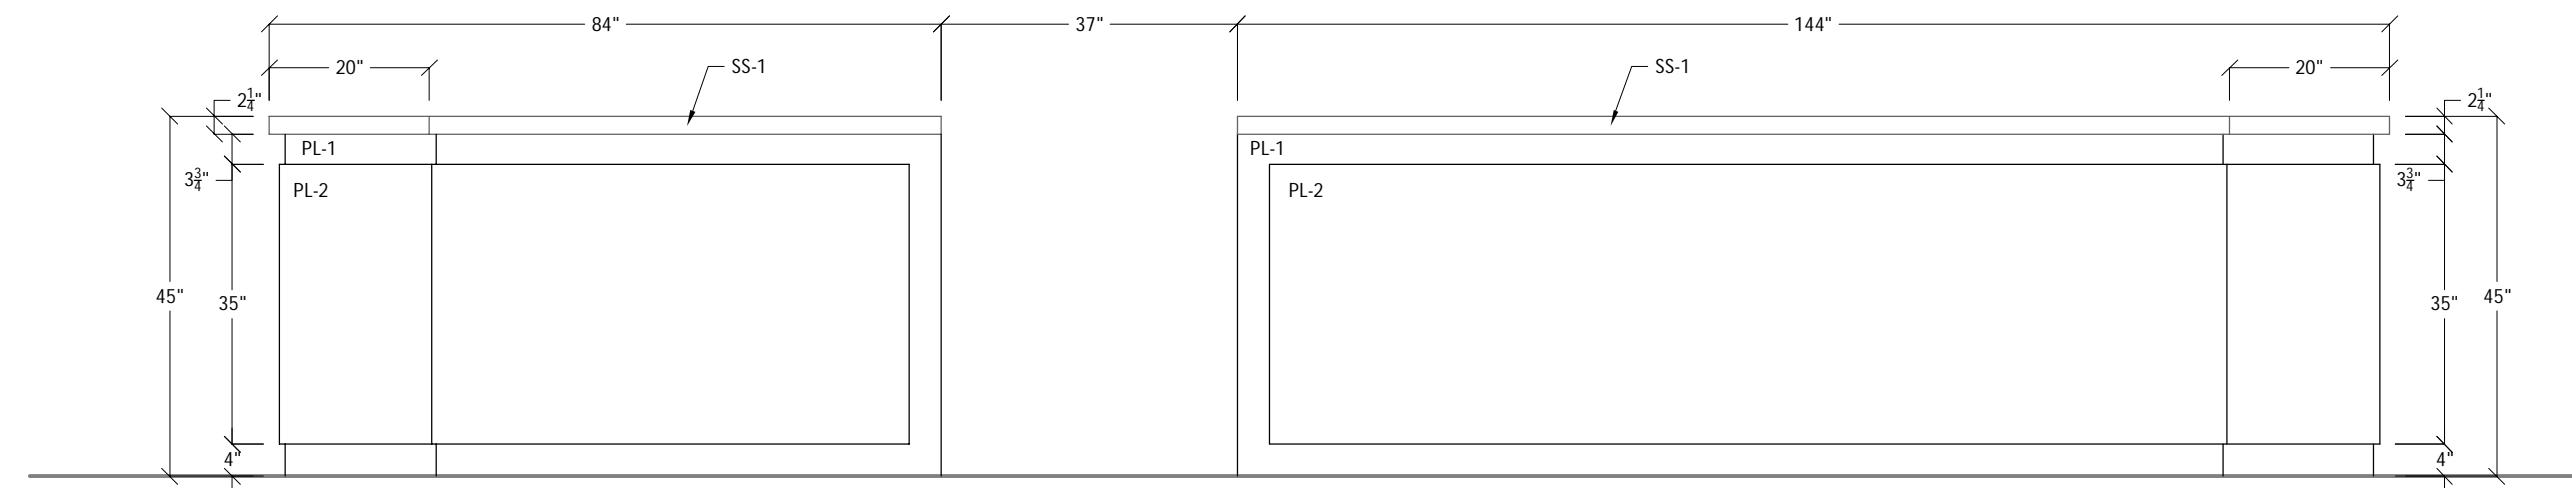

16A

ELEVATION: MEDICAL STAFF WORK STATION #E13


REF: ARCH. PAGE NO. X/A303

SCALE: $\frac{1}{2}$ "=1'-0"

IF SIZE OF SHEET IS NOT 11 X 17, SCALE ACCORDINGLY.


| |
|---|
| EVERLAST WOODWORKING |
| 2555 N. Argyle, Fresno, California 93727 (559) 292-2448 - FAX (559) 292-3710 |

| | | | |
|--|---|---|--|
| PROJECT NAME: CUSD PROFESSIONAL LEARNING CENTER | CONTRACTOR/CLIENT NAME: CLOVIS UNIFIED SCHOOL DISTRICT | SCALE: PROJECT NUMBER: 17052 | DATE: REVISED: 09/22/17 |
| LOCATION: CLOVIS, CA | ADDRESS: 1450 HERNDON AVE., CLOVIS, CA 93611 | FILE NAME: F:\MV7\EF\FD\17052 | DRAWN BY: REVISED BY: AD AD |
| SUPER PHONE: | PHONE: (559) 327-9000 FAX: | DRAWING NUMBER: 29 | SUBMITTAL SET |

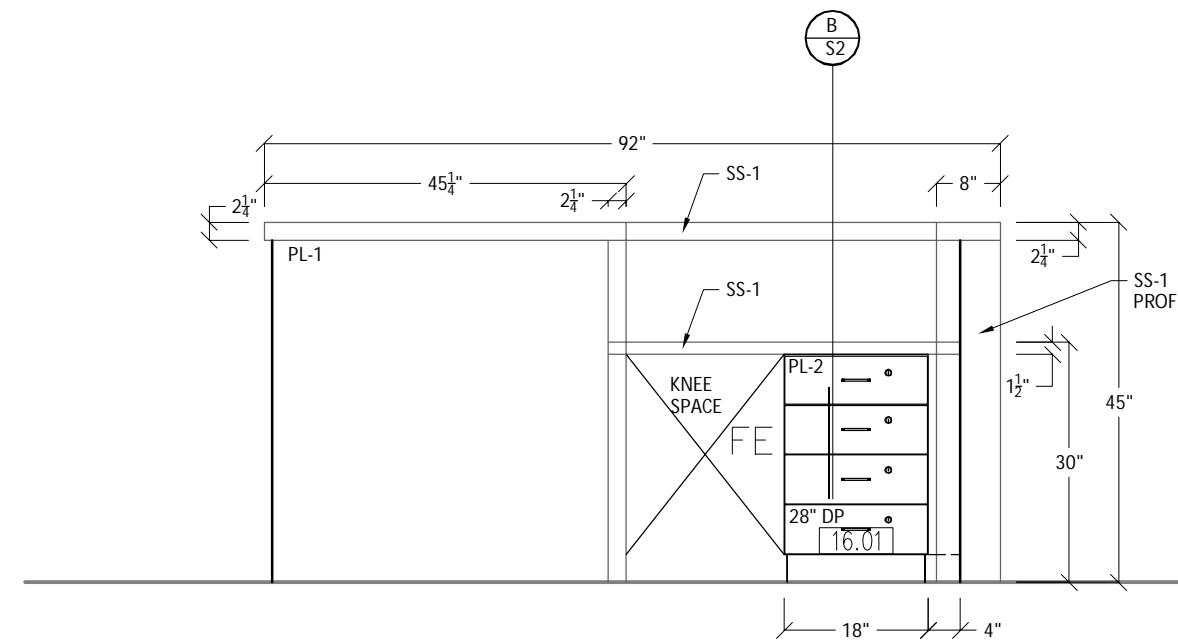

16B ELEVATION: MEDICAL STAFF WORK STATION #E13

REF: ARCH. PAGE NO. X/A303
SCALE: $\frac{1}{2}'' = 1'-0''$

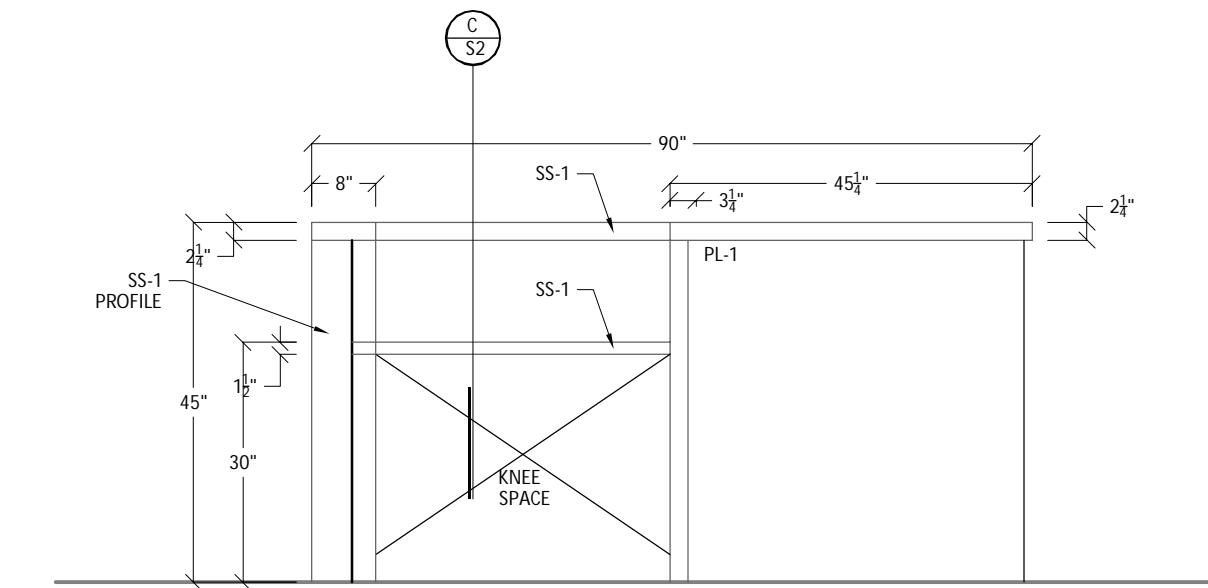

16C ELEVATION: MEDICAL STAFF WORK STATION #E13


REF: ARCH. PAGE NO. X/A303
SCALE: $\frac{1}{2}'' = 1'-0''$

IF SIZE OF SHEET IS NOT 11 X 17, SCALE ACCORDINGLY.

| | | | | |
|---|--|---|---------------------------------|-----------------------------|
| EVERLAST WOODWORKING | PROJECT NAME: CUSD PROFESSIONAL LEARNING CENTER | CONTRACTOR/CLIENT NAME: CLOVIS UNIFIED SCHOOL DISTRICT | SCALE: | DATE: |
| 2555 N. Argyle, Fresno, California 93727 (559) 292-2448 - FAX (559) 292-3710 | LOCATION: CLOVIS, CA | ADDRESS: 1450 HERNDON AVE., CLOVIS, CA 93611 | PROJECT NUMBER: 17052 | REVISED: 10/25/17 |
| SUPER PHONE: | PHONE: (559) 327-9000 | FAX: | DRAWING NUMBER: 30 | REVISED BY: AD |

| | | |
|---|---|-----------------------------|
| CONTRACTOR/CLIENT NAME: CLOVIS UNIFIED SCHOOL DISTRICT | SCALE: | DATE: |
| ADDRESS: 1450 HERNDON AVE., CLOVIS, CA 93611 | PROJECT NUMBER: 17052 | REVISED: 10/25/17 |
| PHONE: (559) 327-9000 | FILE NAME: F:\MV7\EF\FD\17052 | DRAWN BY: AD |

SUBMITTAL SET

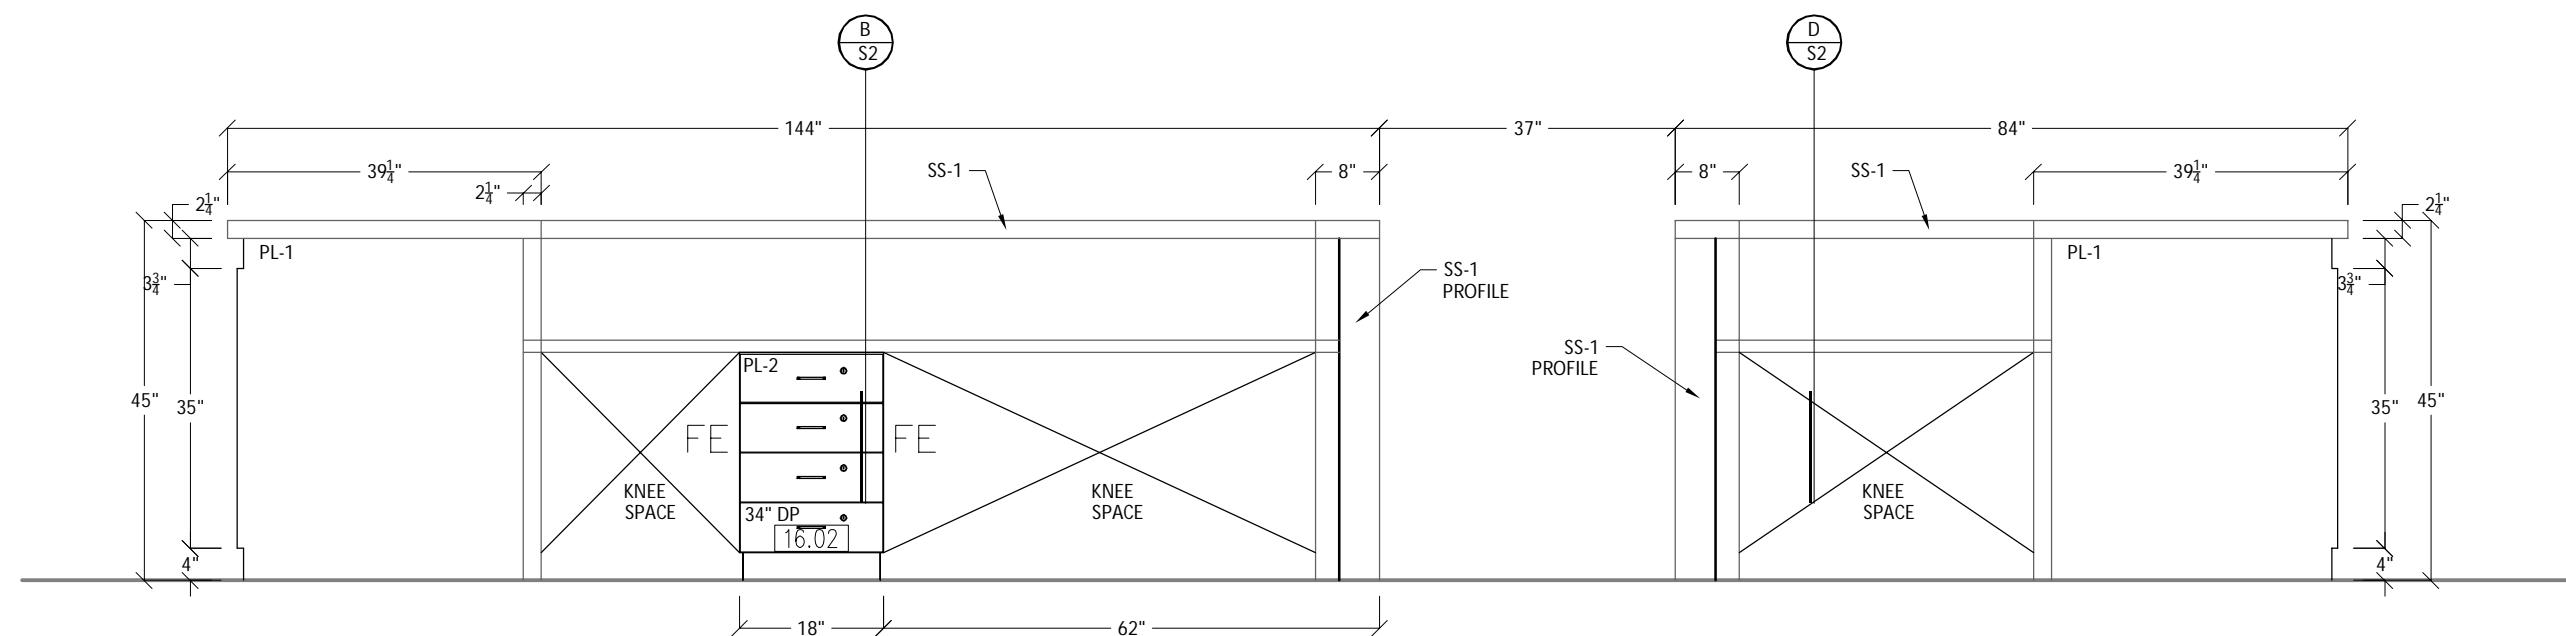

16D ELEVATION: MEDICAL STAFF WORK STATION #E1
REF: ARCH. PAGE NO. X/A303

REF: ARCH. PAGE NO. X/A30


SCALE: $\frac{1}{2}$ "=1'-0"

IF SIZE OF SHEET IS NOT 11 X 17, SCALE ACCORDINGLY.



2555 N. Argyle, Fresno, California 93727
(559) 292-2448 - FAX (559) 292-3710

| | | | | | |
|---|--|---|------------------------------|---------------------------|-----------------------|
|  EMERIAN WOODWORKING <hr/> 2555 N. Argyle, Fresno, California 93727 (559) 292-2448 - FAX (559) 292-3710 | PROJECT NAME: CUSD PROFESSIONAL LEARNING CENTER | CONTRACTOR/CLIENT NAME: CLOVIS UNIFIED SCHOOL DISTRICT | SCALE: | DATE: 09/22/17 | |
| | LOCATION: CLOVIS, CA | ADDRESS: 1450 HERNDON AVE., CLOVIS, CA 93611 | PROJECT NUMBER: 17052 | REVISED: 10/25/17 | |
| | SUPER PHONE: | PHONE: (559) 327-9000 | FAX: _____ | DRAWN BY: AD | REVISED BY: AD |
| | | | | DRAWING NUMBER: 31 | SUBMITTAL SET |

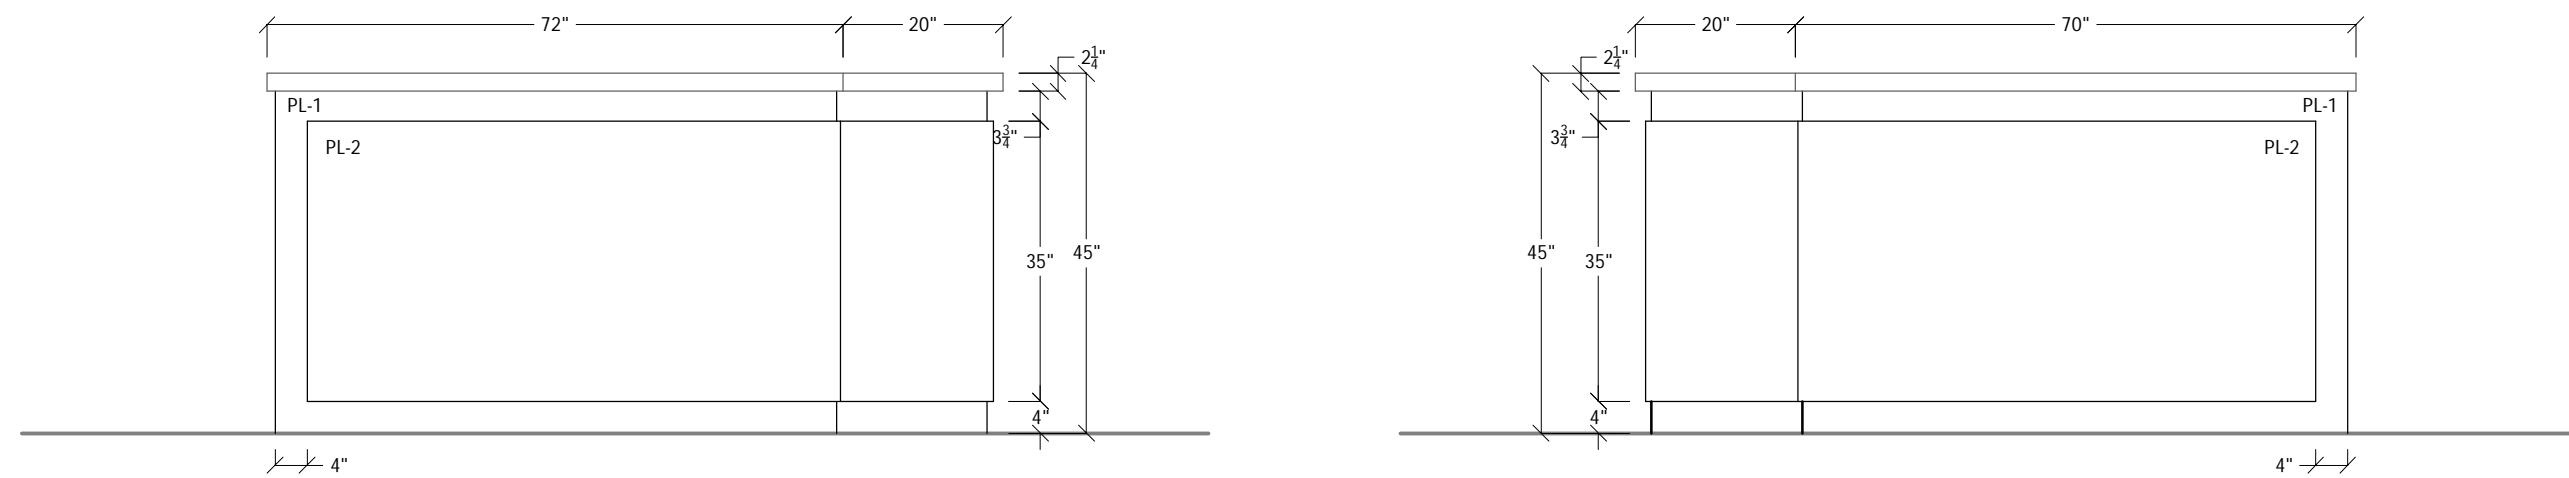

16E

ELEVATION: MEDICAL STAFF WORK STATION #E13

REF: ARCH. PAGE NO. X/A303

SCALE: $\frac{1}{2}$ "=1'-0"

16F

ELEVATION: MEDICAL STAFF WORK STATION #E13


REF: ARCH. PAGE NO. X/A303

SCALE: $\frac{1}{2}$ "=1'-0"

IF SIZE OF SHEET IS NOT 11 X 17, SCALE ACCORDINGLY.

| |
|---|
| EVERLAST WOODWORKING |
| 2555 N. Argyle, Fresno, California 93727 (559) 292-2448 - FAX (559) 292-3710 |


| | | | |
|--|---|--------------------------------------|---|
| PROJECT NAME: CUSD PROFESSIONAL LEARNING CENTER | CONTRACTOR/CLIENT NAME: CLOVIS UNIFIED SCHOOL DISTRICT | SCALE: | DATE: 09/22/17 |
| LOCATION: CLOVIS, CA | ADDRESS: 1450 HERNDON AVE., CLOVIS, CA 93611 | PROJECT NUMBER: 17052 | REVISED: 10/25/17 |
| SUPER PHONE: | PHONE: (559) 327-9000 FAX: | FILE NAME: F:\MV7\EF\FD\17052 | DRAWN BY: AD REVISED BY: AD |
| | | DRAWING NUMBER: 32 | SUBMITTAL SET |

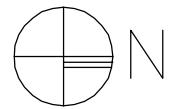

17 PLAN: INTERNET CAFE #C09

REF: ARCH. PAGE NO. A/A106



SCALE: $\frac{1}{2}$ " = 1'-0"

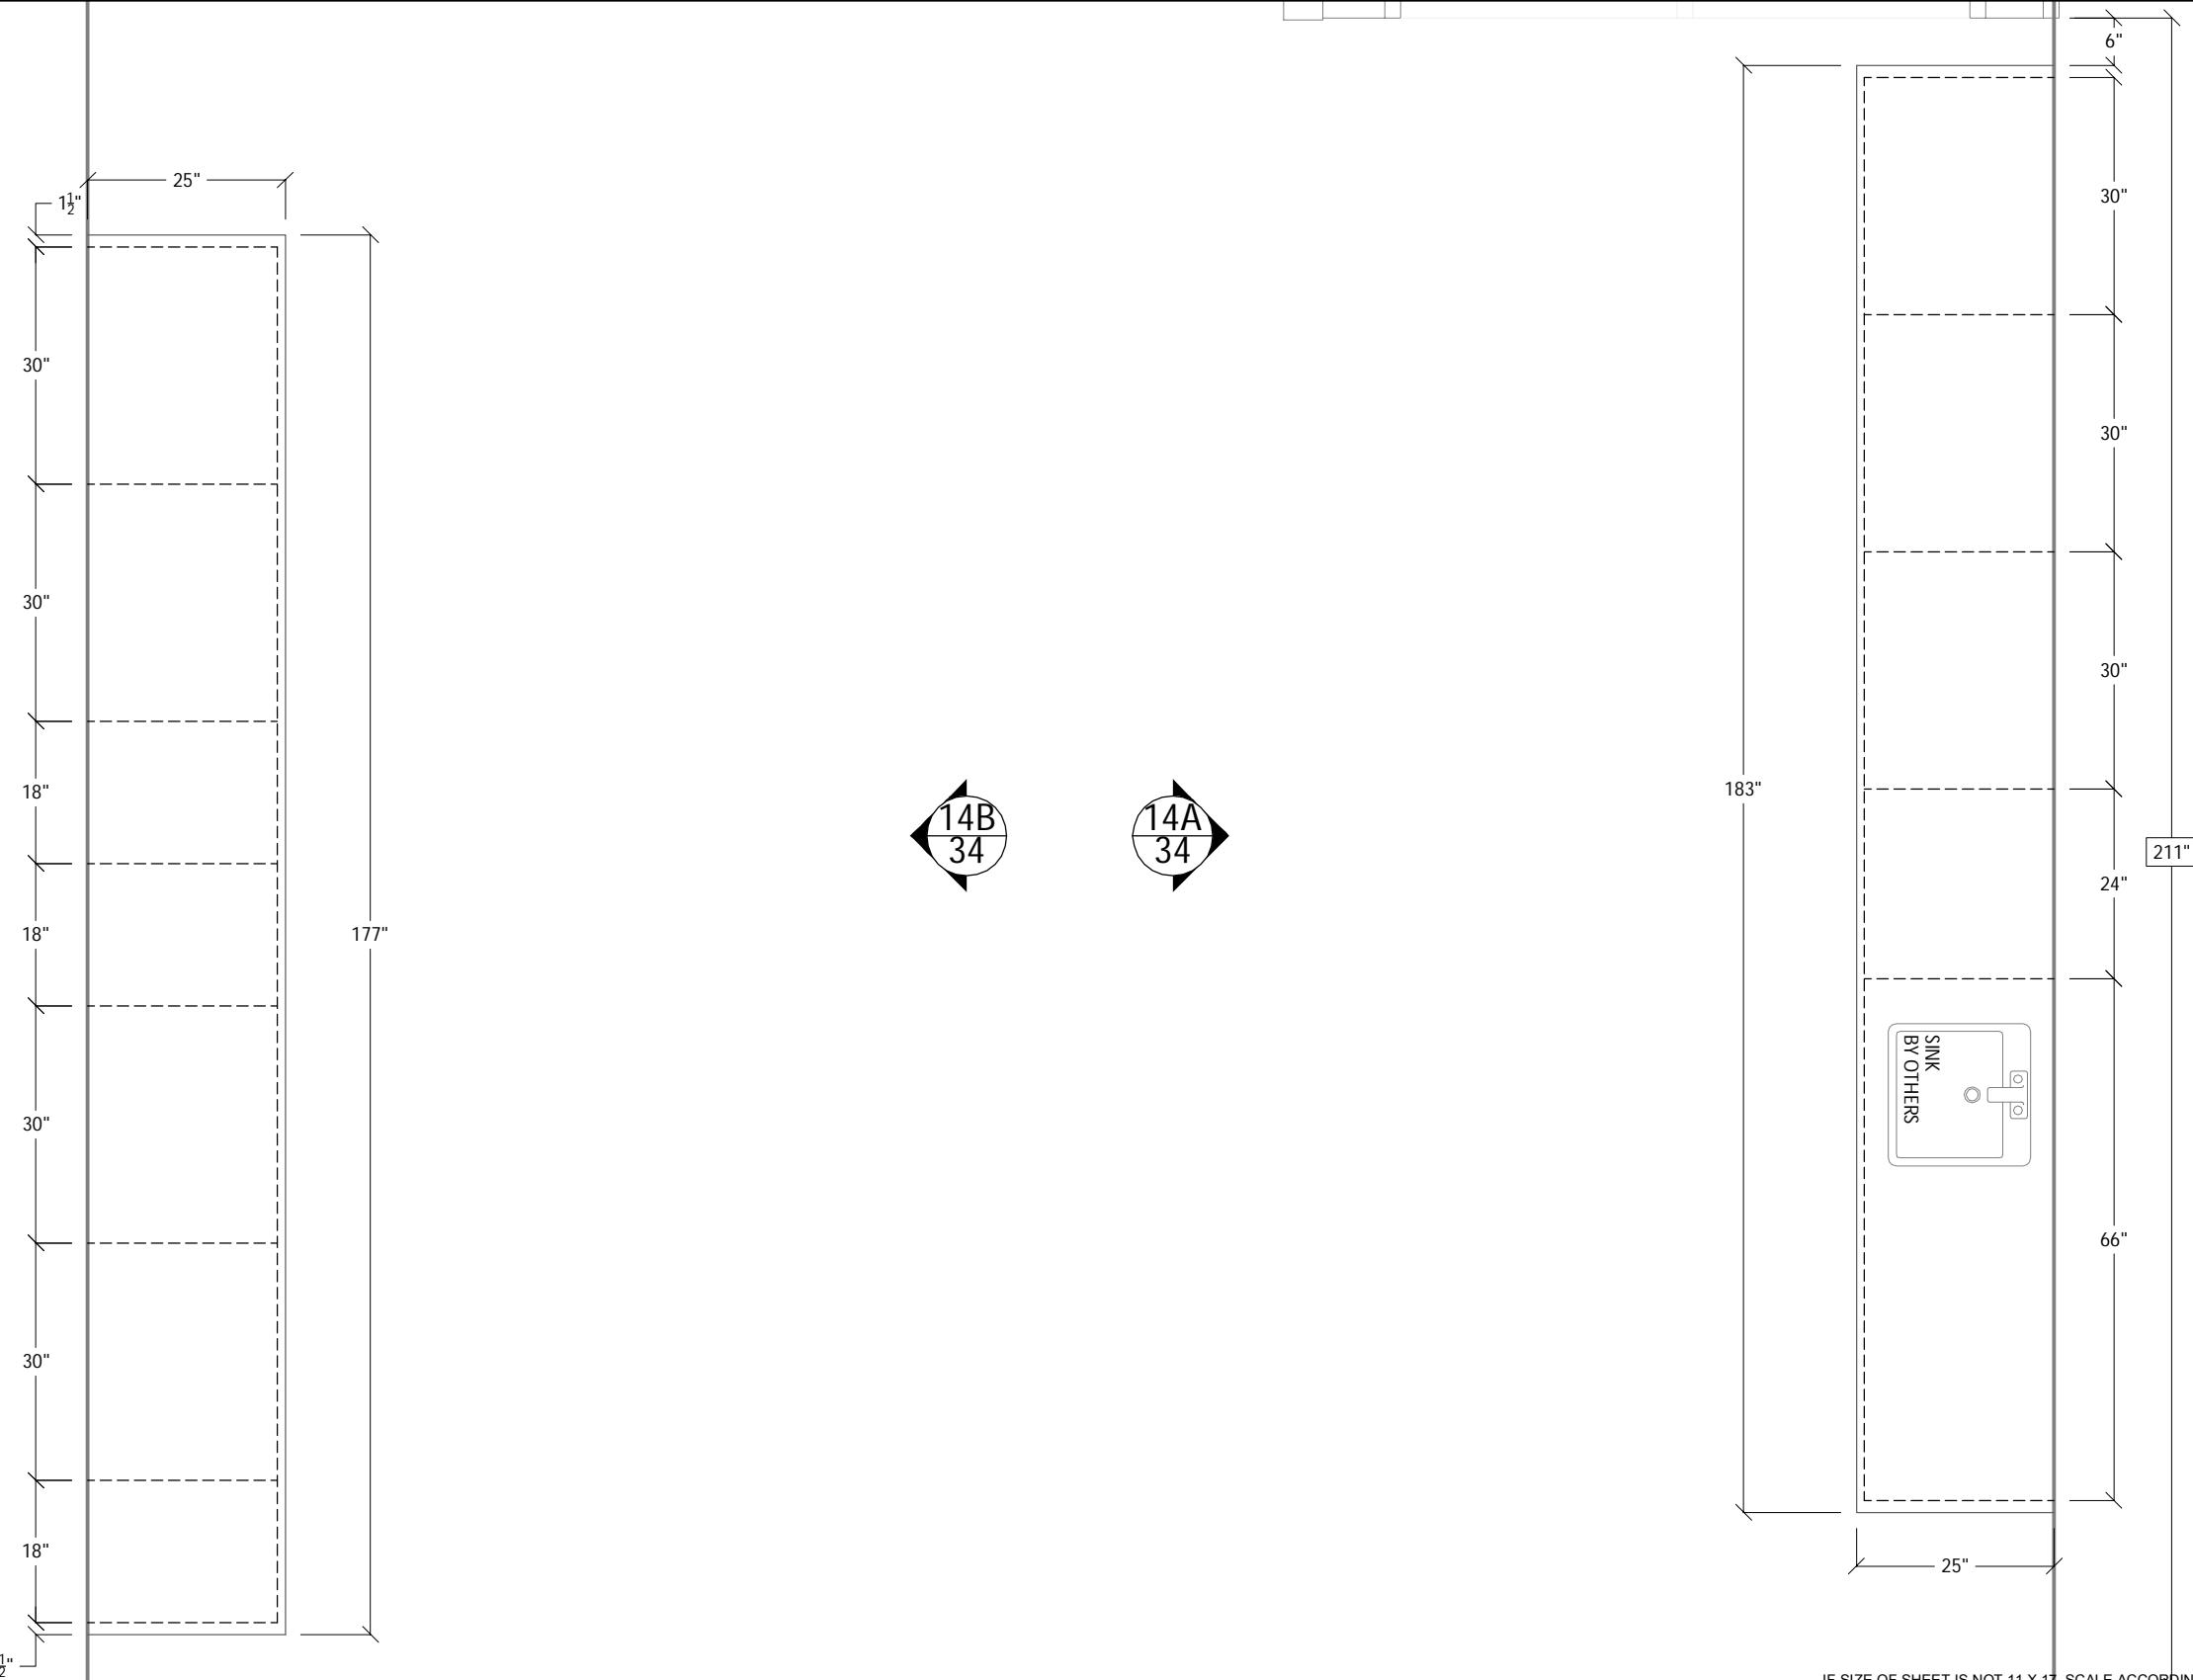

IF SIZE OF SHEET IS NOT 11 X 17, SCALE ACCORDINGLY.

| |
|---|
| EVERLAST WOODWORKING |
| 2555 N. Argyle, Fresno, California 93727 (559) 292-2448 - FAX (559) 292-3710 |


| | | | |
|---|--|------------------------------------|-----------------------------------|
| PROJECT NAME: CUSD PROFESSIONAL LEARNING CENTER | CONTRACTOR/CLIENT NAME: CLOVIS UNIFIED SCHOOL DISTRICT | SCALE: PROJECT NUMBER: 17052 | DATE: 09/22/17 |
| LOCATION: CLOVIS, CA | ADDRESS: 1450 HERNDON AVE., CLOVIS, CA 93611 | FILE NAME: F:\MV7\EF\FD\17052 | REVISED: 10/25/17 |
| SUPER PHONE: | PHONE: (559) 327-9000 FAX: | DRAWING NUMBER: 33 | DRAWN BY: AD REVISED BY: AD |

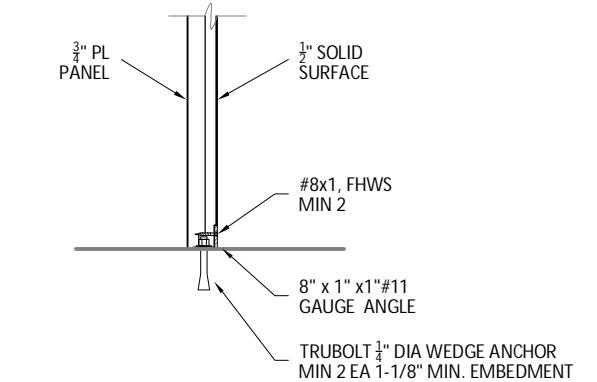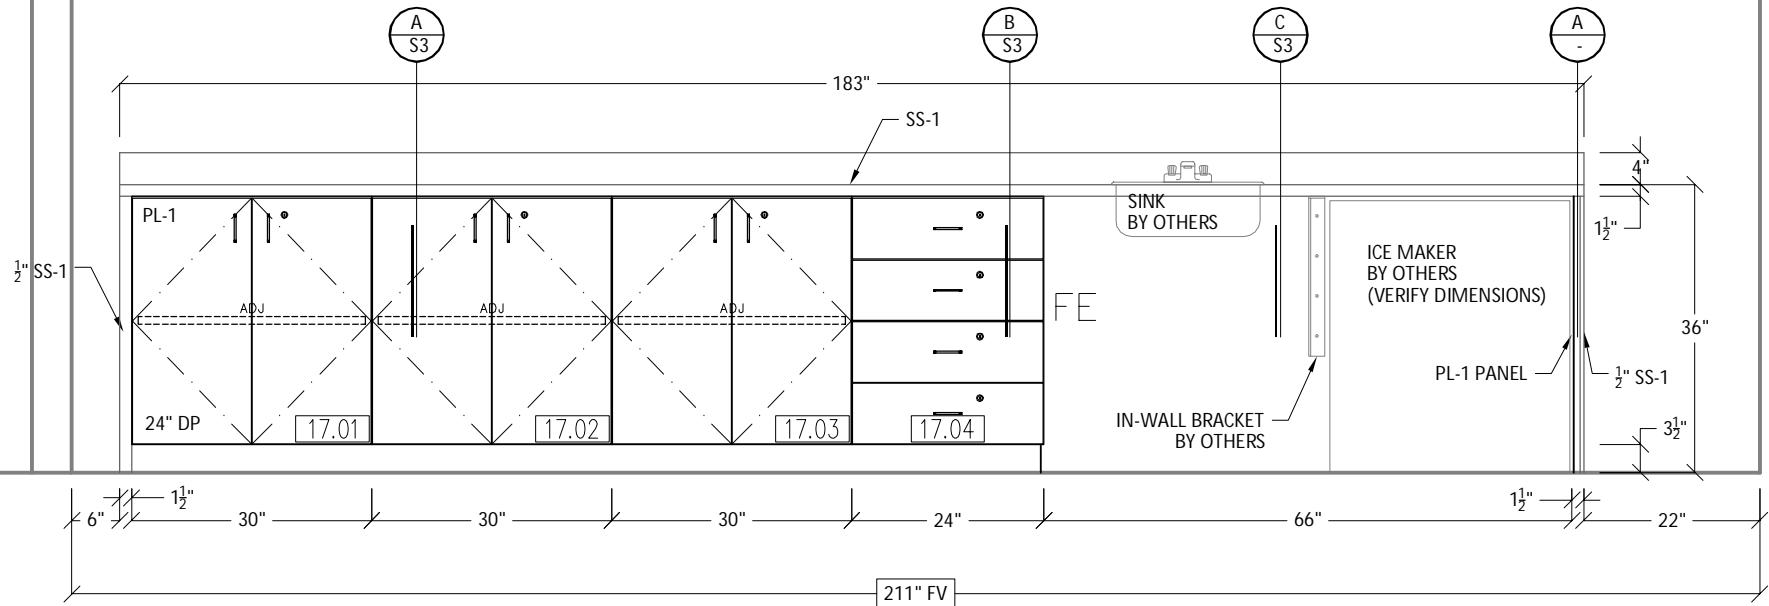

A SECTION
SCALE: 1"=1'-0"

17A ELEVATION: INTERNET CAFE #C09

REF: ARCH. PAGE NO. C/A601
SCALE: 1/2"=1'-0"

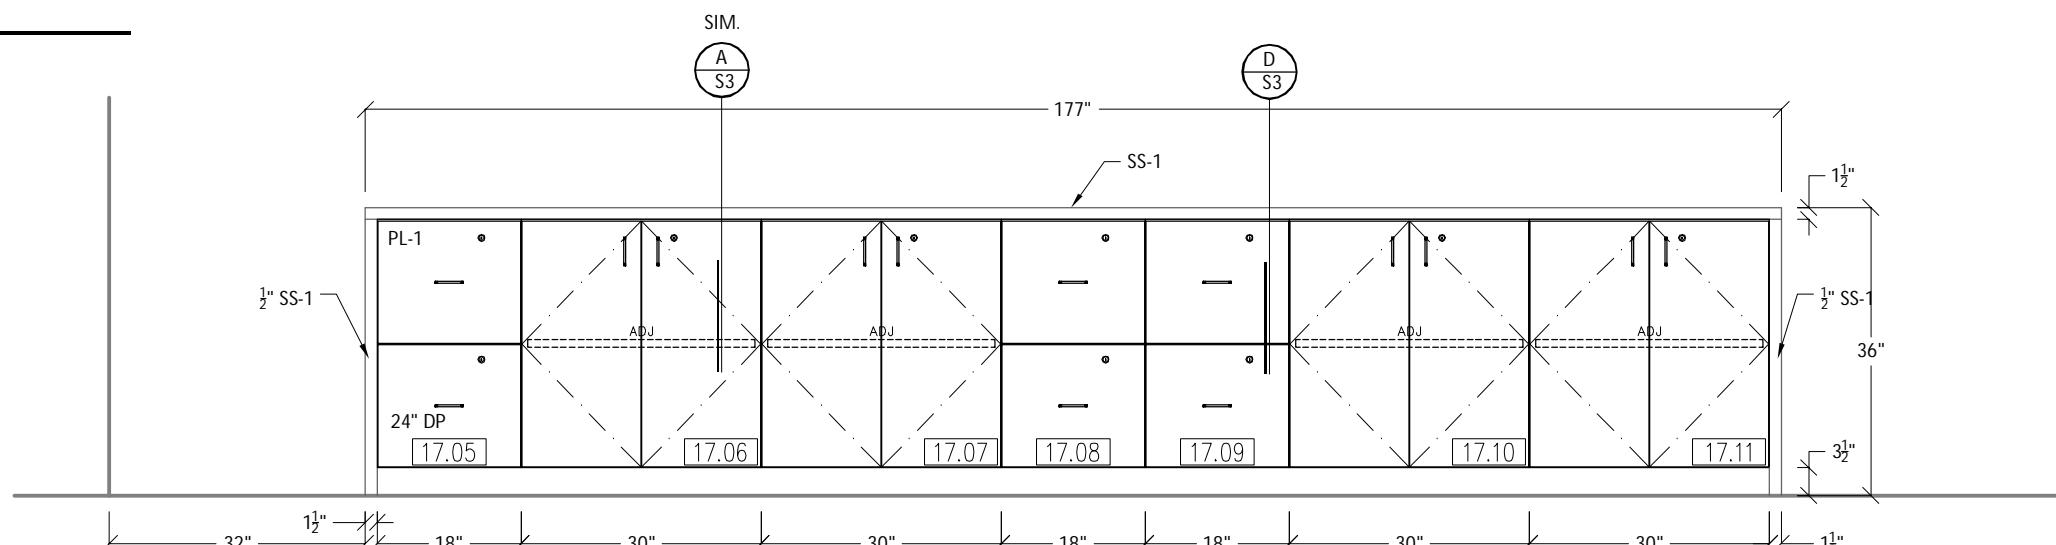


17B ELEVATION: INTERNET CAFE #C09

REF: ARCH. PAGE NO. C/A602
SCALE: 1/2"=1'-0"

IF SIZE OF SHEET IS NOT 11 X 17, SCALE ACCORDINGLY.

| |
|---|
| EVERLAST WOODWORKING |
| 2555 N. Argyle, Fresno, California 93727 (559) 292-2448 - FAX (559) 292-3710 |

| | | | |
|--|---|---|--|
| PROJECT NAME: CUSD PROFESSIONAL LEARNING CENTER | CONTRACTOR/CLIENT NAME: CLOVIS UNIFIED SCHOOL DISTRICT | SCALE: PROJECT NUMBER: 17052 | DATE: REVISED: 09/22/17 |
| LOCATION: CLOVIS, CA | ADDRESS: 1450 HERNDON AVE., CLOVIS, CA 93611 | FILE NAME: F:\MV7\EF\FD\17052 | DRAWN BY: REVISED BY: AD AD |
| SUPER PHONE: | PHONE: (559) 327-9000 FAX: | DRAWING NUMBER: 34 | SUBMITTAL SET |

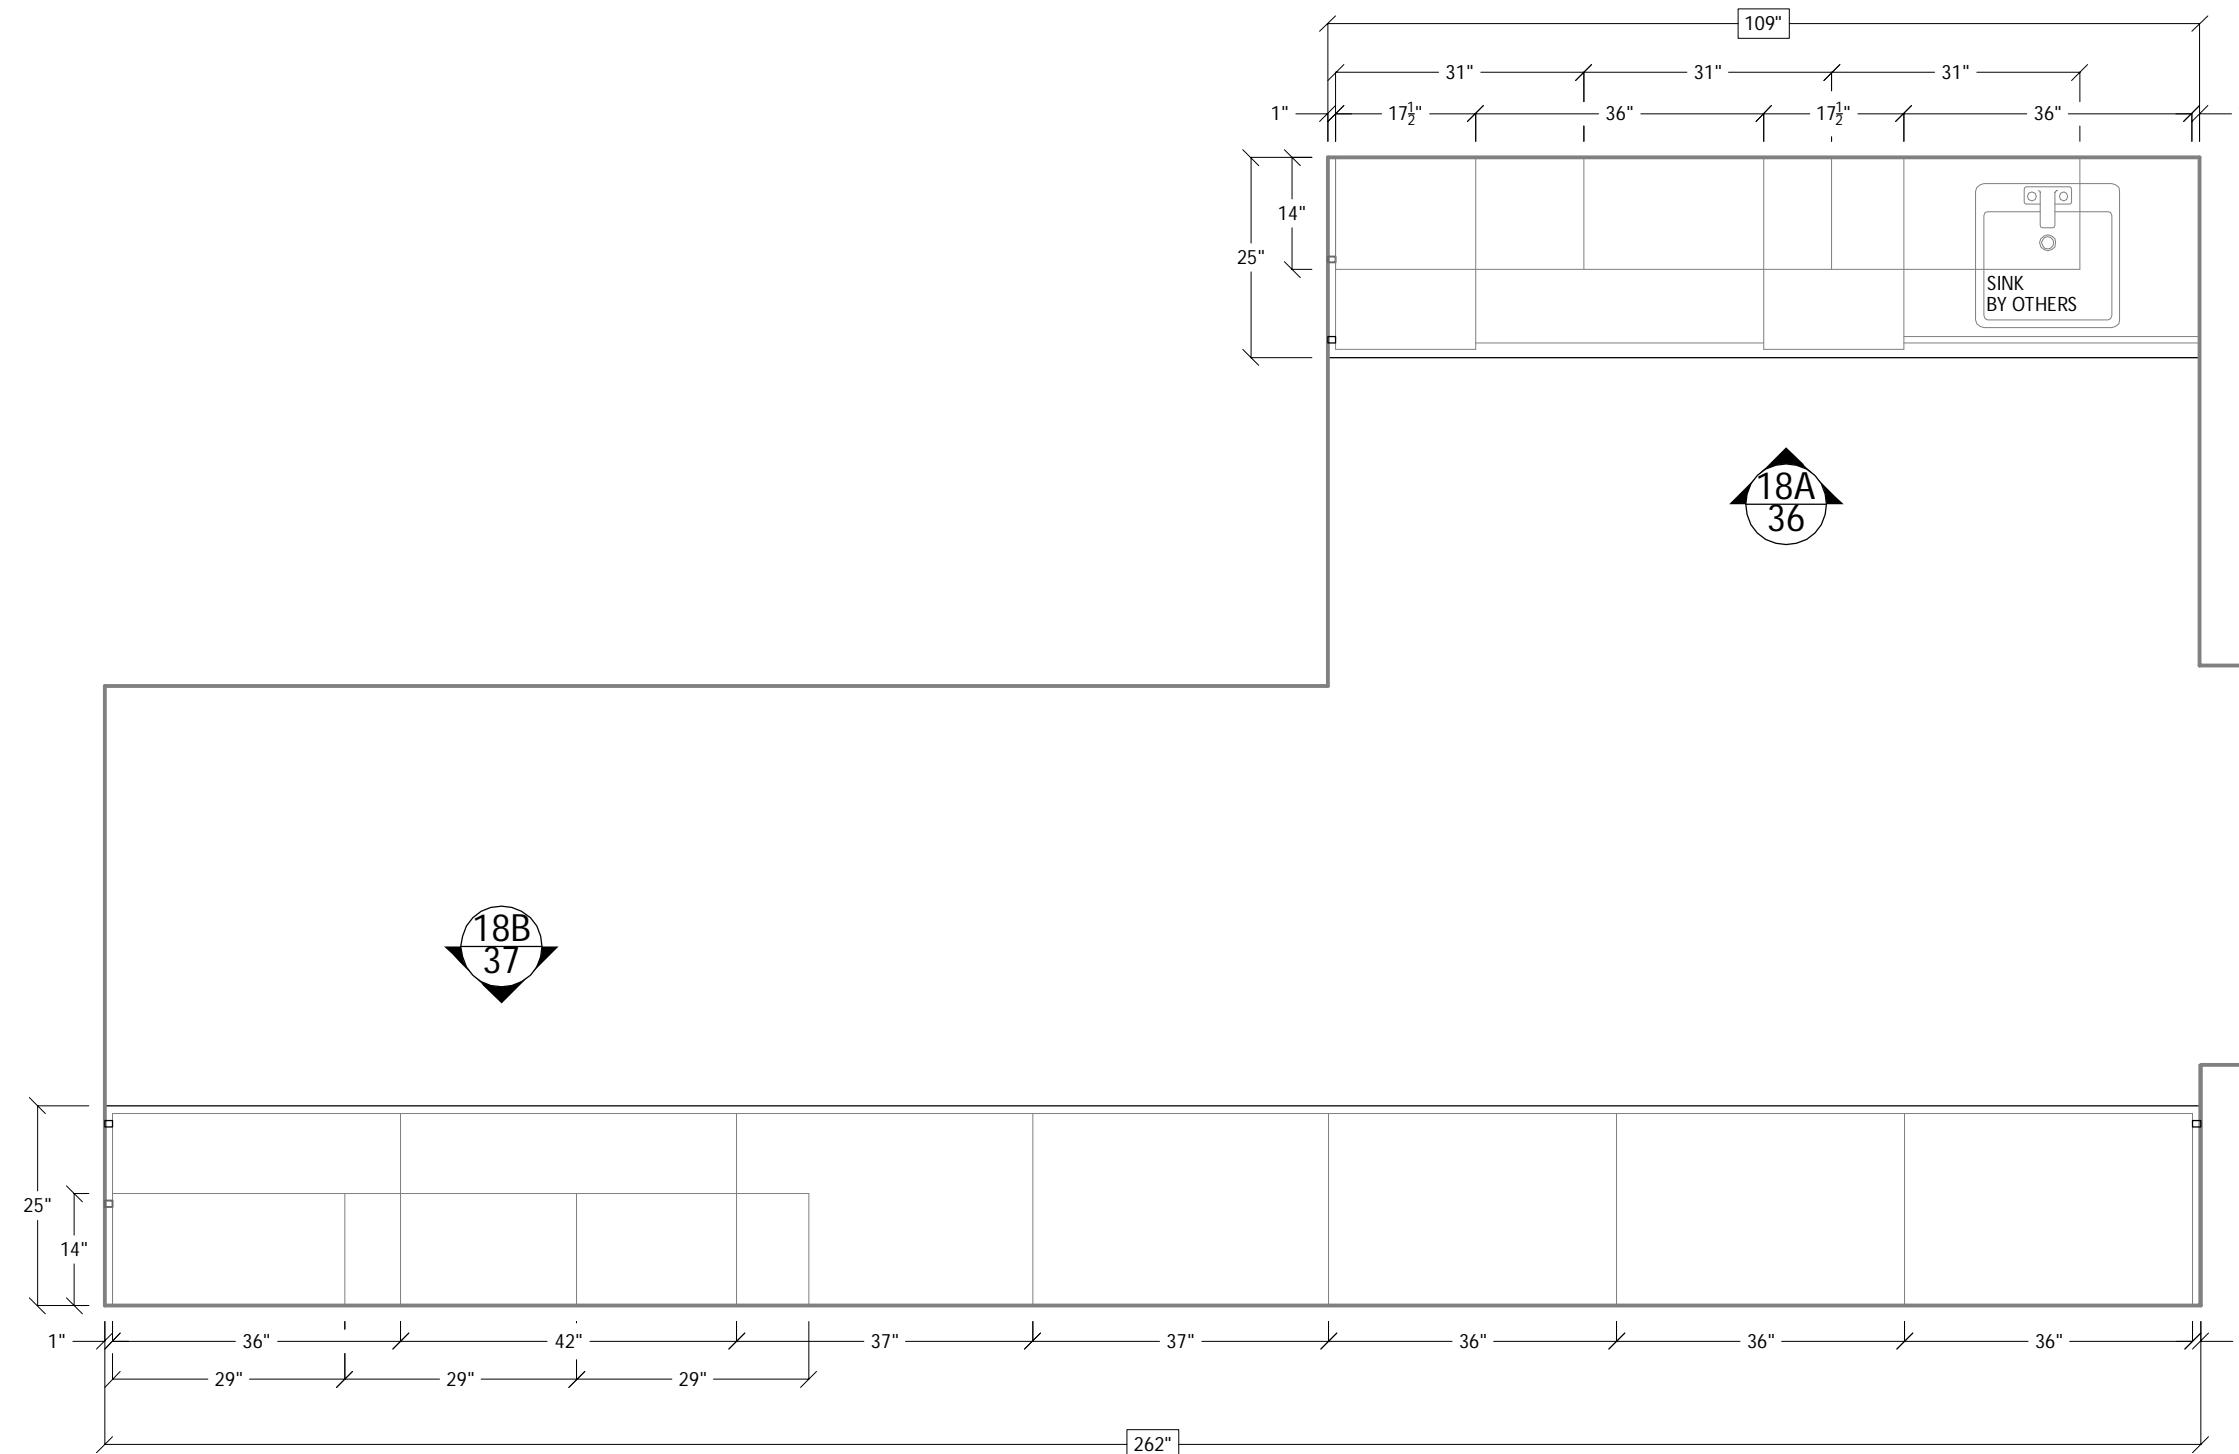

18 PLAN: COPY ROOM #B13

REF: ARCH. PAGE NO. A/A106

SCALE: $\frac{1}{2}$ "=1'-0"

IF SIZE OF SHEET IS NOT 11 X 17, SCALE ACCORDINGLY.

**EVERLAST
WOODWORKING**
2555 N. Argyle, Fresno, California 93727
(559) 292-2448 - FAX (559) 292-3710

PROJECT
NAME:
CUSD PROFESSIONAL LEARNING CENTER

LOCATION:
CLOVIS, CA

SUPER PHONE:

CONTRACTOR/CLIENT
NAME:
CLOVIS UNIFIED SCHOOL DISTRICT

ADDRESS:
1450 HERNDON AVE., CLOVIS, CA 93611

PHONE: (559) 327-9000 FAX:

SCALE:
PROJECT NUMBER: 17052

FILE NAME: F:\MV7\EF\FD\17052


DRAWING NUMBER: 35

DATE: 09/22/17
REVISED: 10/25/17

DRAWN BY: AD REVISED BY: AD

SUBMITTAL SET

IN B13, THE PROVIDED ELEVATION SHOWS ONE OR TWO ADA SINKS WHILE THE CASEWORK SCHEDULE SHOWS ONLY TWO CABINETS AT 1'6" WIDTH EACH

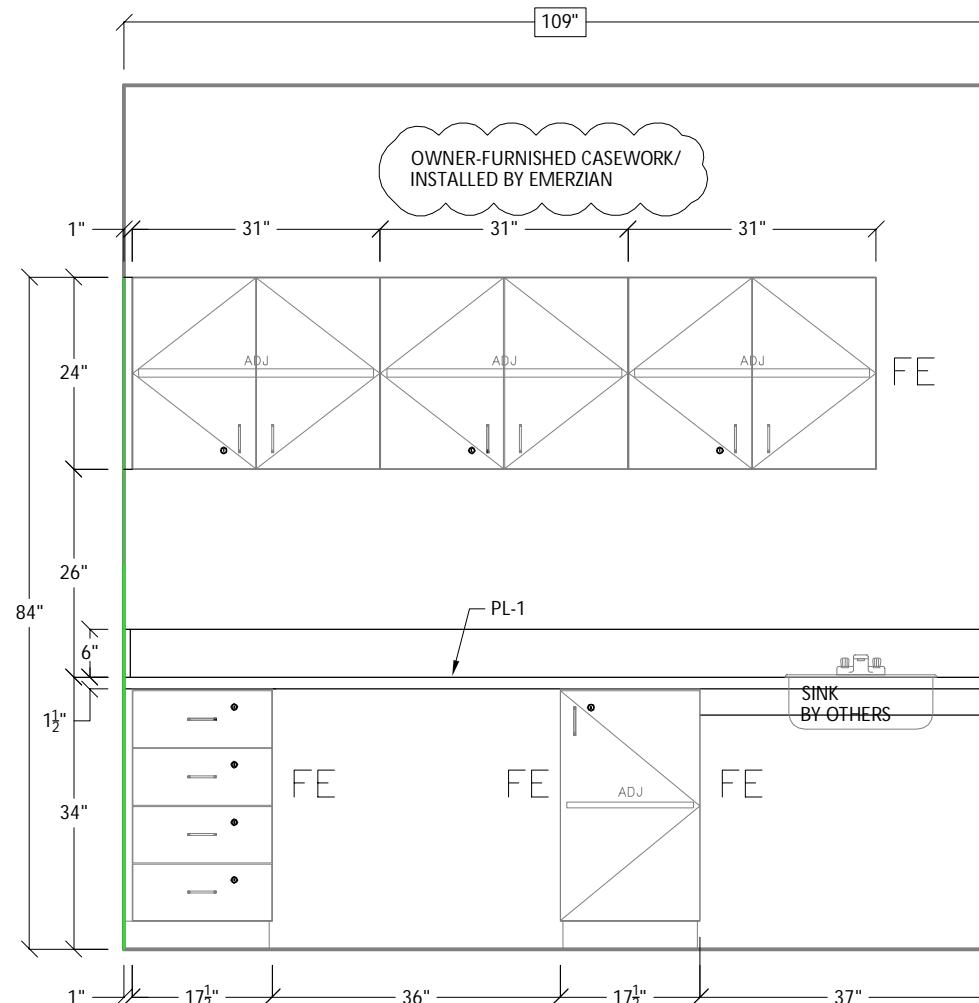

18A ELEVATION: COPY ROOM #B13


REF: ARCH. PAGE NO. B13/A602

SCALE: $\frac{1}{2}^{\prime \prime} = 1'-0^{\prime \prime}$

IF SIZE OF SHEET IS NOT 11 X 17, SCALE ACCORDINGLY.

| |
|---|
| EMERZIAN WOODWORKING |
| 2555 N. Argyle, Fresno, California 93727 (559) 292-2448 - FAX (559) 292-3710 |

| | | | |
|--|---|---|---|
| PROJECT NAME: CUSD PROFESSIONAL LEARNING CENTER | CONTRACTOR/CLIENT NAME: CLOVIS UNIFIED SCHOOL DISTRICT | SCALE: | DATE: 09/22/17 |
| LOCATION: CLOVIS, CA | ADDRESS: 1450 HERNDON AVE., CLOVIS, CA 93611 | PROJECT NUMBER: 17052 | REVISED: 10/25/17 |
| SUPER PHONE: | PHONE: (559) 327-9000 FAX: (559) 327-9000 | FILE NAME: F:\MV7\EF\FD\17052 | DRAWN BY: AD REVISED BY: AD |
| | | DRAWING NUMBER: 36 | SUBMITTAL SET |

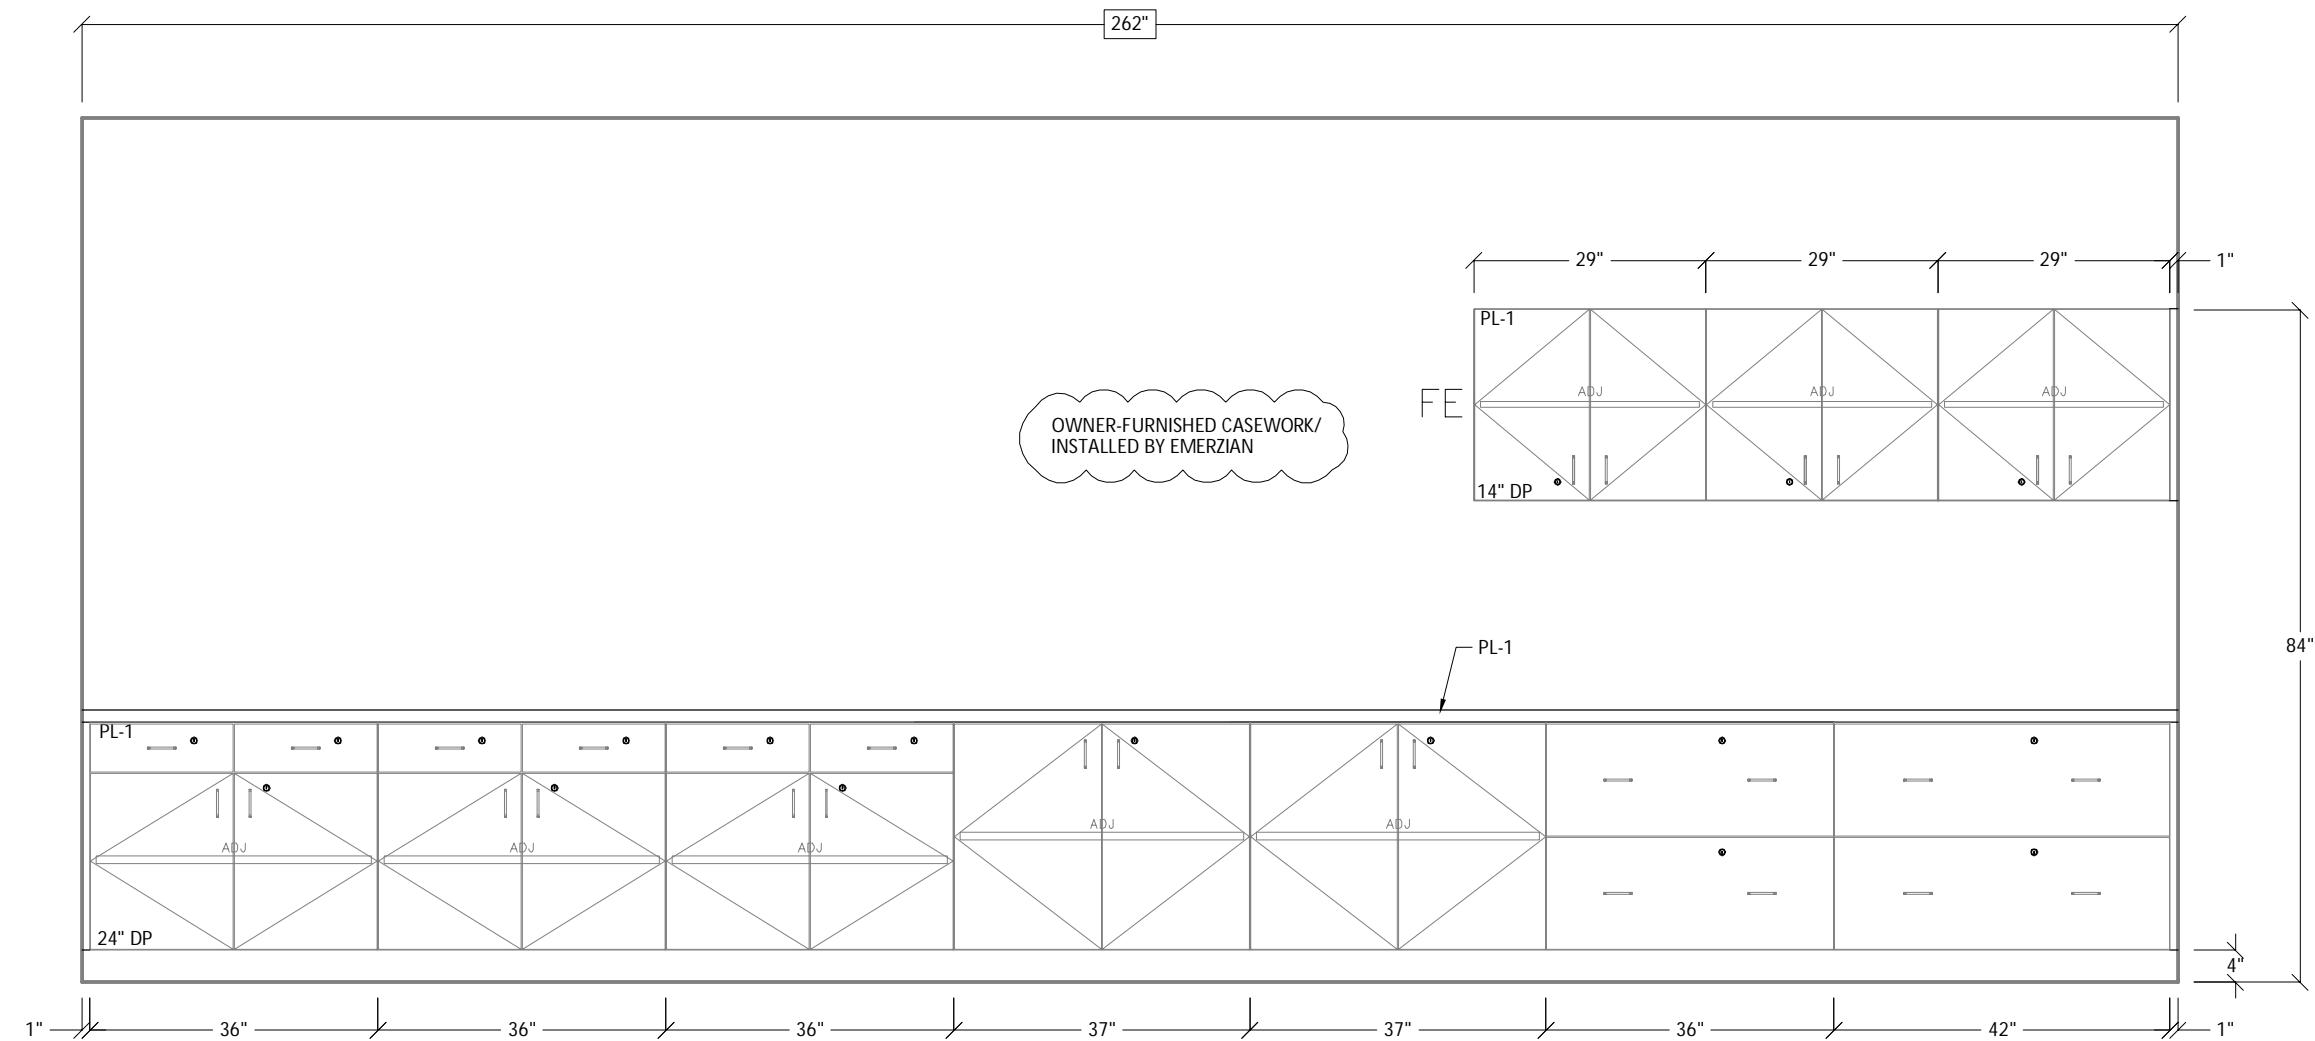

18B ELEVATION: COPY ROOM #B13



REF: ARCH. PAGE NO.B13/A601

SCALE: $\frac{1}{2}'' = 1'-0''$

IF SIZE OF SHEET IS NOT 11 X 17, SCALE ACCORDINGLY.

| |
|---|
| EMERZIAN WOODWORKING |
| 2555 N. Argyle, Fresno, California 93727 (559) 292-2448 - FAX (559) 292-3710 |

| | | | |
|--|---|---|---|
| PROJECT NAME: CUSD PROFESSIONAL LEARNING CENTER | CONTRACTOR/CLIENT NAME: CLOVIS UNIFIED SCHOOL DISTRICT | SCALE: | DATE: |
| LOCATION: CLOVIS, CA | ADDRESS: 1450 HERNDON AVE., CLOVIS, CA 93611 | PROJECT NUMBER: 17052 | REVISED: 10/25/17 |
| SUPER PHONE: | PHONE: (559) 327-9000 FAX: | FILE NAME: F:\MV7\EF\FD\17052 | DRAWN BY: AD REVISED BY: AD |
| | | DRAWING NUMBER: 37 | SUBMITTAL SET |

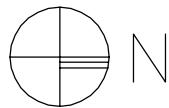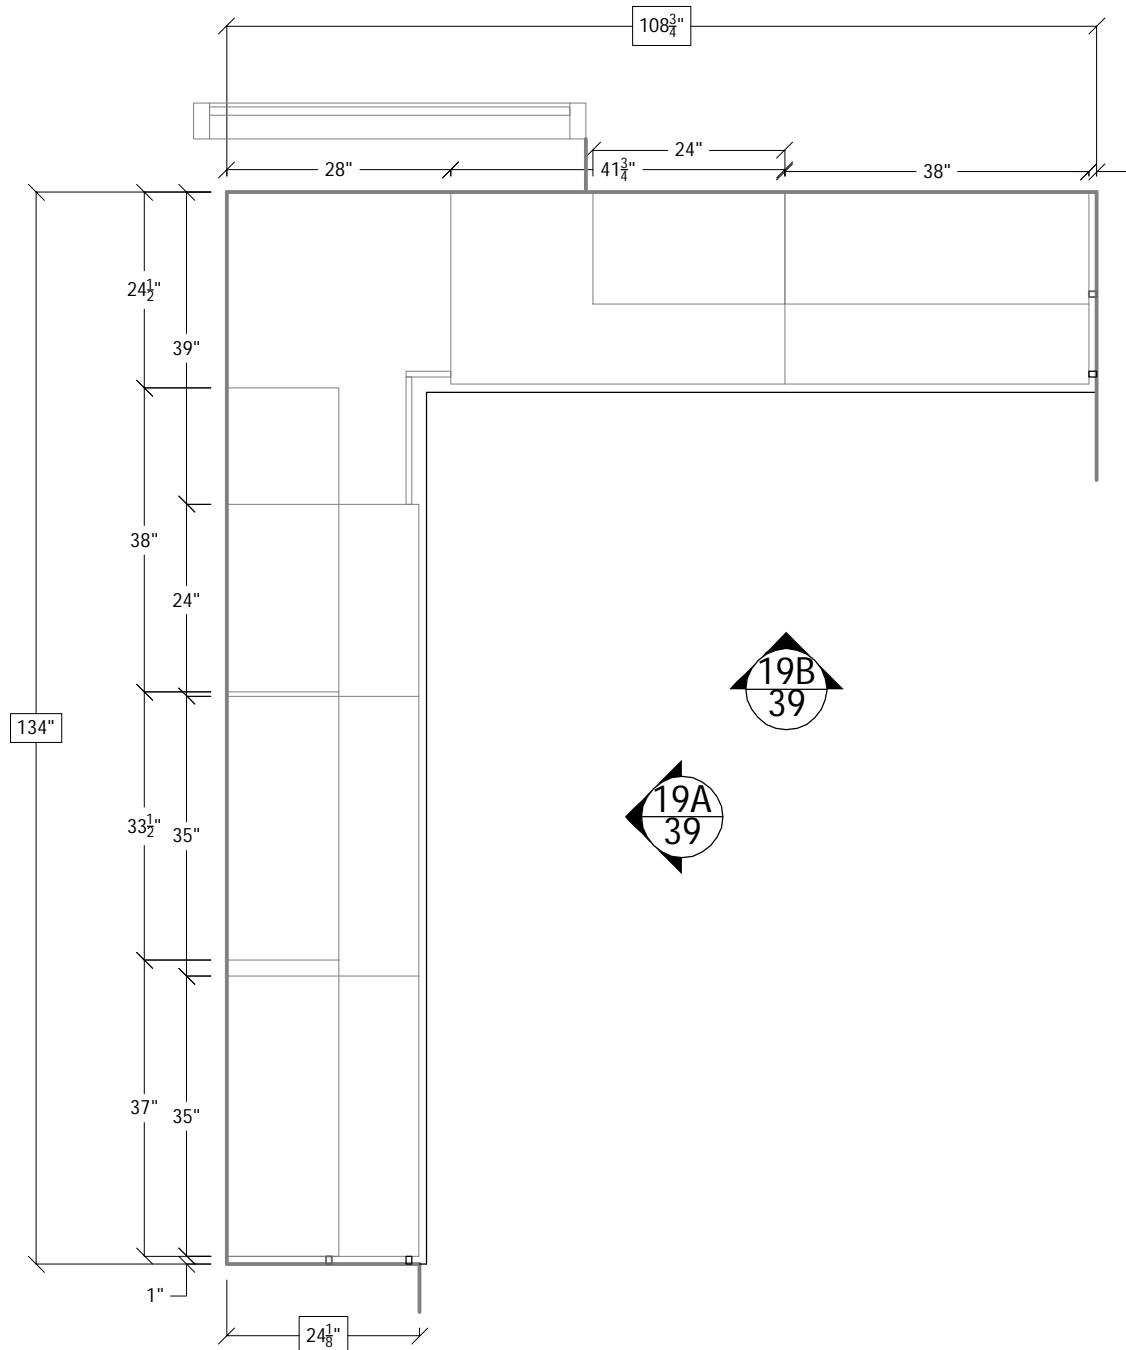

19

PLAN: WORKROOM #C07

REF: ARCH. PAGE NO. A/A106

SCALE: $\frac{1}{2}'' = 1'-0''$

IF SIZE OF SHEET IS NOT 11 X 17, SCALE ACCORDINGLY.



2555 N. Argyle, Fresno, California 93727
(559) 292-2448 - FAX (559) 292-3710

PROJECT
NAME:
CUSD PROFESSIONAL LEARNING CENTER

LOCATION:
CLOVIS, CA

SUPER PHONE:

CONTRACTOR/CLIENT
NAME:
CLOVIS UNIFIED SCHOOL DISTRICT

ADDRESS:
1450 HERNDON AVE., CLOVIS, CA 93611

PHONE: (559) 327-9000 FAX:

SCALE:

PROJECT NUMBER:


FILE NAME:

DATE: 09/22/17

REVISED: 10/25/17

DRAWN BY: AD REVISED BY: AD


SUBMITTAL SET

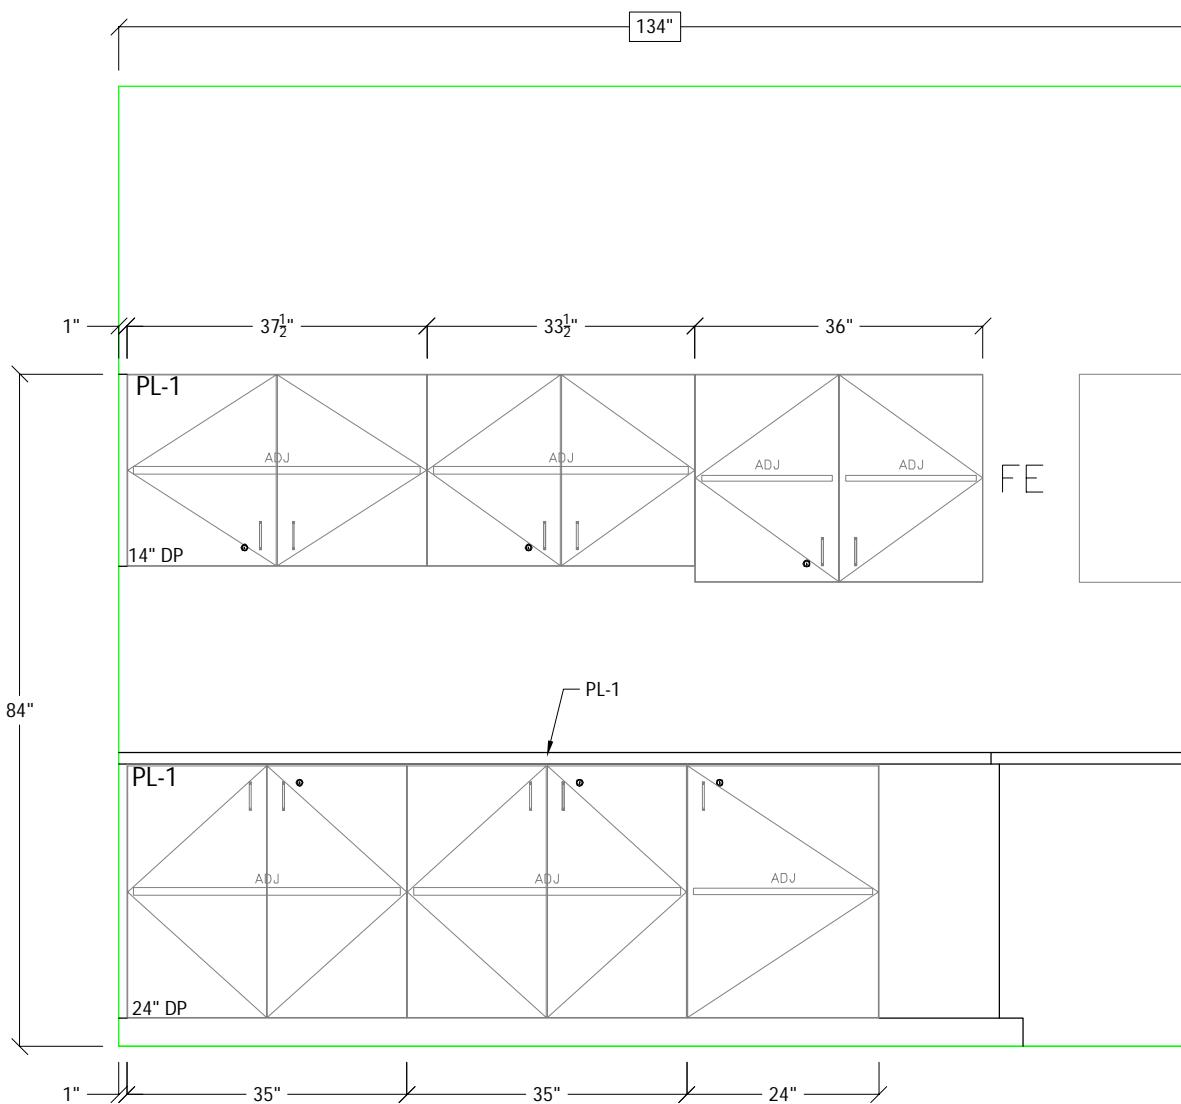

19A ELEVATION: WORK ROOM #C07

REF: ARCH. PAGE NO. C/A601

SCALE: $\frac{1}{2}''=1'-0''$


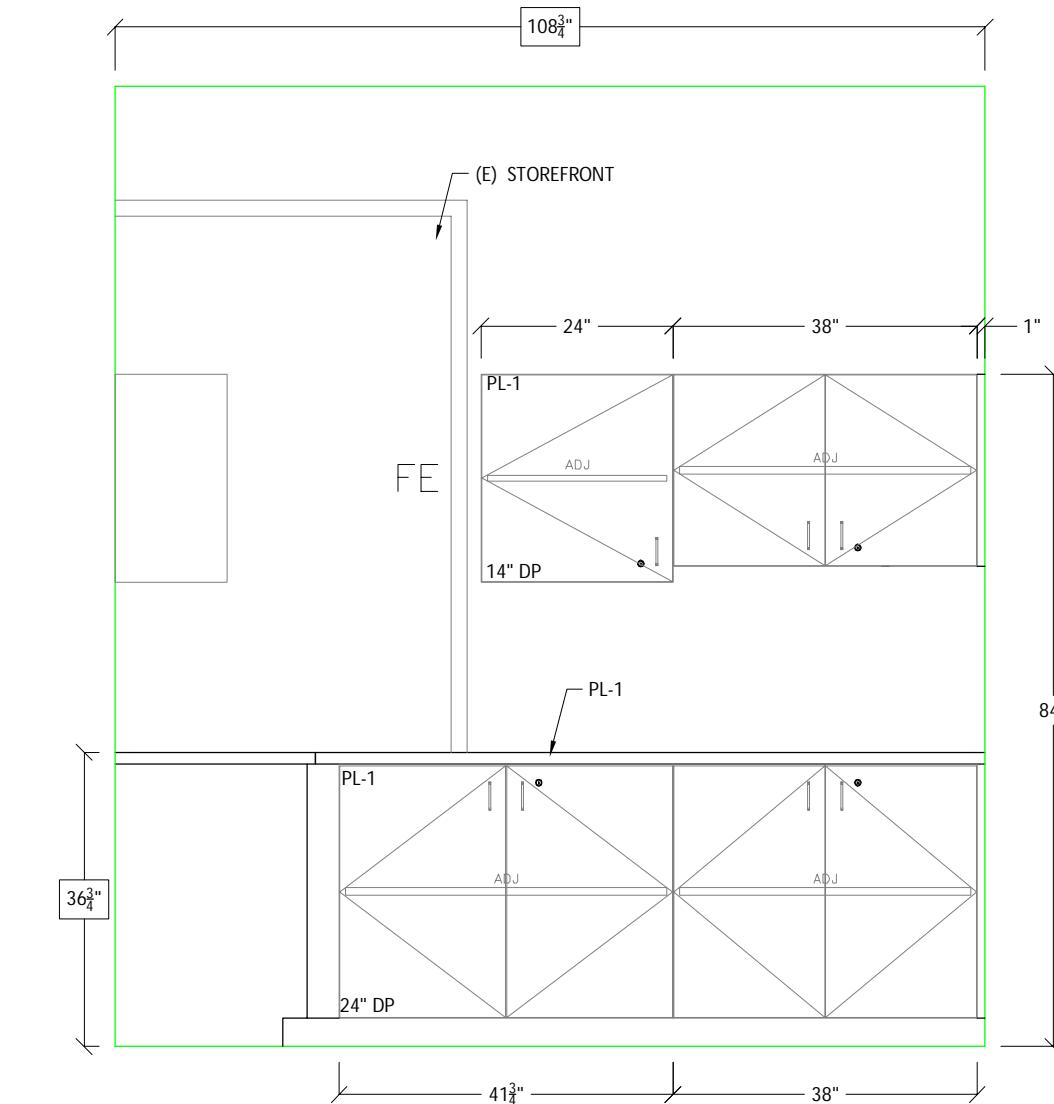


19B ELEVATION: WORK ROOM #C07

REF: ARCH. PAGE NO. C/A601

SCALE: $\frac{1}{2}''=1'-0''$

IF SIZE OF SHEET IS NOT 11 X 17, SCALE ACCORDINGLY.

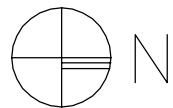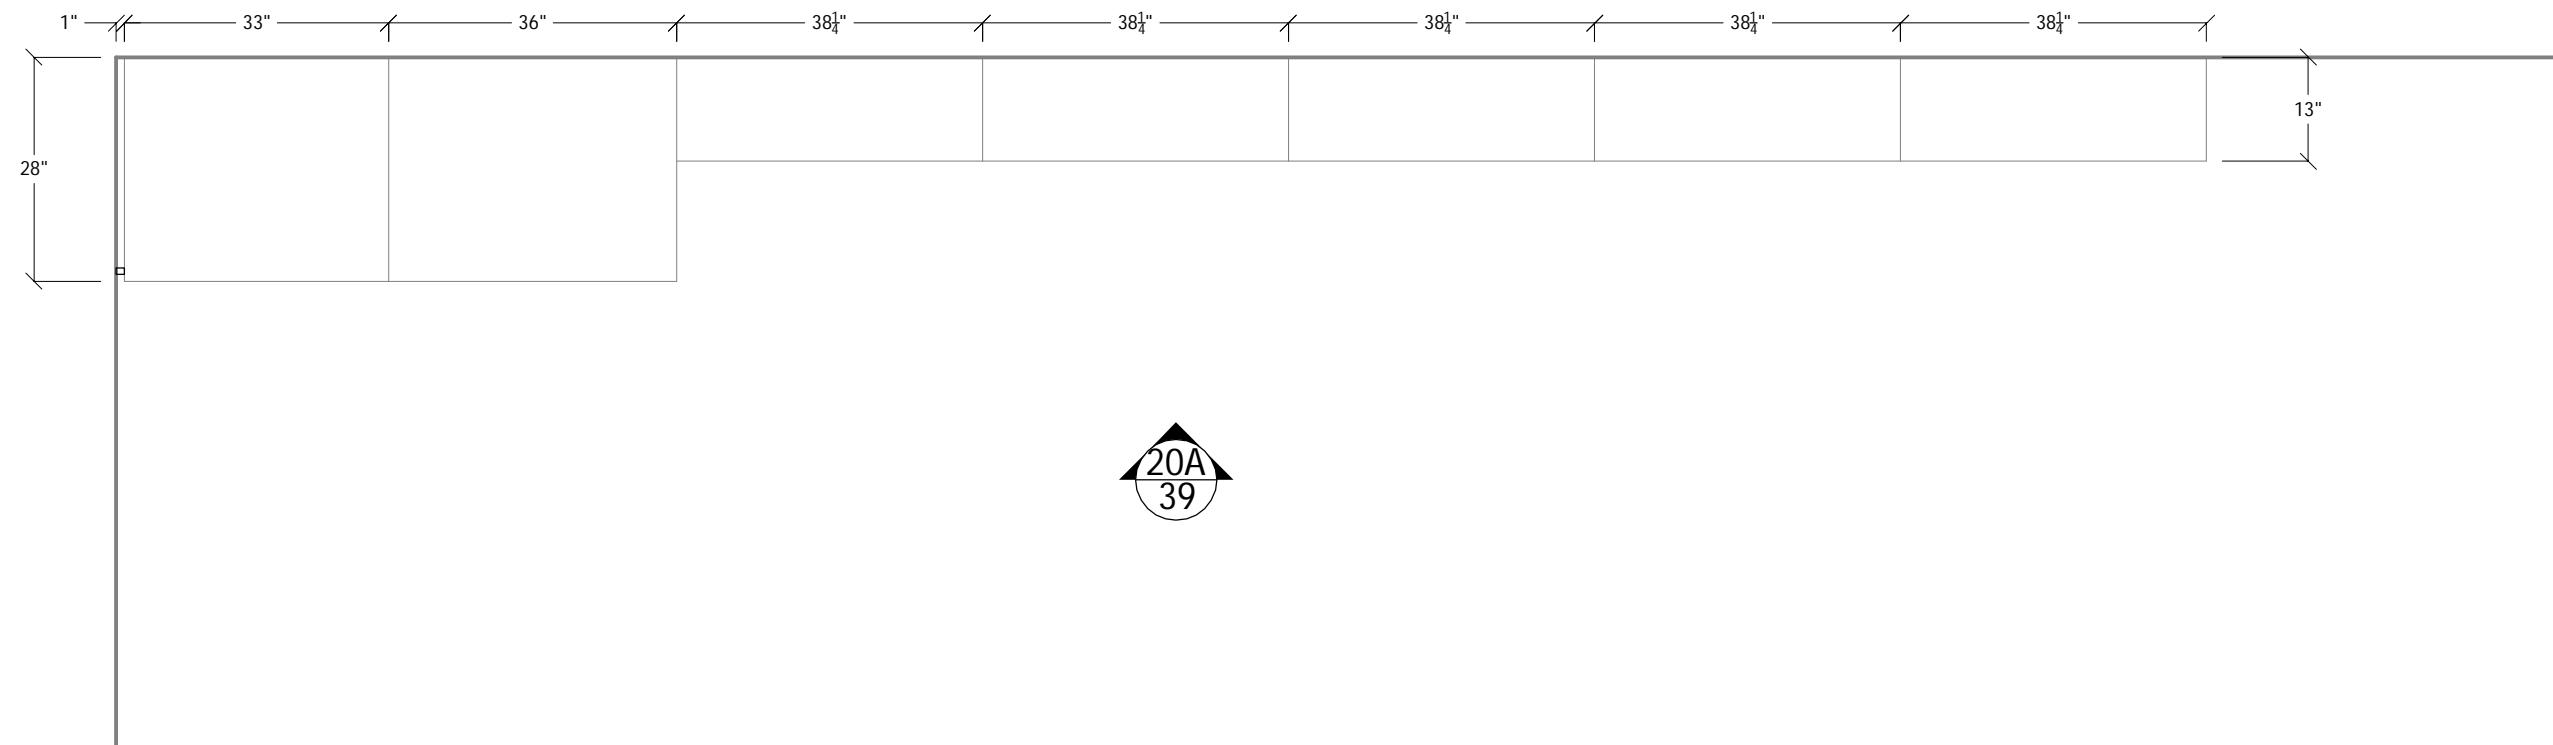

20

PLAN: STAFF DEVELOPMENT MEETING ROOM 2 #F02

REF: ARCH. PAGE NO. A/A106


SCALE: $\frac{1}{2}'' = 1'-0''$

IF SIZE OF SHEET IS NOT 11 X 17, SCALE ACCORDINGLY.

**EVERLAST
WOODWORKING**
2555 N. Argyle, Fresno, California 93727
(559) 292-2448 - FAX (559) 292-3710

| | | | |
|--|---|---|-----------------------------|
| PROJECT NAME: CUSD PROFESSIONAL LEARNING CENTER | CONTRACTOR/CLIENT NAME: CLOVIS UNIFIED SCHOOL DISTRICT | SCALE: | DATE: |
| | | PROJECT NUMBER: | 09/22/17 |
| LOCATION: CLOVIS, CA | ADDRESS: 1450 HERNDON AVE., CLOVIS, CA 93611 | FILE NAME: F:\MV7\EF\FD\17052 | REVISED: 10/25/17 |
| SUPER PHONE: | PHONE: (559) 327-9000 FAX: | DRAWING NUMBER: 40 | DRAWN BY: AD REVISED BY: AD |

OWNER-FURNISHED CASEWORK/
INSTALLED BY EMERZIAN

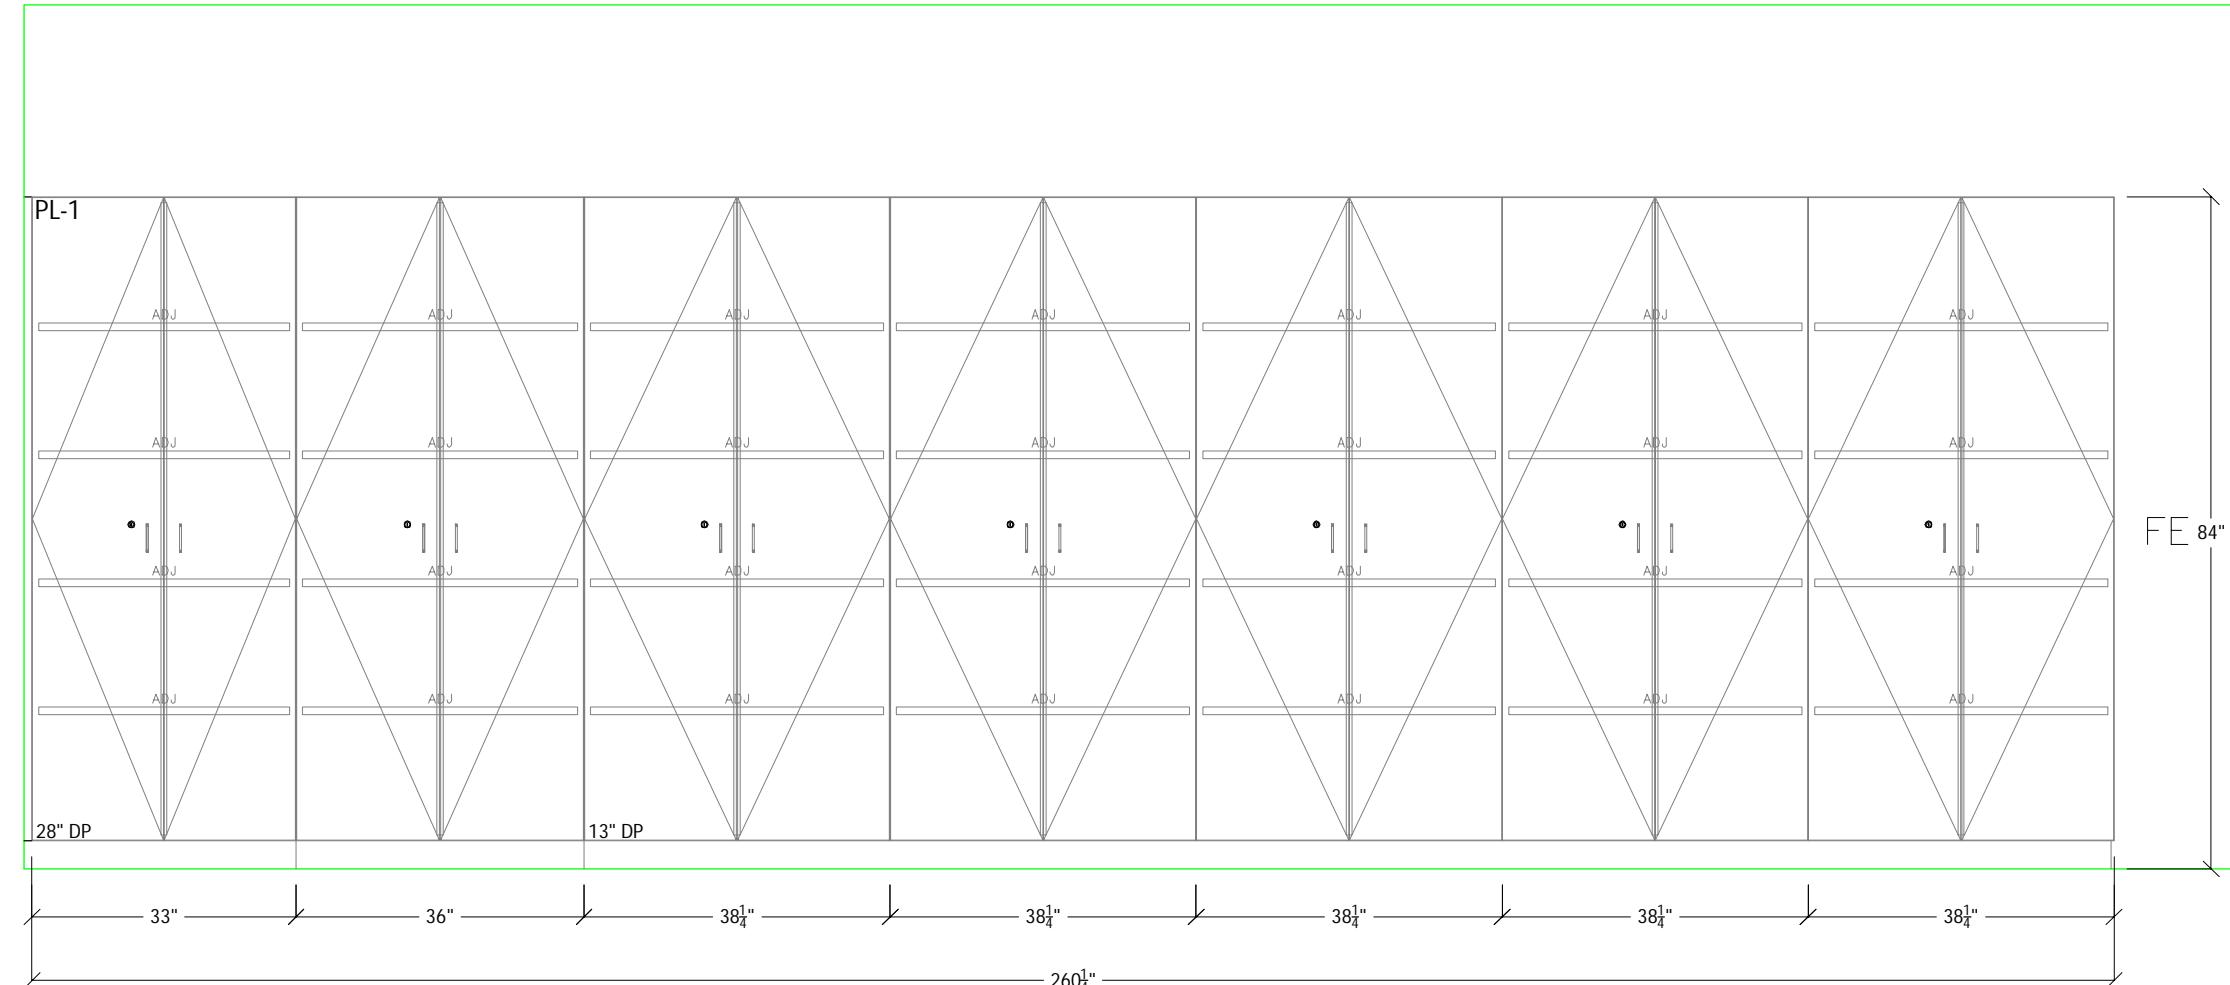

20A

PLAN: STAFF DEVELOPMENT MEETING ROOM 2 #F02


REF: ARCH. PAGE NO. F/A601

SCALE: $\frac{1}{2}'' = 1'-0''$

IF SIZE OF SHEET IS NOT 11 X 17, SCALE ACCORDINGLY.

EMERZIAN
WOODWORKING
2555 N. Argyle, Fresno, California 93727
(559) 292-2448 - FAX (559) 292-3710


| | | | |
|---|--|-------------------------------|-----------------------------|
| PROJECT NAME: CUSD PROFESSIONAL LEARNING CENTER | CONTRACTOR/CLIENT NAME: CLOVIS UNIFIED SCHOOL DISTRICT | SCALE: | DATE: |
| | | PROJECT NUMBER: 17052 | REVISED: 10/25/17 |
| LOCATION: CLOVIS, CA | ADDRESS: 1450 HERNDON AVE., CLOVIS, CA 93611 | FILE NAME: F:\MV7\EF\FD\17052 | DRAWN BY: AD REVISED BY: AD |
| SUPER PHONE: | PHONE: (559) 327-9000 FAX: | DRAWING NUMBER: 41 | SUBMITTAL SET |

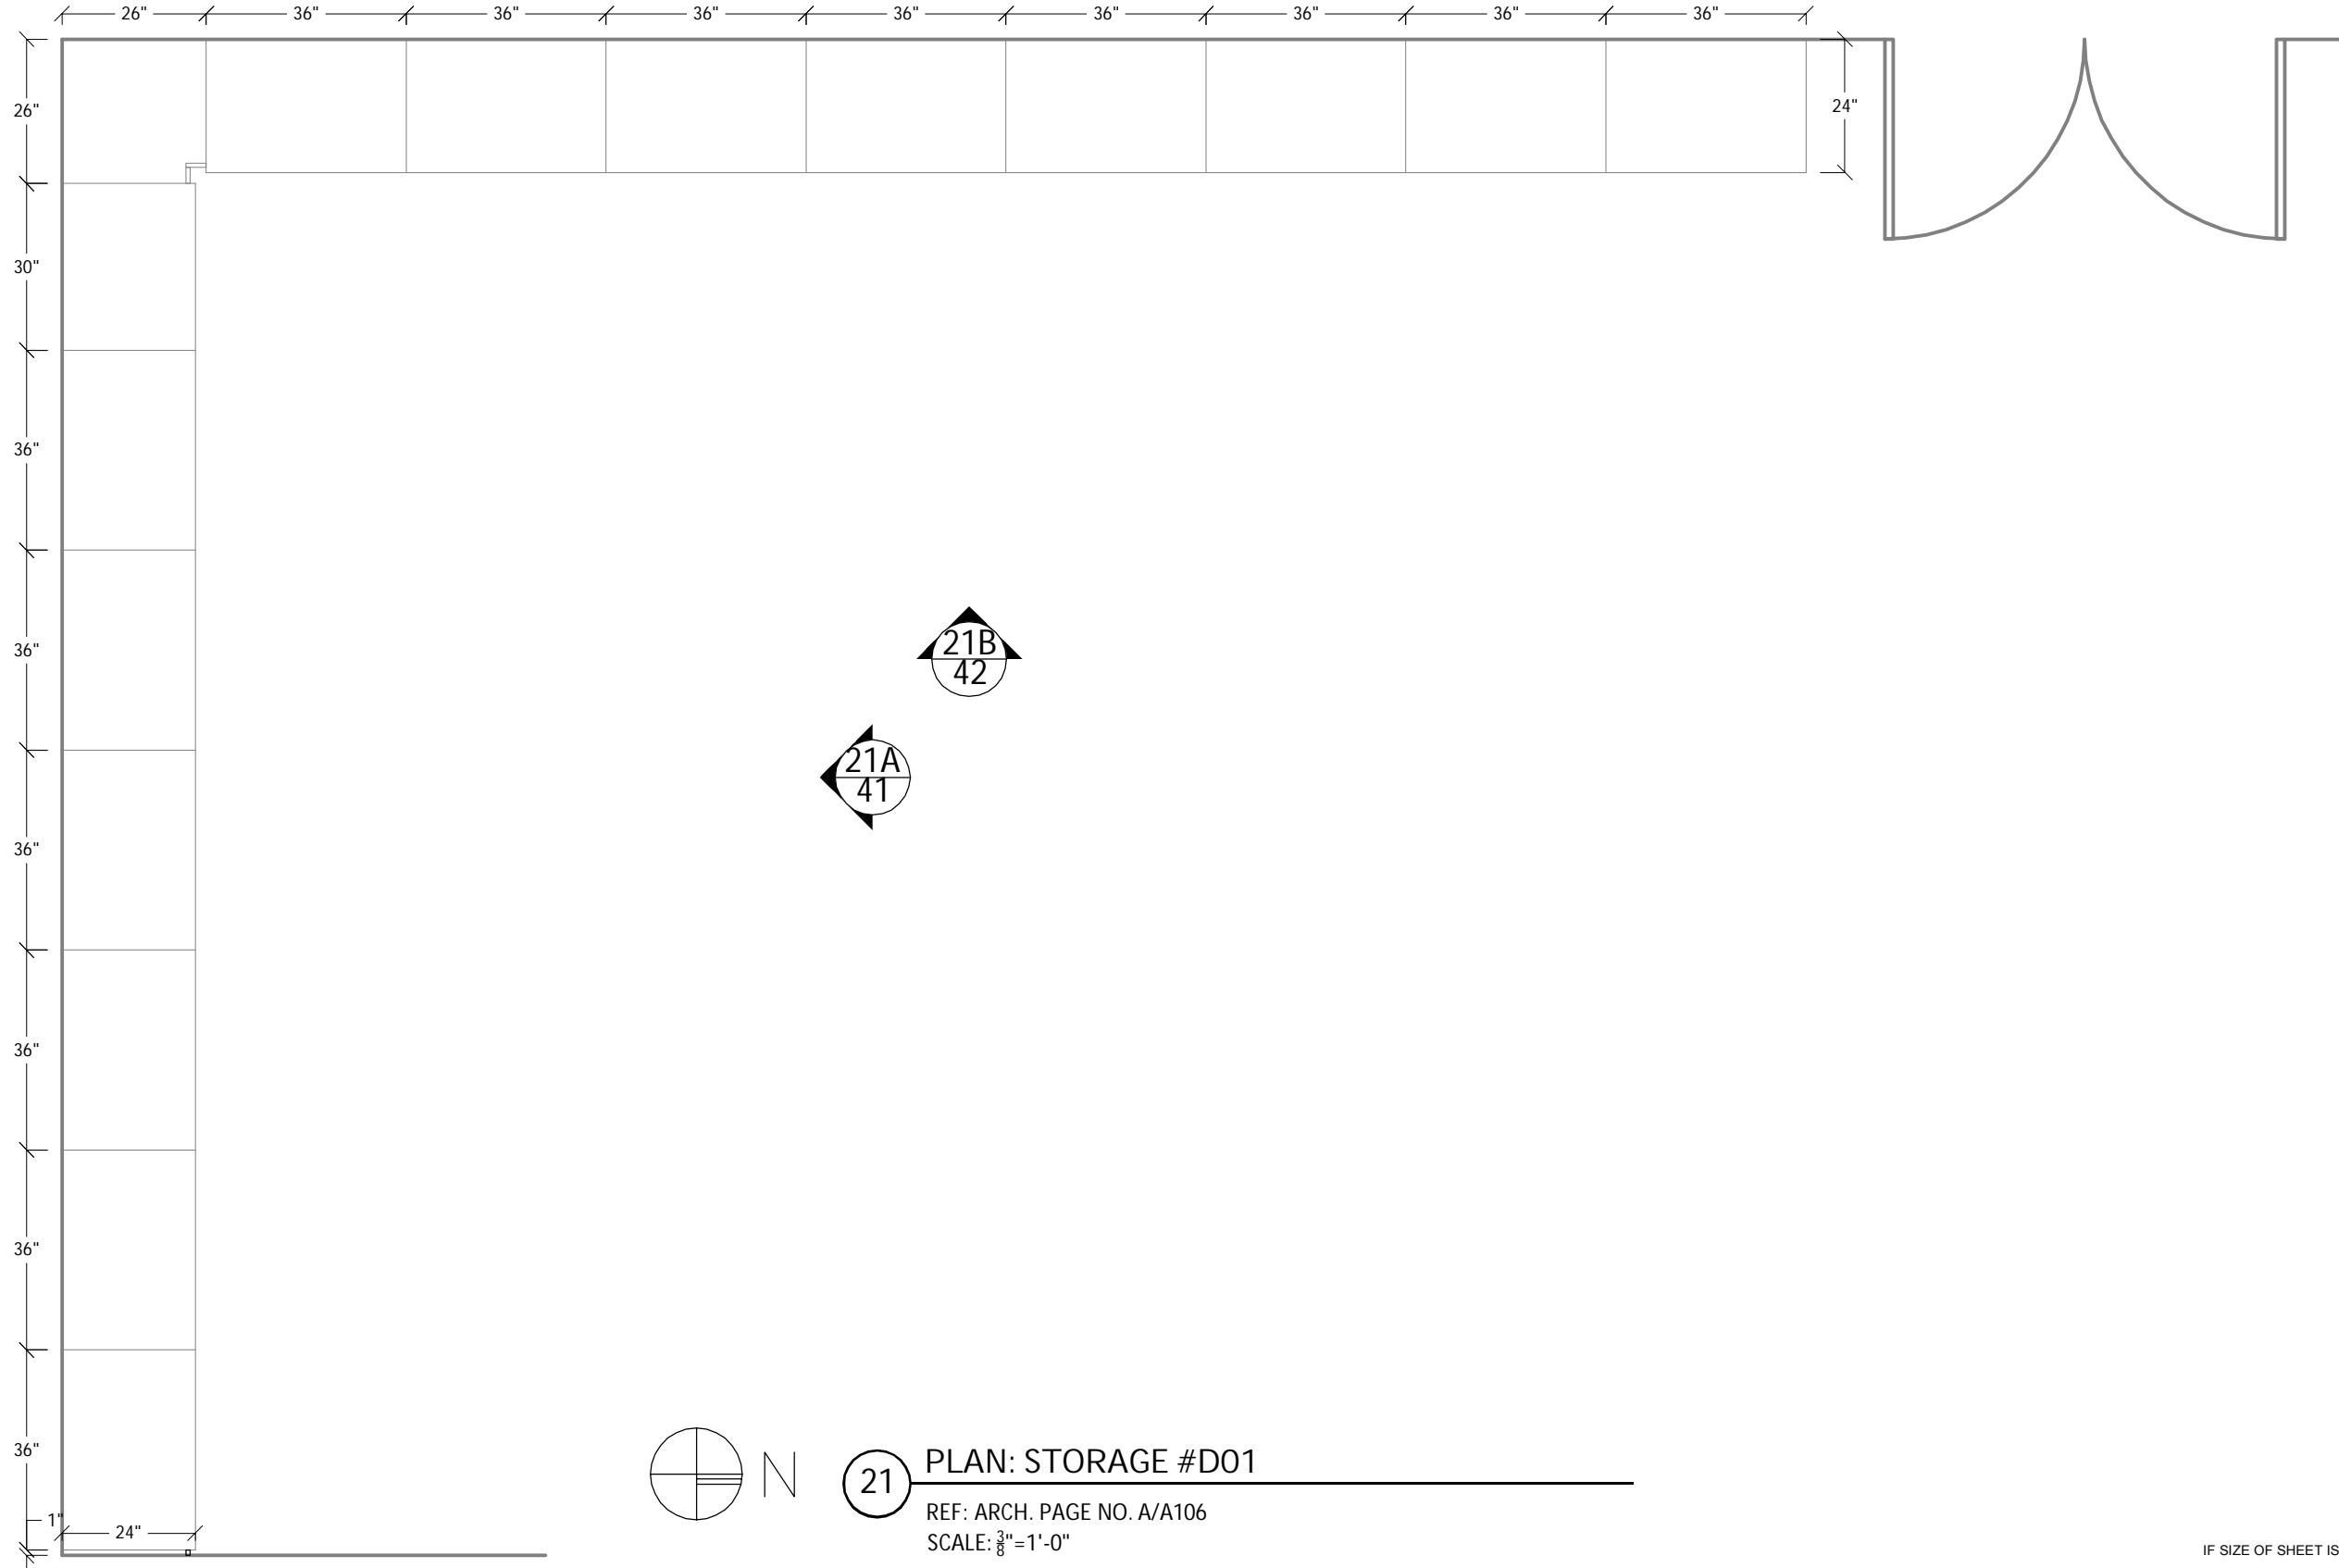

EVERLAST
WOODWORKING
2555 N. Argyle, Fresno, California 93727
(559) 292-2448 - FAX (559) 292-3710

| | | | |
|--|---|---|---|
| PROJECT NAME: CUSD PROFESSIONAL LEARNING CENTER | CONTRACTOR/CLIENT NAME: CLOVIS UNIFIED SCHOOL DISTRICT | SCALE: | DATE: |
| LOCATION: CLOVIS, CA | ADDRESS: 1450 HERNDON AVE., CLOVIS, CA 93611 | PROJECT NUMBER: 17052 | REVISED: 10/25/17 |
| SUPER PHONE: | PHONE: (559) 327-9000 FAX: | FILE NAME: F:\MV7\EF\FD\17052 | DRAWN BY: AD REVISED BY: AD |
| | | DRAWING NUMBER: 42 | SUBMITTAL SET |

OWNER-FURNISHED CASEWORK/
INSTALLED BY EMERZIAN

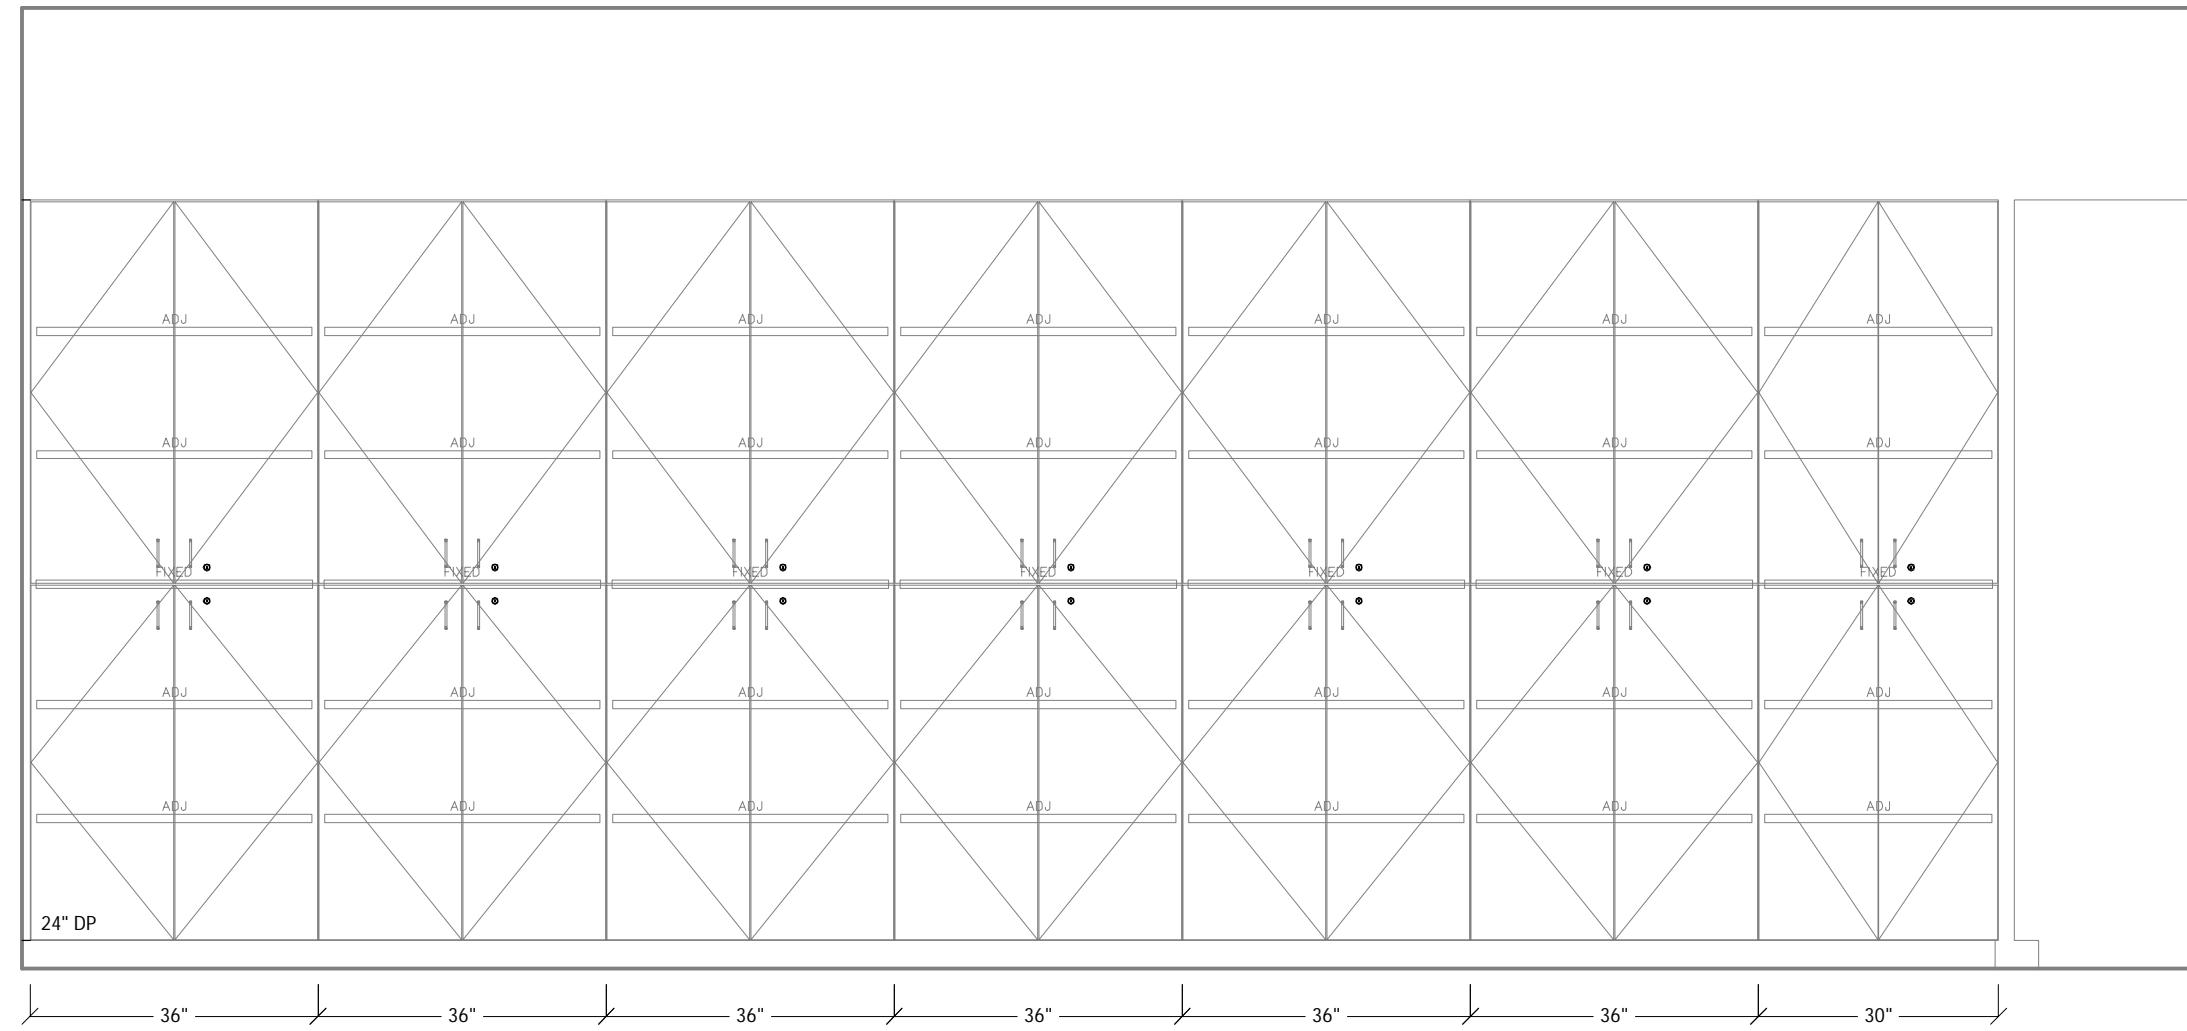

21A PLAN: STORAGE #D01

REF: ARCH. PAGE NO. D/A601


SCALE: $\frac{1}{2}'' = 1'-0''$

IF SIZE OF SHEET IS NOT 11 X 17, SCALE ACCORDINGLY.

EMERZIAN
WOODWORKING
2555 N. Argyle, Fresno, California 93727
(559) 292-2448 - FAX (559) 292-3710

| | | | |
|---|--|-------------------------------|-----------------------------|
| PROJECT NAME: CUSD PROFESSIONAL LEARNING CENTER | CONTRACTOR/CLIENT NAME: CLOVIS UNIFIED SCHOOL DISTRICT | SCALE: | DATE: |
| | | PROJECT NUMBER: 17052 | REVISED: 10/25/17 |
| LOCATION: CLOVIS, CA | ADDRESS: 1450 HERNDON AVE., CLOVIS, CA 93611 | FILE NAME: F:\MV7\EF\FD\17052 | DRAWN BY: AD REVISED BY: AD |
| SUPER PHONE: | PHONE: (559) 327-9000 FAX: | DRAWING NUMBER: 43 | SUBMITTAL SET |

OWNER-FURNISHED CASEWORK/
INSTALLED BY EMERZIAN

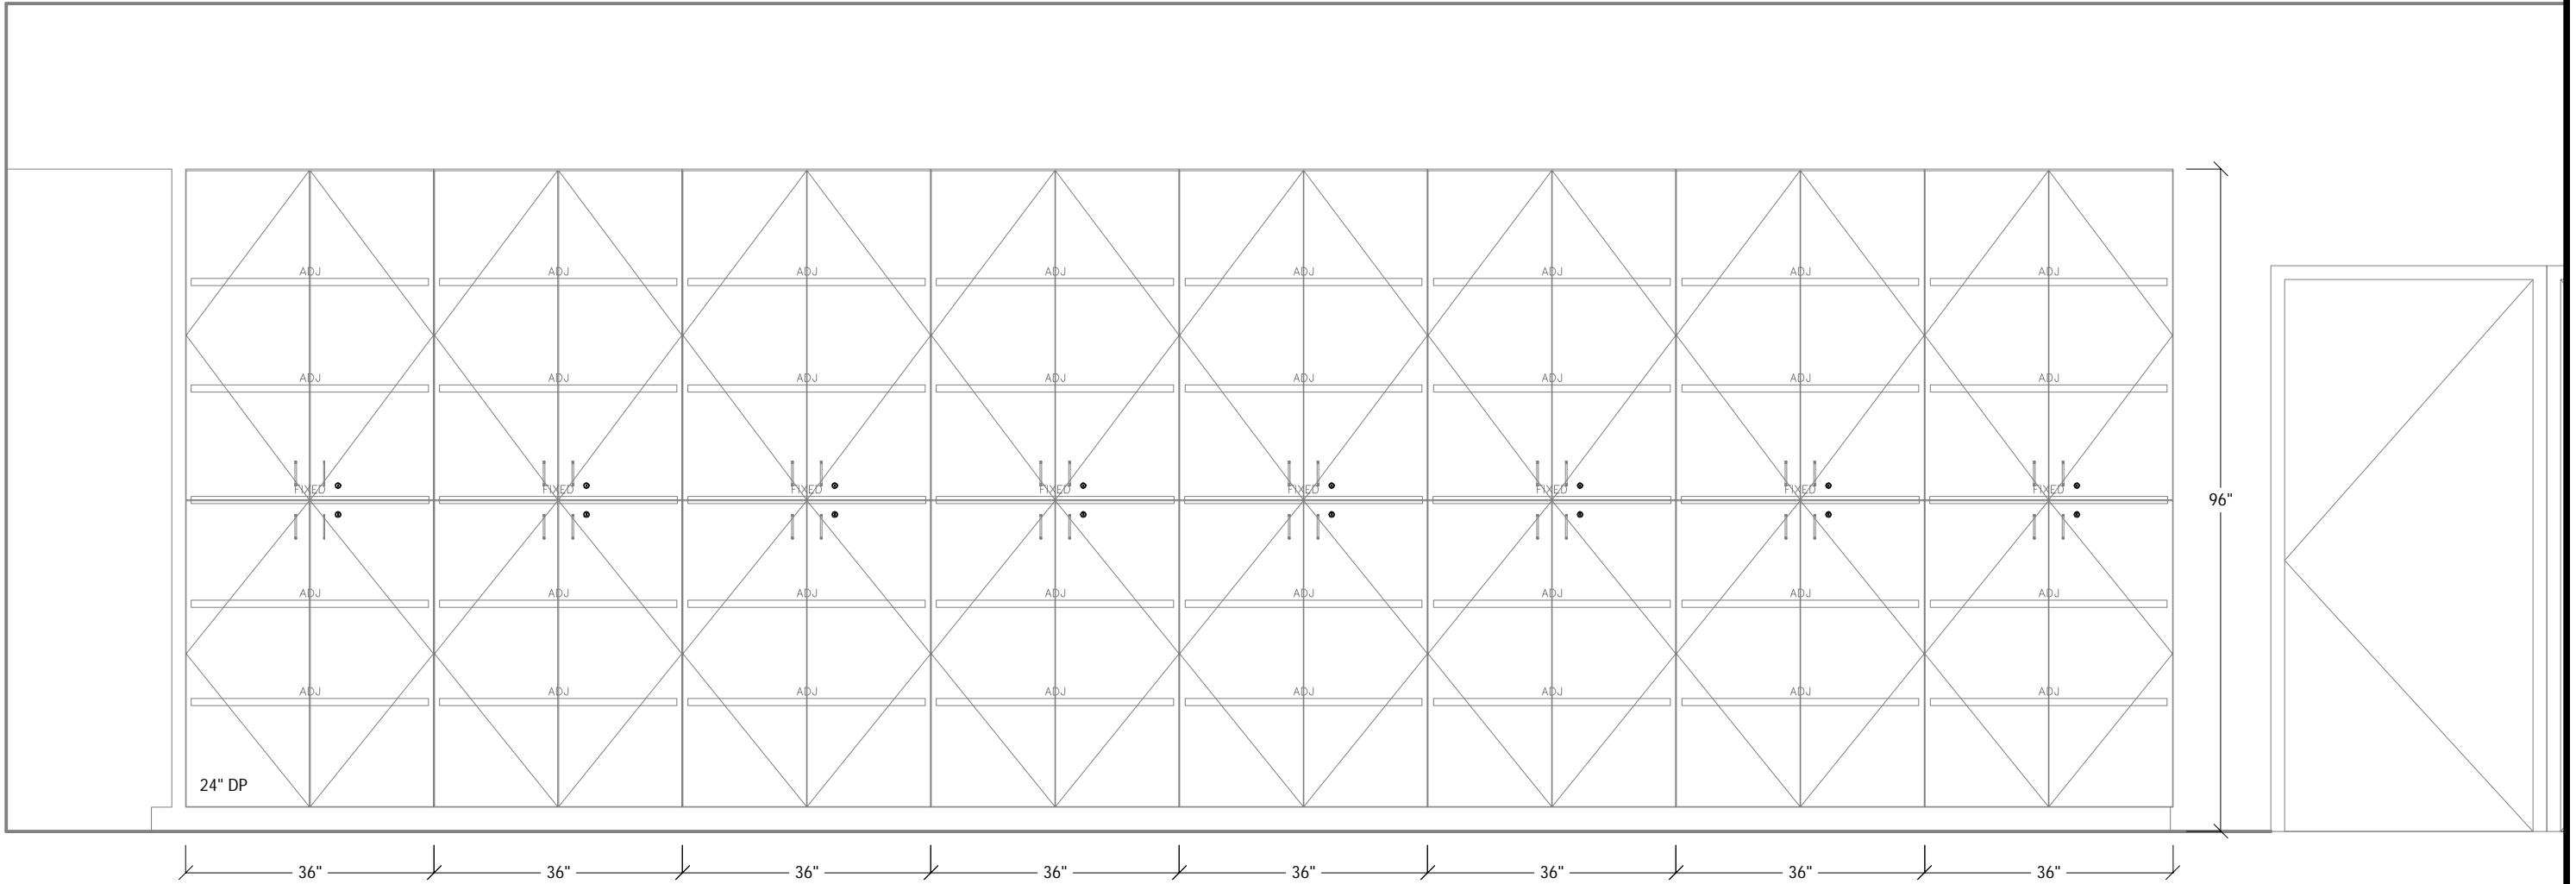

21B PLAN: STORAGE #D01


REF: ARCH. PAGE NO. D/A601

SCALE: $\frac{1}{2}'' = 1'-0''$


IF SIZE OF SHEET IS NOT 11 X 17, SCALE ACCORDINGLY.

| |
|---|
| EMERZIAN WOODWORKING |
| 2555 N. Argyle, Fresno, California 93727 (559) 292-2448 - FAX (559) 292-3710 |

| | | | |
|--|---|---|---|
| PROJECT NAME: CUSD PROFESSIONAL LEARNING CENTER | CONTRACTOR/CLIENT NAME: CLOVIS UNIFIED SCHOOL DISTRICT | SCALE: | DATE: |
| LOCATION: CLOVIS, CA | ADDRESS: 1450 HERNDON AVE., CLOVIS, CA 93611 | PROJECT NUMBER: 17052 | REVISED: 10/25/17 |
| SUPER PHONE: | PHONE: (559) 327-9000 FAX: | FILE NAME: F:\MV7\EF\FD\17052 | DRAWN BY: AD REVISED BY: AD |
| | | DRAWING NUMBER: 44 | SUBMITTAL SET |

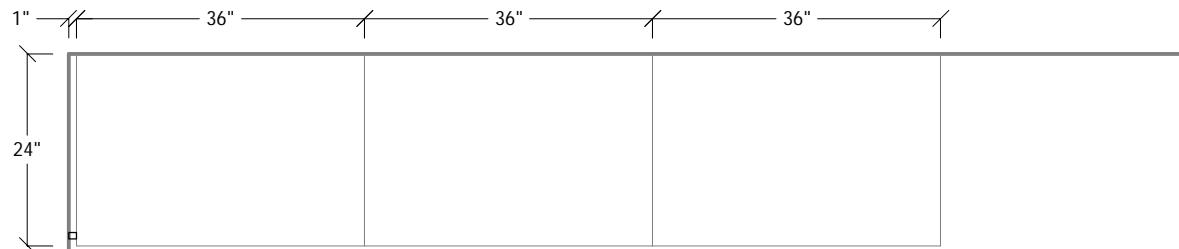

22A
-

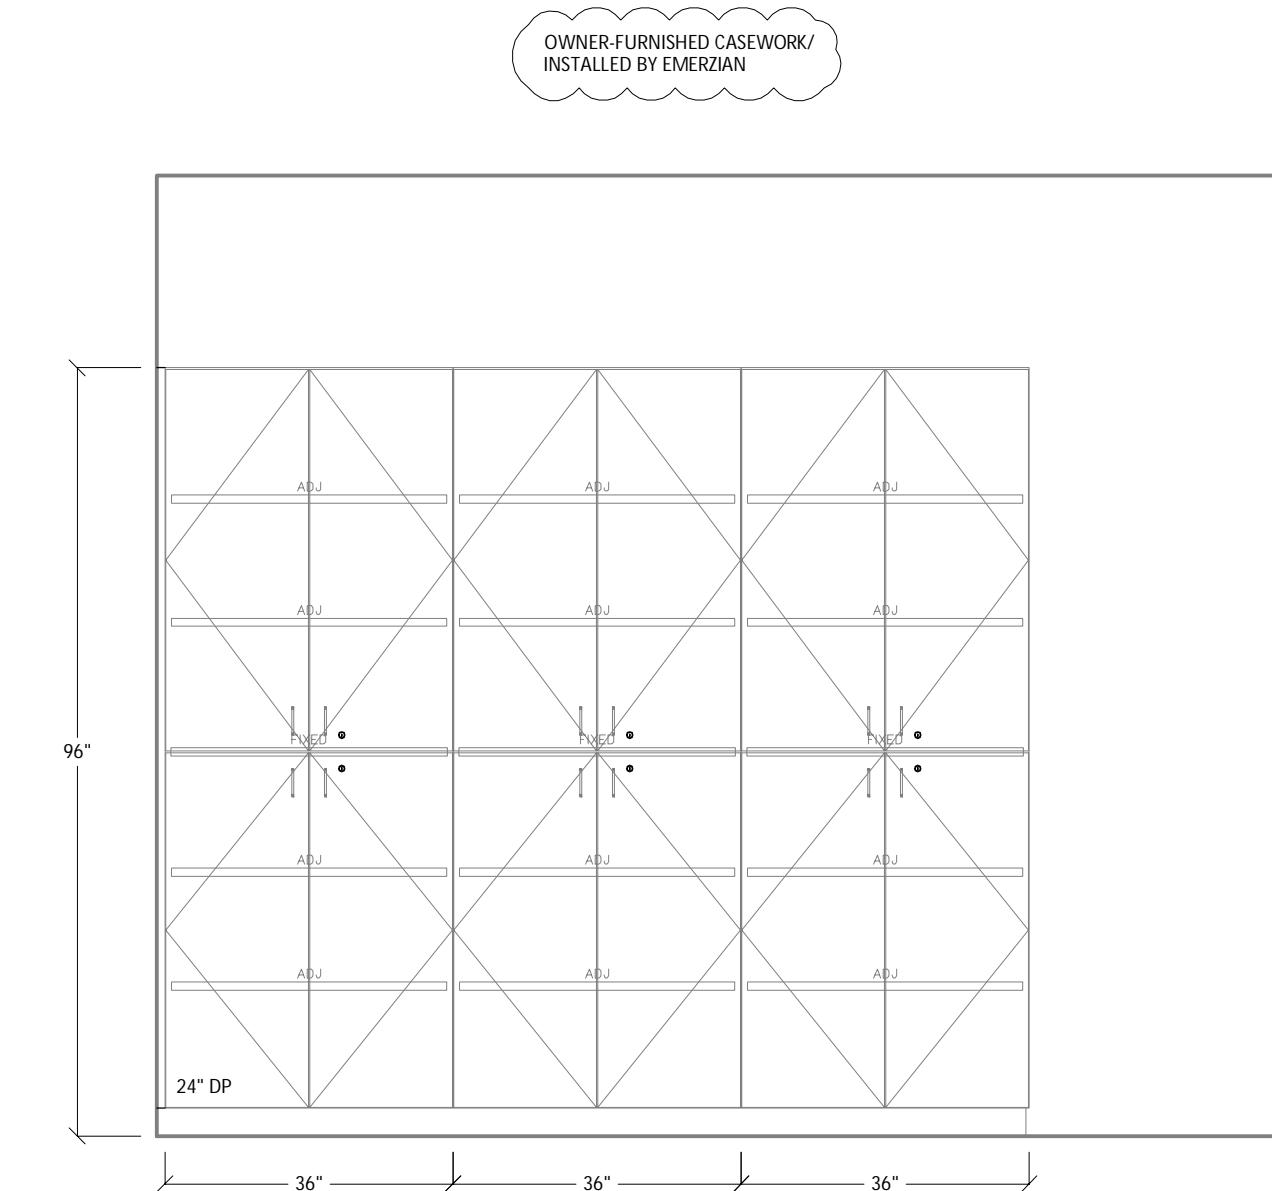

OWNER-FURNISHED CASEWORK/
INSTALLED BY EMERZIAN



22

PLAN: SPED 2 #D03

REF: ARCH. PAGE NO. A/A106

SCALE: $\frac{1}{2}'' = 1'-0''$

22A

PLAN: SPED 2 #D03

REF: ARCH. PAGE NO. D/A601


SCALE: $\frac{1}{2}'' = 1'-0''$

IF SIZE OF SHEET IS NOT 11 X 17, SCALE ACCORDINGLY.

| |
|---|
| EMERZIAN WOODWORKING |
| 2555 N. Argyle, Fresno, California 93727 (559) 292-2448 - FAX (559) 292-3710 |


| | | | |
|---|--|----------------------------------|-----------------------------------|
| PROJECT NAME: CUSD PROFESSIONAL LEARNING CENTER | CONTRACTOR/CLIENT NAME: CLOVIS UNIFIED SCHOOL DISTRICT | SCALE: | DATE: 09/22/17 |
| LOCATION: CLOVIS, CA | ADDRESS: 1450 HERNDON AVE., CLOVIS, CA 93611 | PROJECT NUMBER: 17052 | REVISED: 10/25/17 |
| SUPER PHONE: | PHONE: (559) 327-9000 FAX: | FILE NAME: F:\MV7\EF\FD\17052 | DRAWN BY: AD REVISED BY: AD |
| | | DRAWING NUMBER: 45 | SUBMITTAL SET |

OWNER-FURNISHED CASEWORK/
INSTALLED BY EMERZIAN

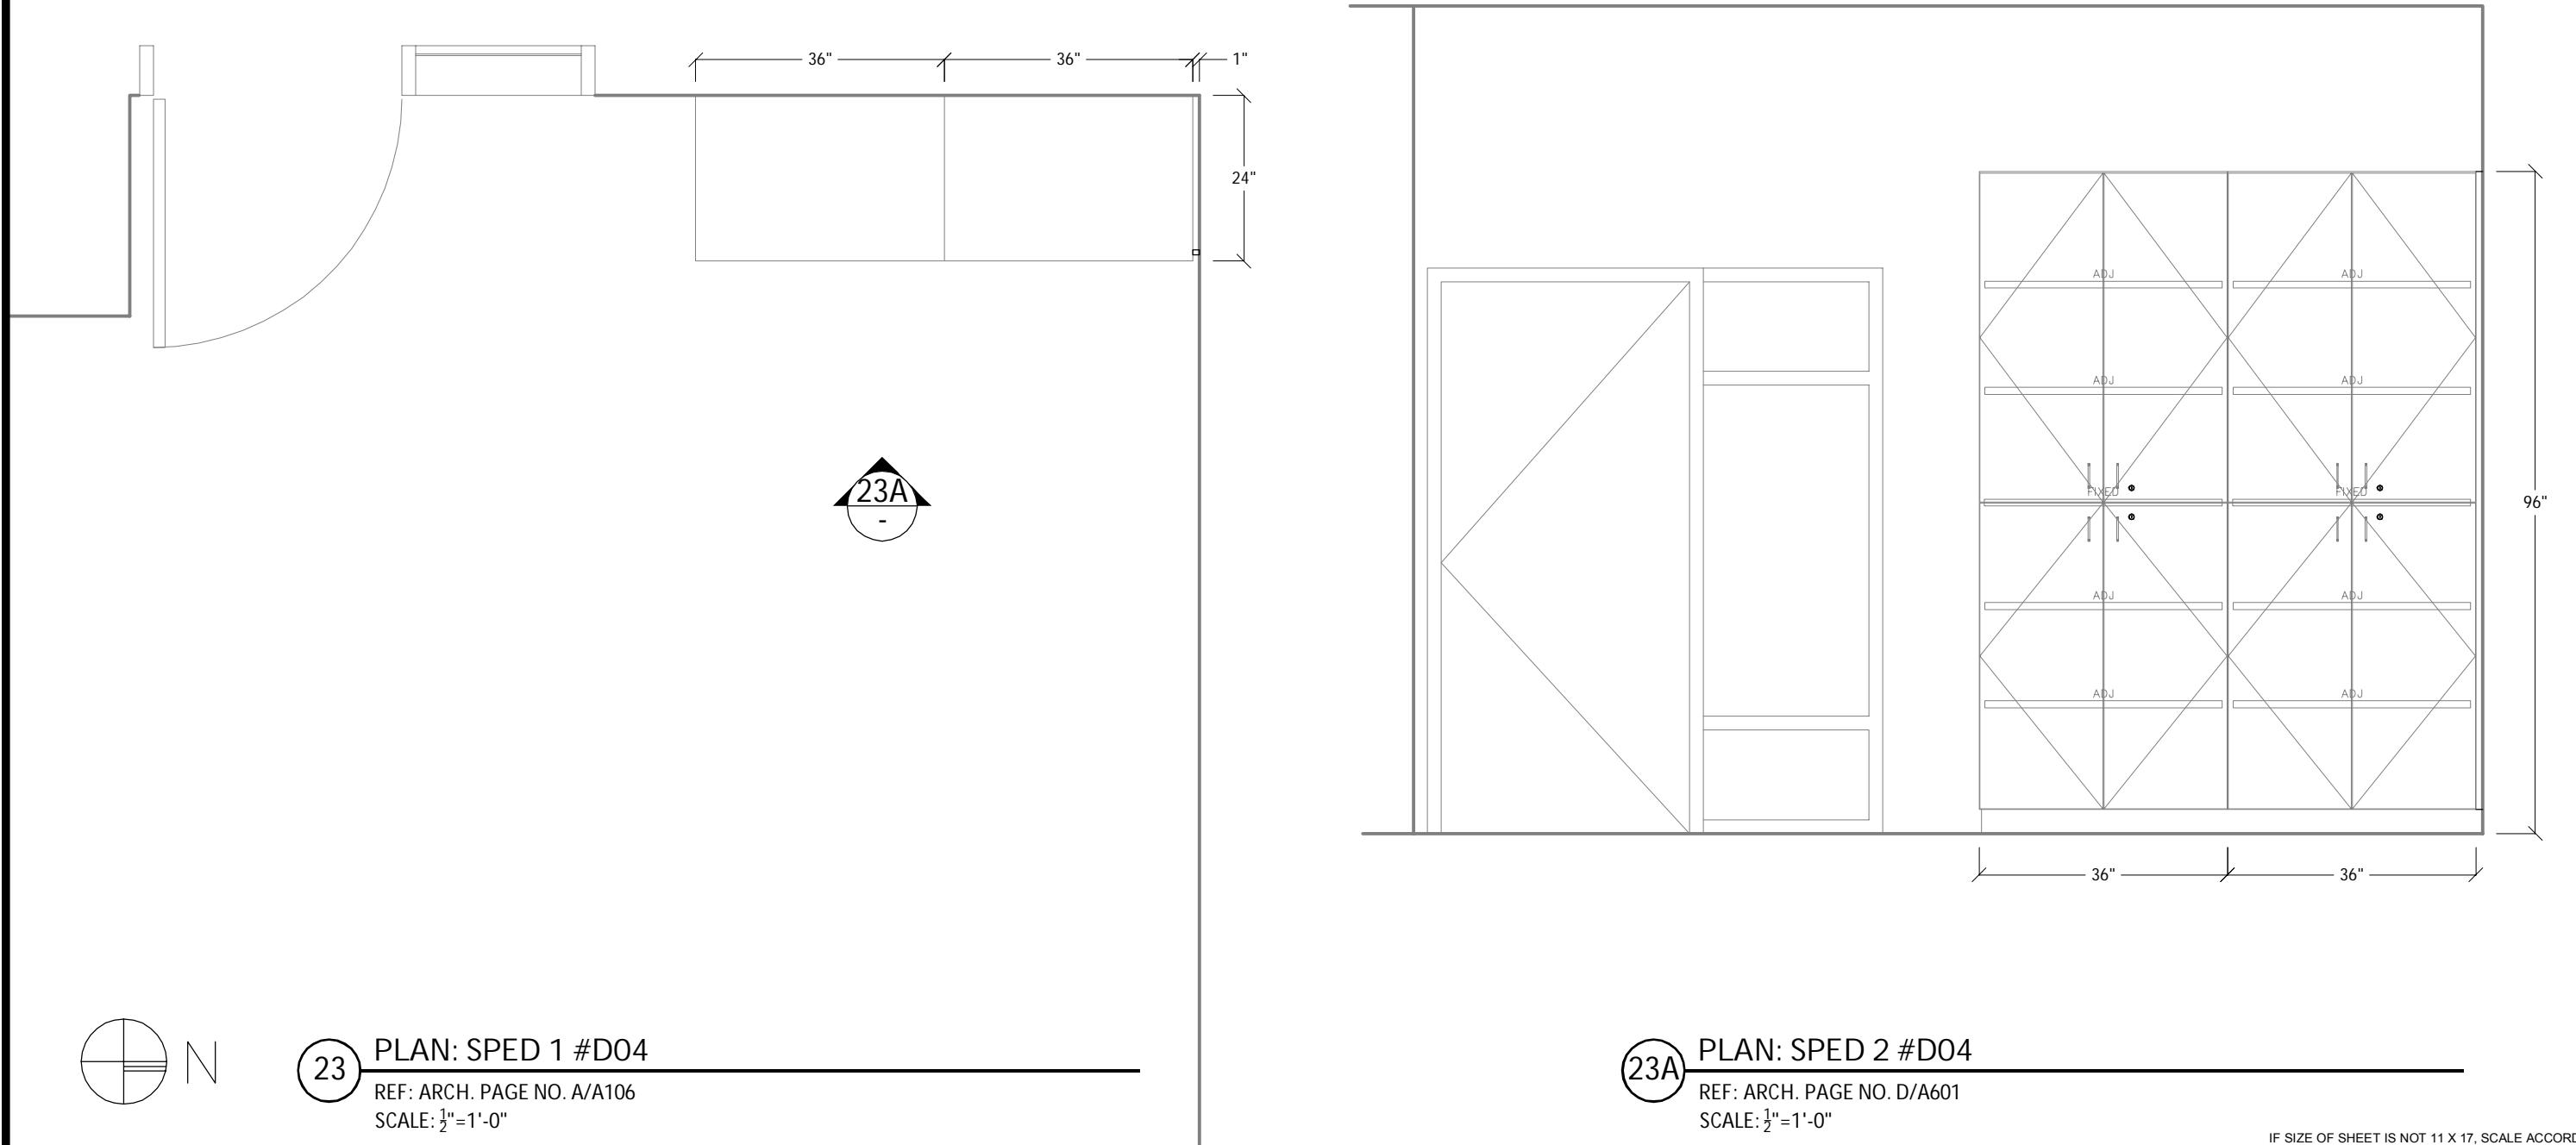

| |
|---|
| EMERZIAN WOODWORKING |
| 2555 N. Argyle, Fresno, California 93727 (559) 292-2448 - FAX (559) 292-3710 |

| | | | |
|--|---|---|--|
| PROJECT NAME: CUSD PROFESSIONAL LEARNING CENTER | CONTRACTOR/CLIENT NAME: CLOVIS UNIFIED SCHOOL DISTRICT | SCALE: PROJECT NUMBER: 17052 | DATE: REVISED: 09/22/17 |
| LOCATION: CLOVIS, CA | ADDRESS: 1450 HERNDON AVE., CLOVIS, CA 93611 | FILE NAME: F:\MV7\EF\FD\17052 | DRAWN BY: REVISED BY: AD AD |
| SUPER PHONE: | PHONE: (559) 327-9000 FAX: | DRAWING NUMBER: 46 | SUBMITTAL SET |

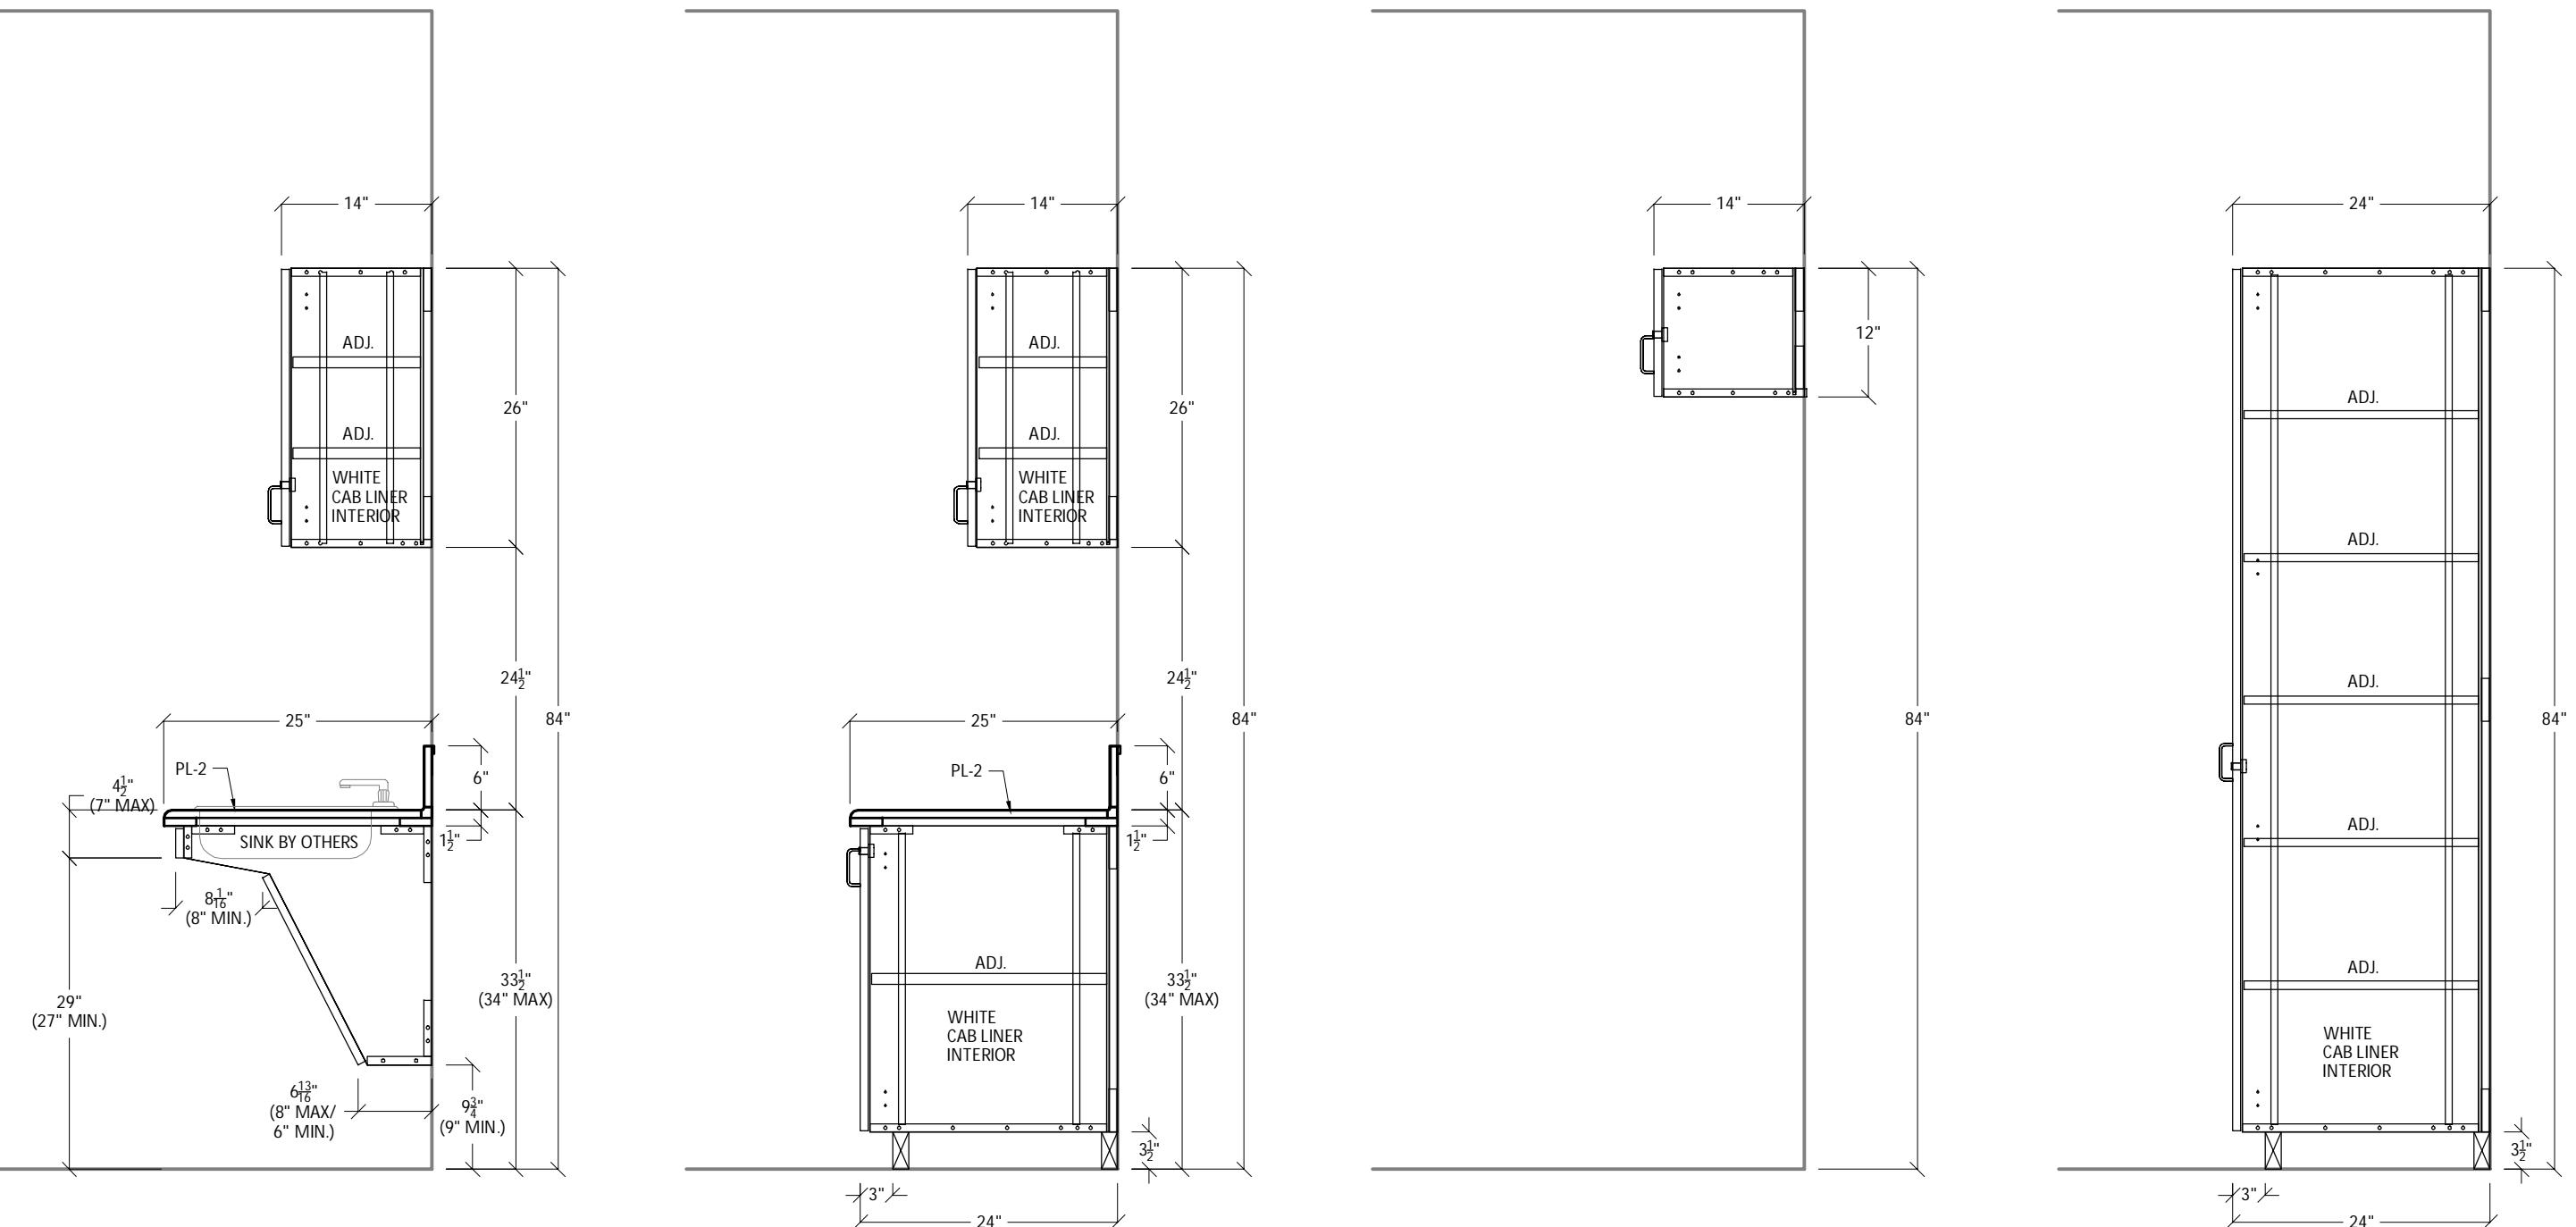

A SECTION

SCALE: $\frac{3}{8}$ "=1'-0"
ARCHITECT REF PAGE NO:

B SECTION


SCALE: $\frac{3}{8}$ "=1'-0"
ARCHITECT REF PAGE NO:

C SECTION

SCALE: $\frac{3}{8}$ "=1'-0"
ARCHITECT REF PAGE NO:

D SECTION

SCALE: $\frac{3}{8}$ "=1'-0"
ARCHITECT REF PAGE NO:
IF SIZE OF SHEET IS NOT 11 X 17, SCALE ACCORDINGLY.

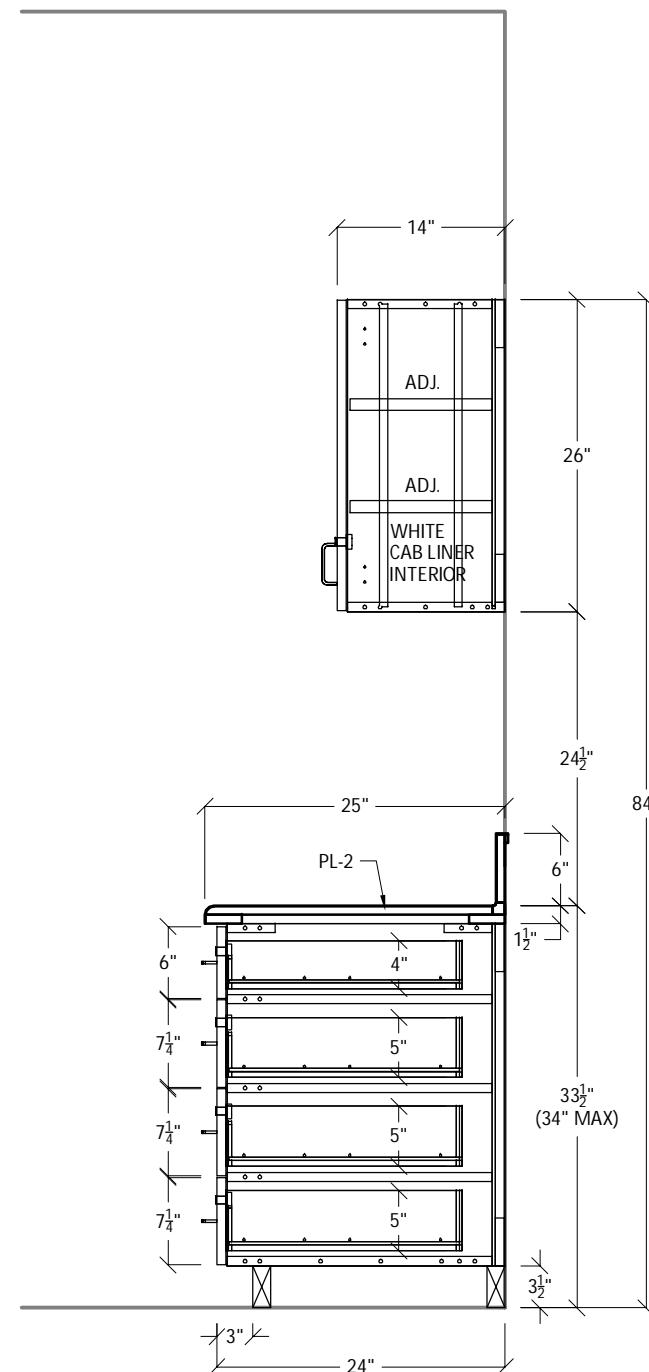


A SECTION

SCALE: $\frac{3}{4}$ "=1'-0"
ARCHITECT REF PAGE NO:


B SECTION

SCALE: $\frac{3}{4}$ "=1'-0"
ARCHITECT REF PAGE NO:

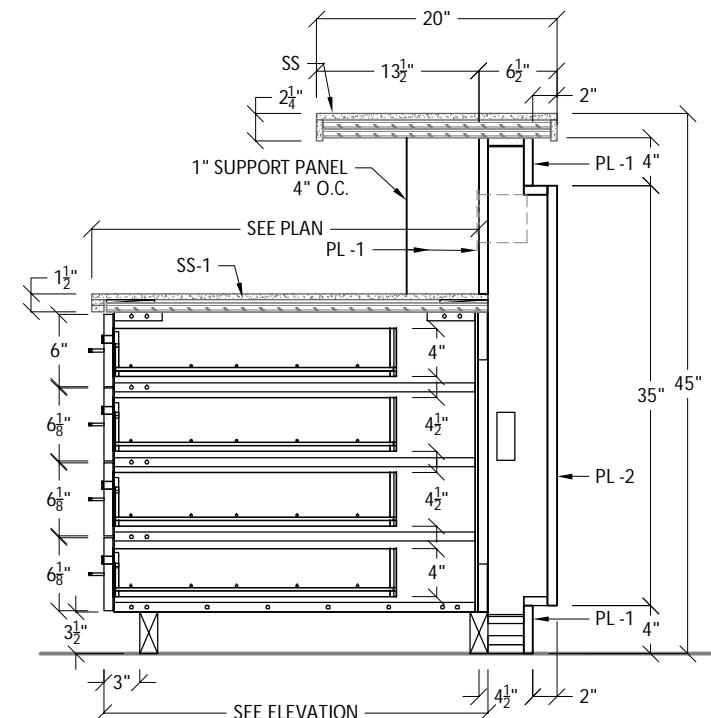


C SECTION

SCALE: $\frac{3}{4}$ "=1'-0"
ARCHITECT REF PAGE NO:

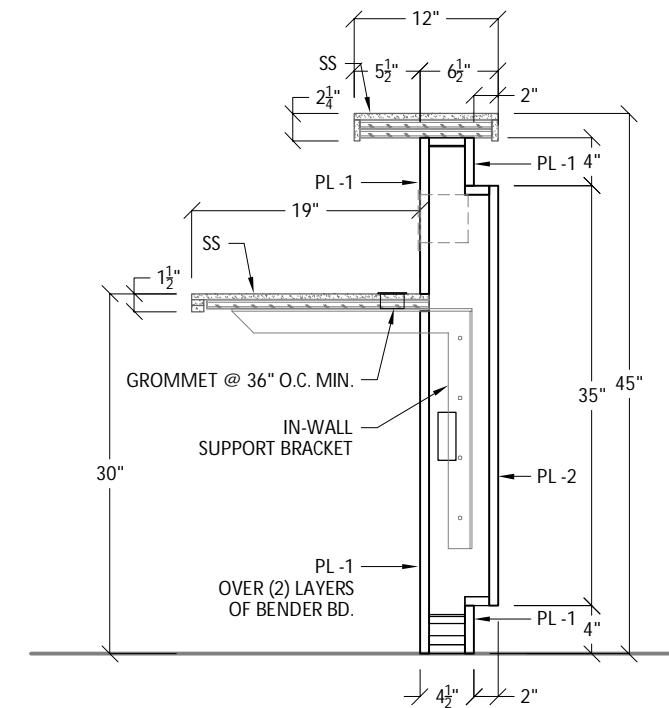


D SECTION

SCALE: $\frac{3}{4}$ "=1'-0"
ARCHITECT REF PAGE NO:
IF SIZE OF SHEET IS NOT 11 X 17, SCALE ACCORDINGLY.

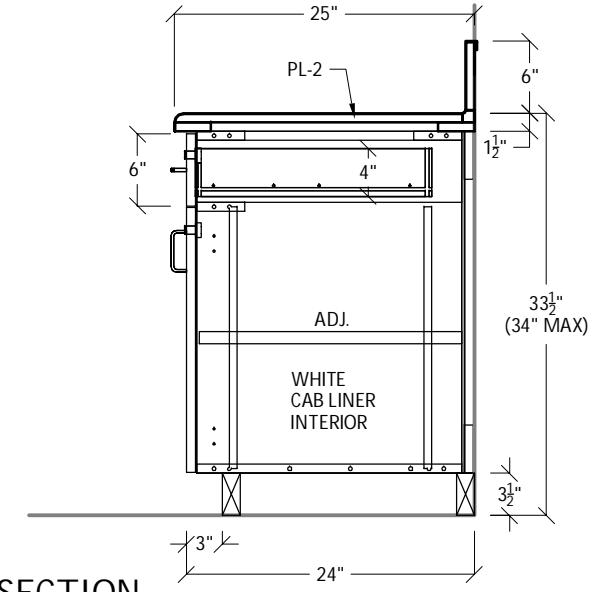

E SECTION

SCALE: $\frac{3}{4}$ "=1'-0"
ARCHITECT REF PAGE NO:

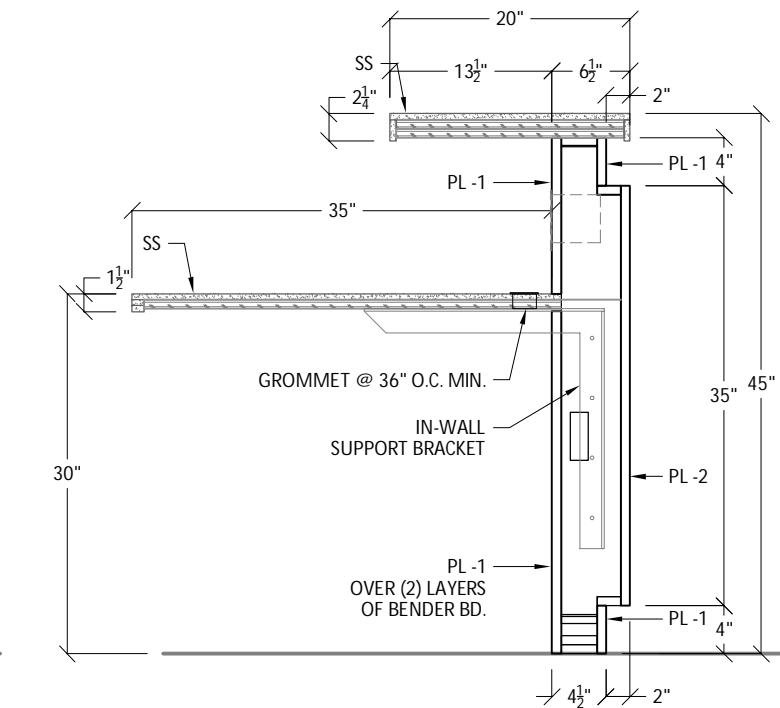

2555 N. Argyle, Fresno, California 93727
(559) 292-2448 - FAX (559) 292-3710

PROJECT
NAME:
CUSD PROFESSIONAL LEARNING CENTER

LOCATION:
CLOVIS, CA

SUPER PHONE:

CONTRACTOR/CLIENT
NAME:
CLOVIS UNIFIED SCHOOL DISTRICT

ADDRESS:
1450 HERNDON AVE., CLOVIS, CA 93611

PHONE: (559) 327-9000 FAX:

SCALE:
PROJECT NUMBER: 17052


FILE NAME: F:\MV7\EF\FD\17052


DRAWING NUMBER: S2

DATE: 09/22/17
REVISED: 10/25/17


DRAWN BY: AD REVISED BY: AD

SUBMITTAL SET

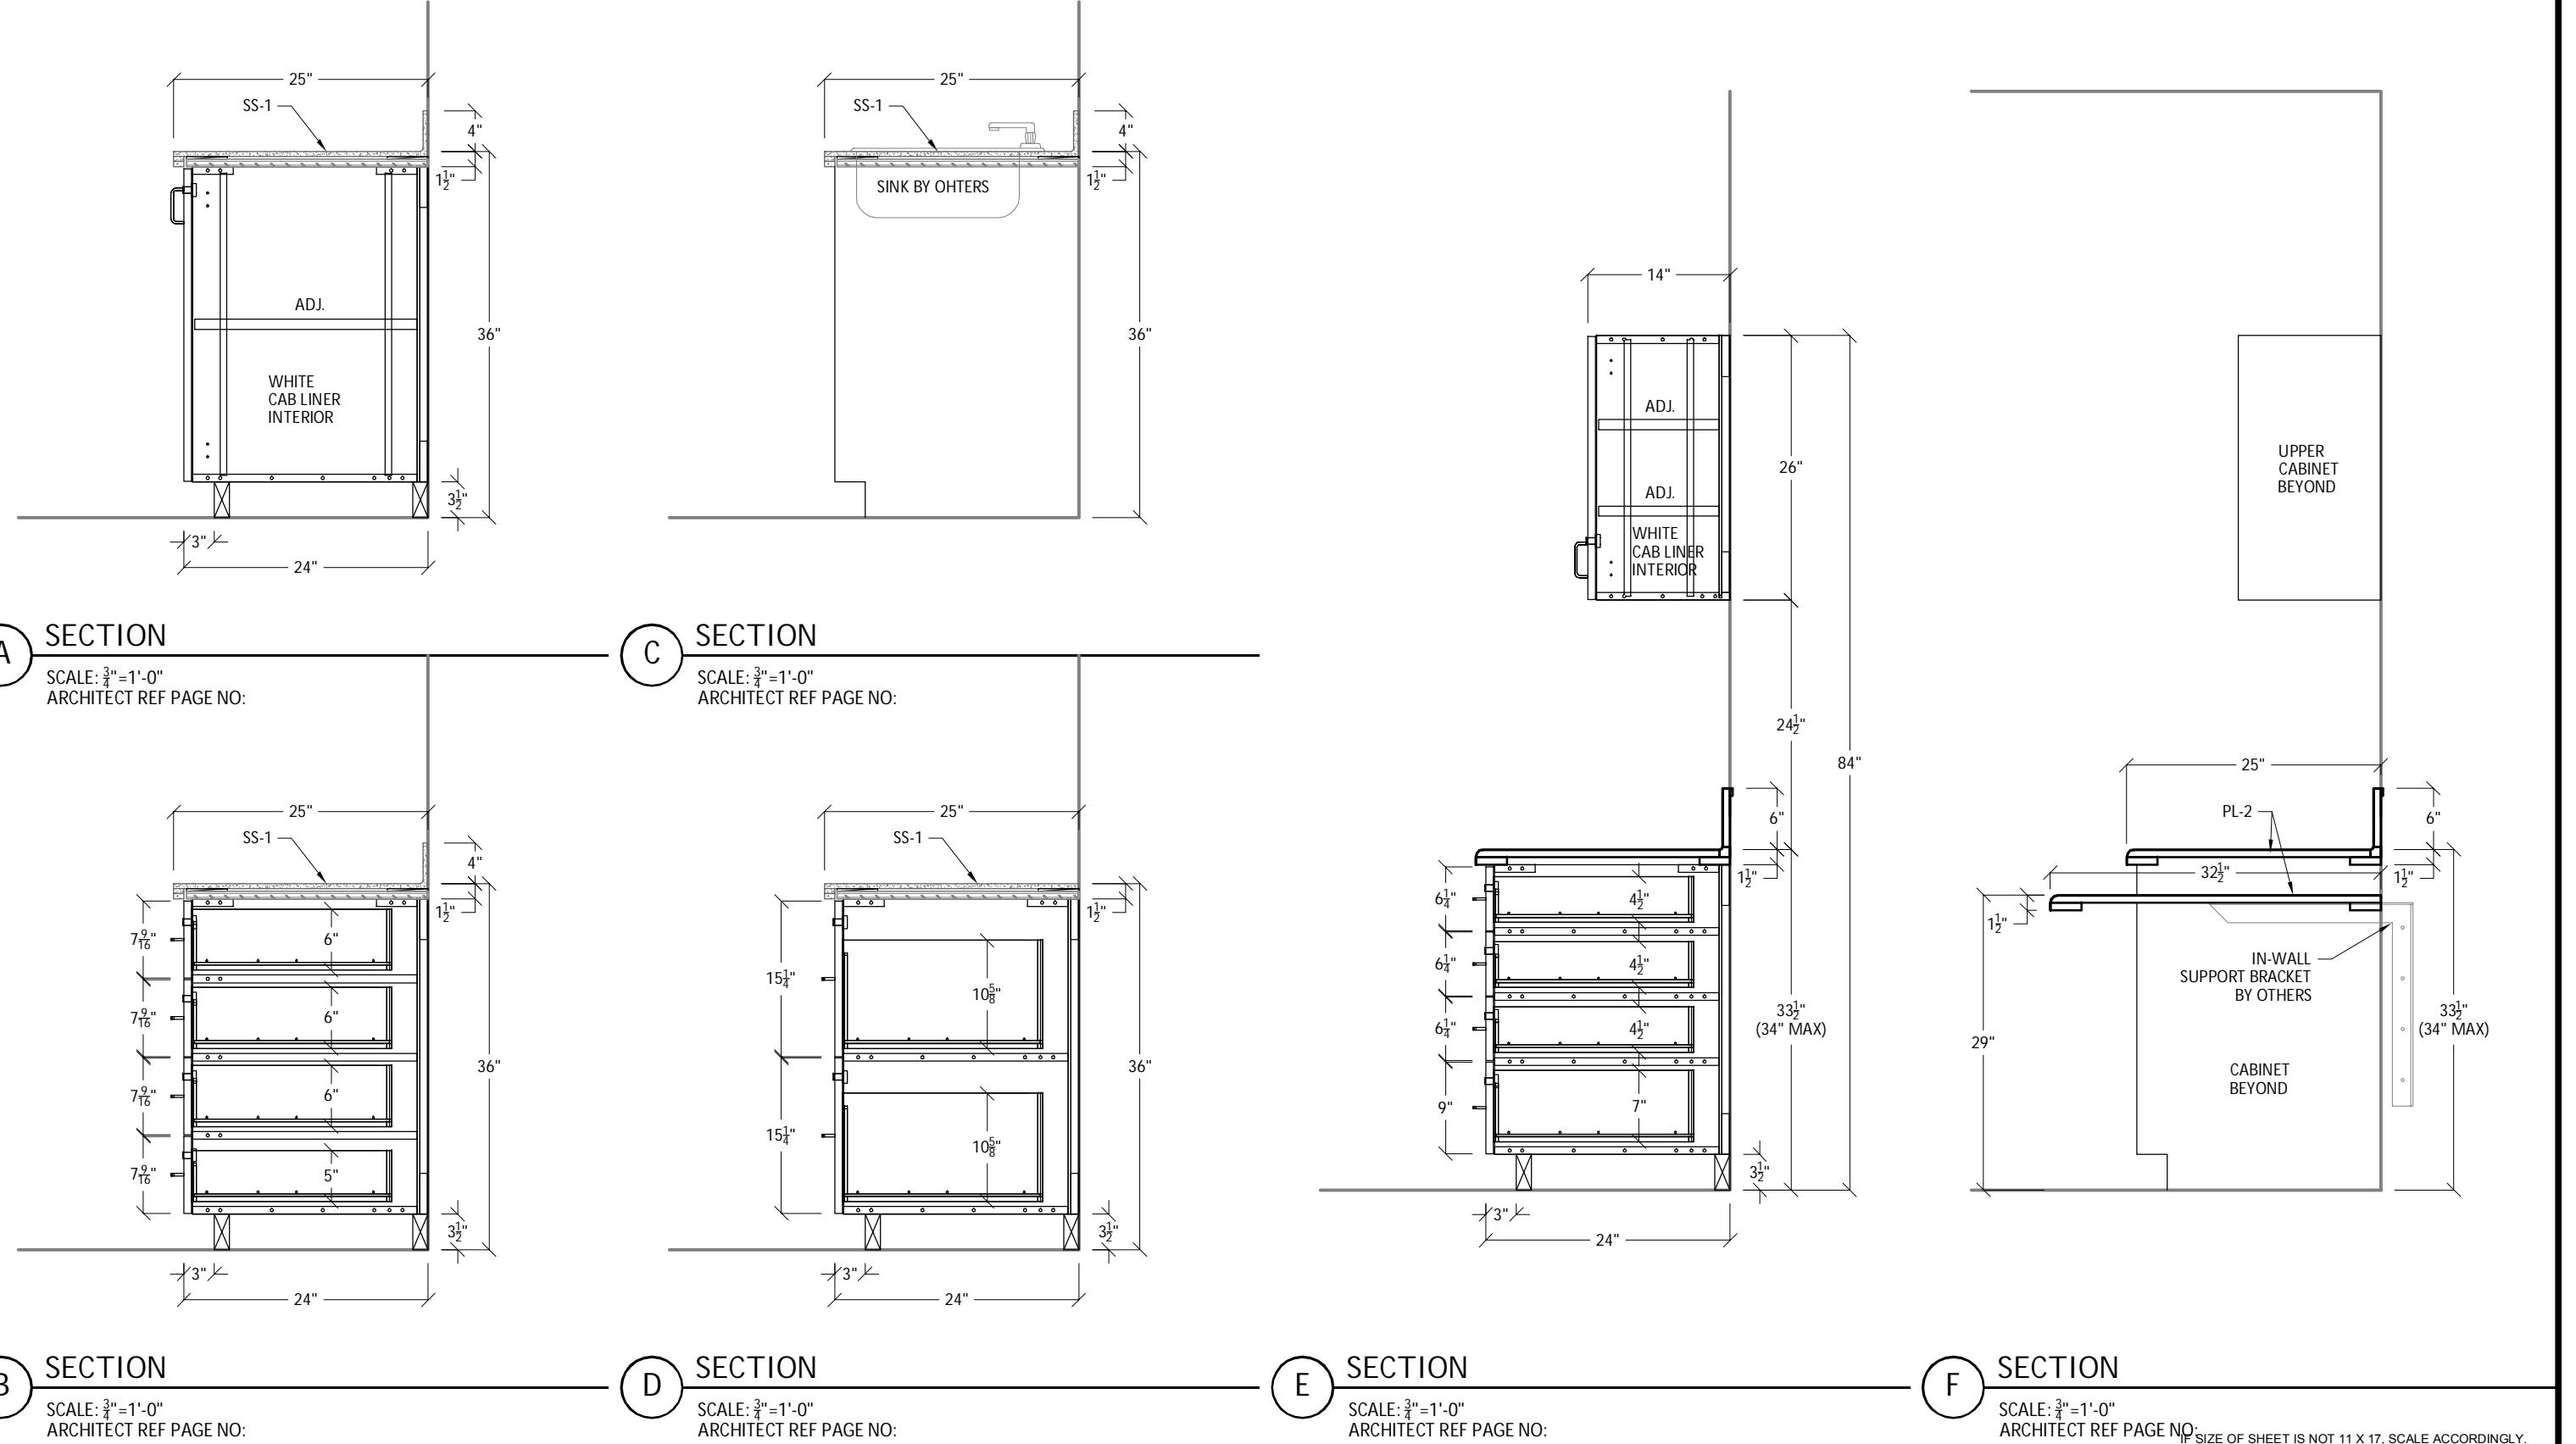


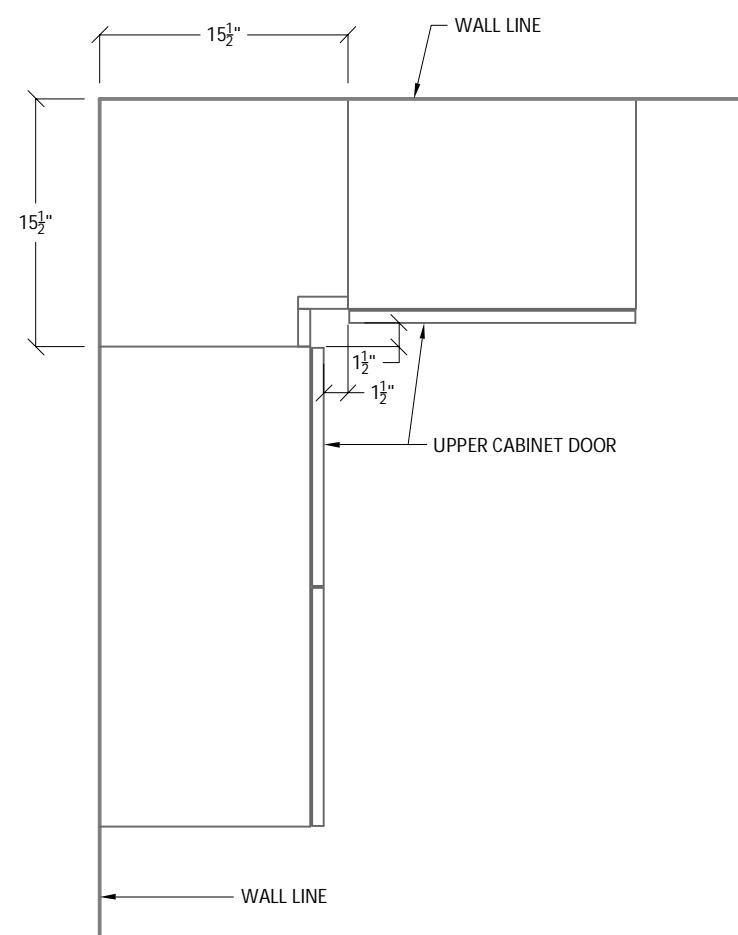


A PLAN SECTION @ UPPER CORNER SCRIBE
SCALE: 1"=1'-0"

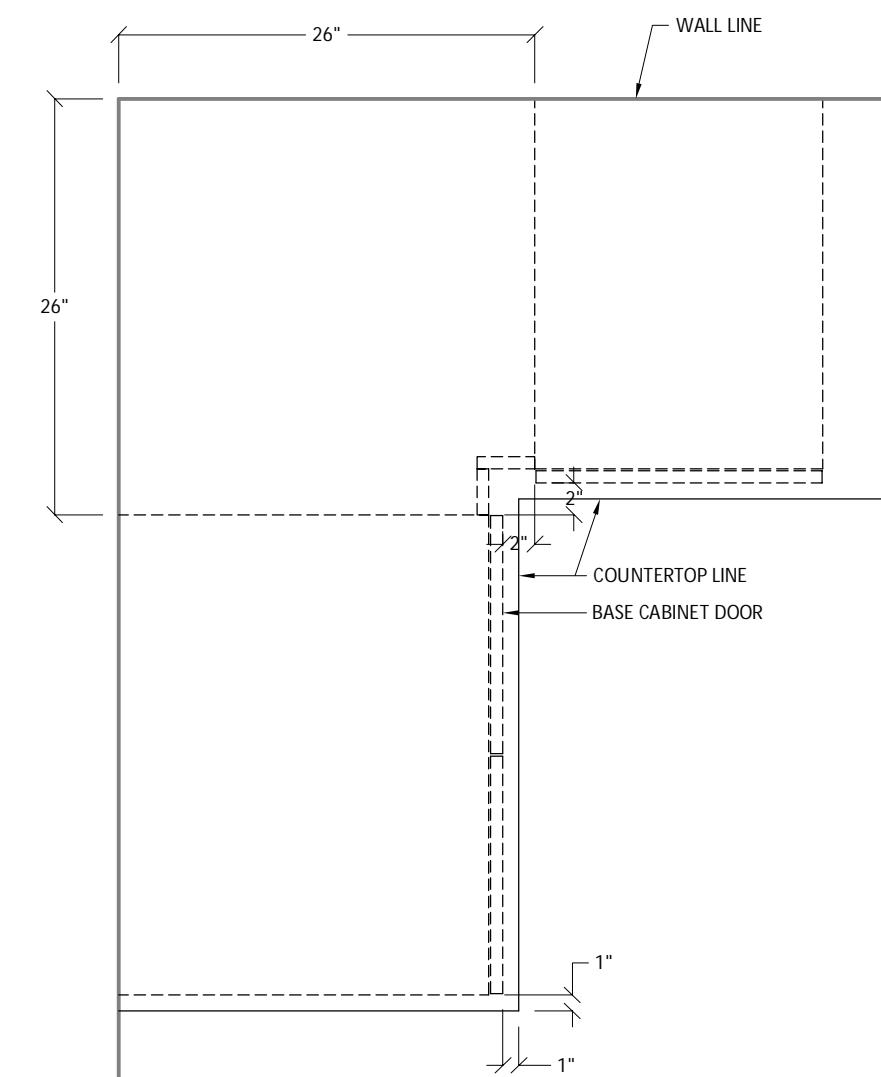

B PLAN SECTION @ UPPER CORNER SCRIBE
SCALE: 1"=1'-0"

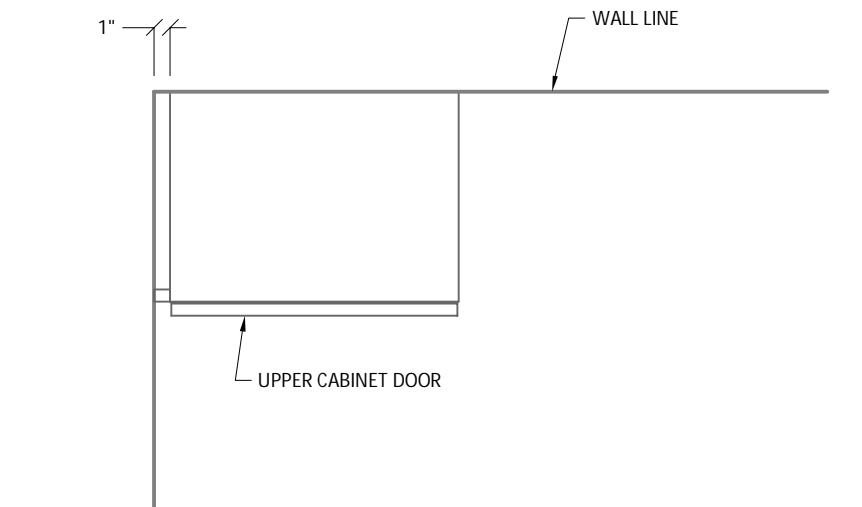

C PLAN SECTION @ UPPER TO WALL SCRIBE
SCALE: 1"=1'-0"

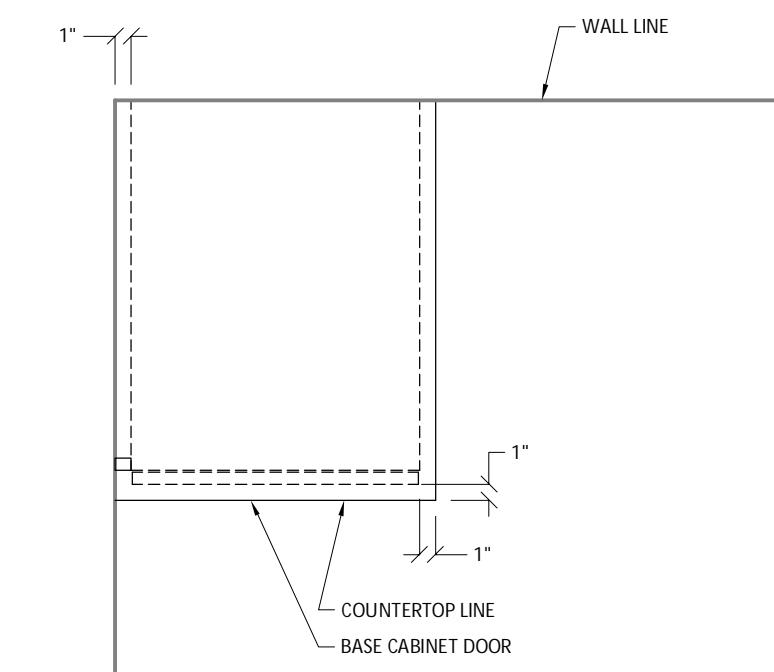

D PLAN SECTION @ BASE TO WALL SCRIBE
SCALE: 1"=1'-0"

IF SIZE OF SHEET IS NOT 11 X 17, SCALE ACCORDINGLY.


| |
|---|
| EVERLAST WOODWORKING |
| 2555 N. Argyle, Fresno, California 93727 (559) 292-2448 - FAX (559) 292-3710 |

| | | | |
|--|---|---|---------------------------------------|
| PROJECT NAME: CUSD PROFESSIONAL LEARNING CENTER | CONTRACTOR/CLIENT NAME: CLOVIS UNIFIED SCHOOL DISTRICT | SCALE: PROJECT NUMBER: 17052 | DATE: REVISED: |
| LOCATION: CLOVIS, CA | ADDRESS: 1450 HERNDON AVE., CLOVIS, CA 93611 | FILE NAME: F:\MV7\EF\FD\17052 | DRAWN BY: REVISED BY: AD |


SUPER PHONE: PHONE: (559) 327-9000 FAX:

DRAWING NUMBER: D1


SUBMITTAL SET

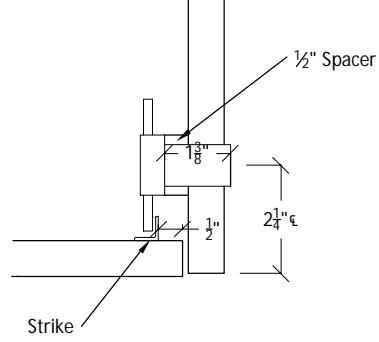


L1 UPPER DOOR LOCKS, TYP.

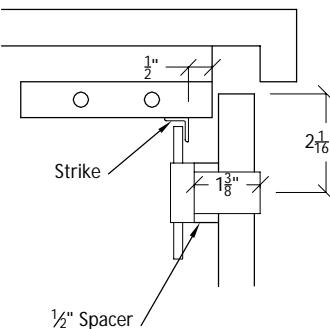

L2 LOWER DOOR LOCKS, TYP.

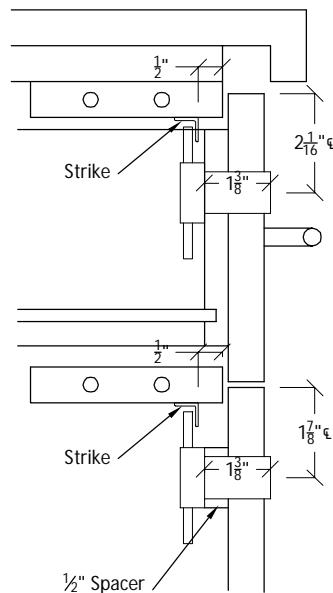

L3 DOOR/DRAWER LOCKS, TYP.

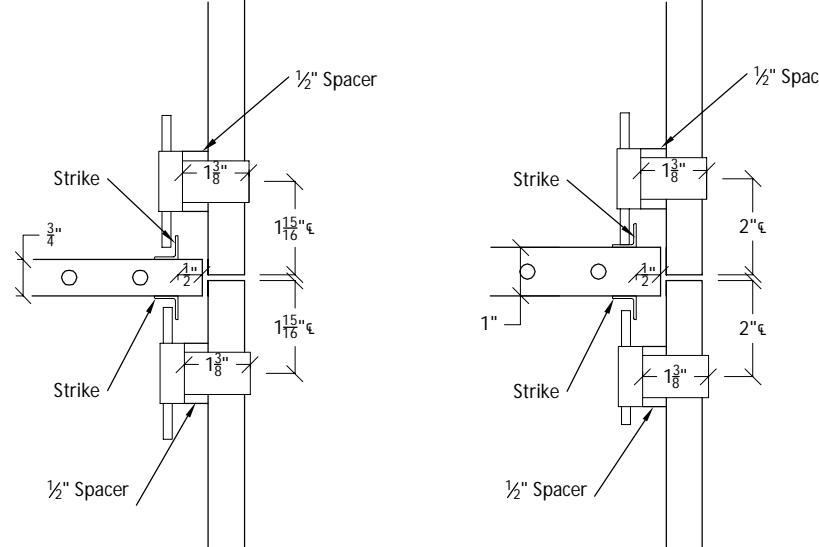

L4 TALL DOOR LOCKS, TYP.

